


Sec. 31

6

365
Tp. 37S

R6W

W.M.

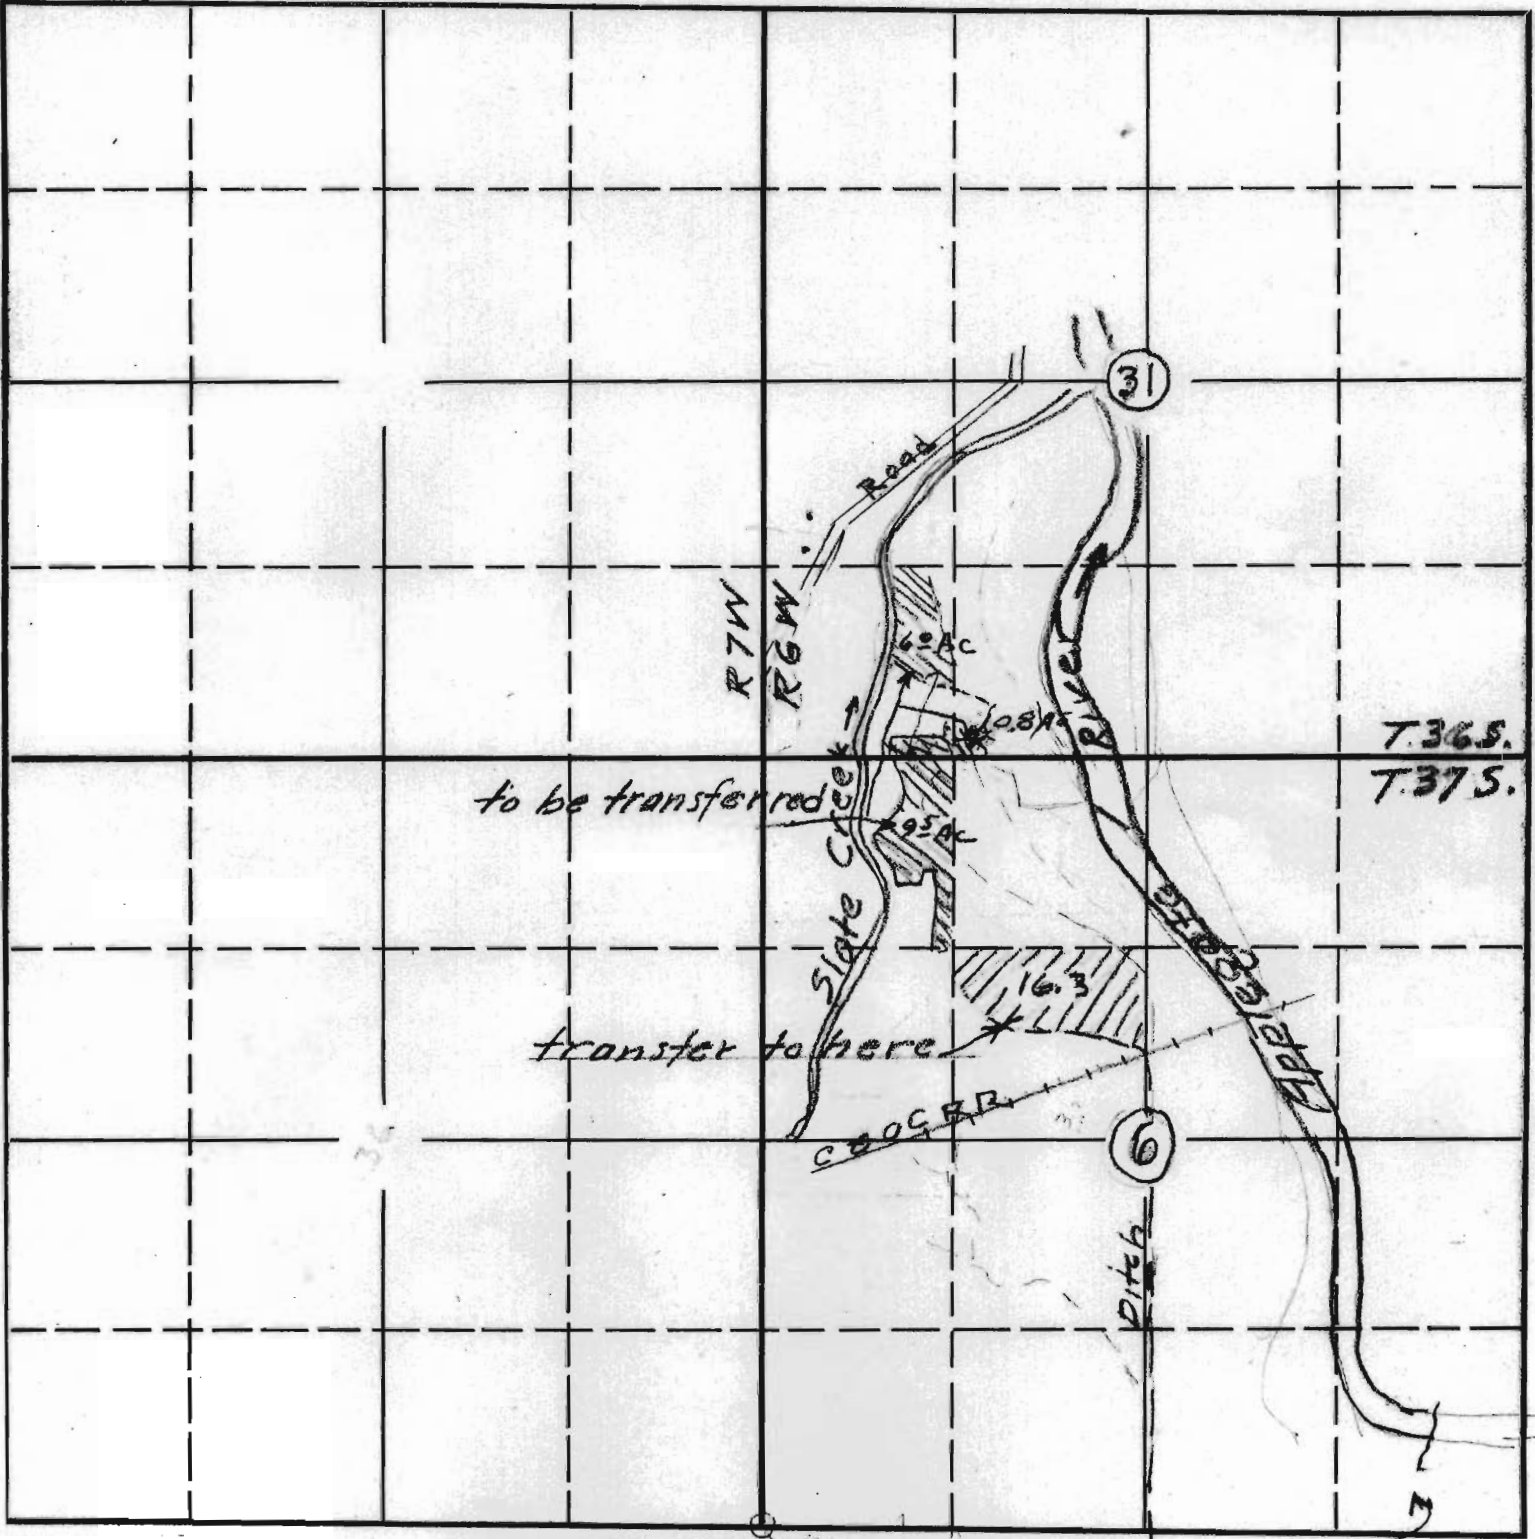

T. 36S.
T. 37S.

RECEIVED
NOV 1 1944
STATE ENGINEER
SALEM, OREGON

4952
NW 1/4
S 1/2
215
37.6

DIVERSION IS.
800' South and
1000' East of
West 1/4 Cor. Sec. 15, T. 37S R. 6W. W.M.