


North

Blazed
boundary

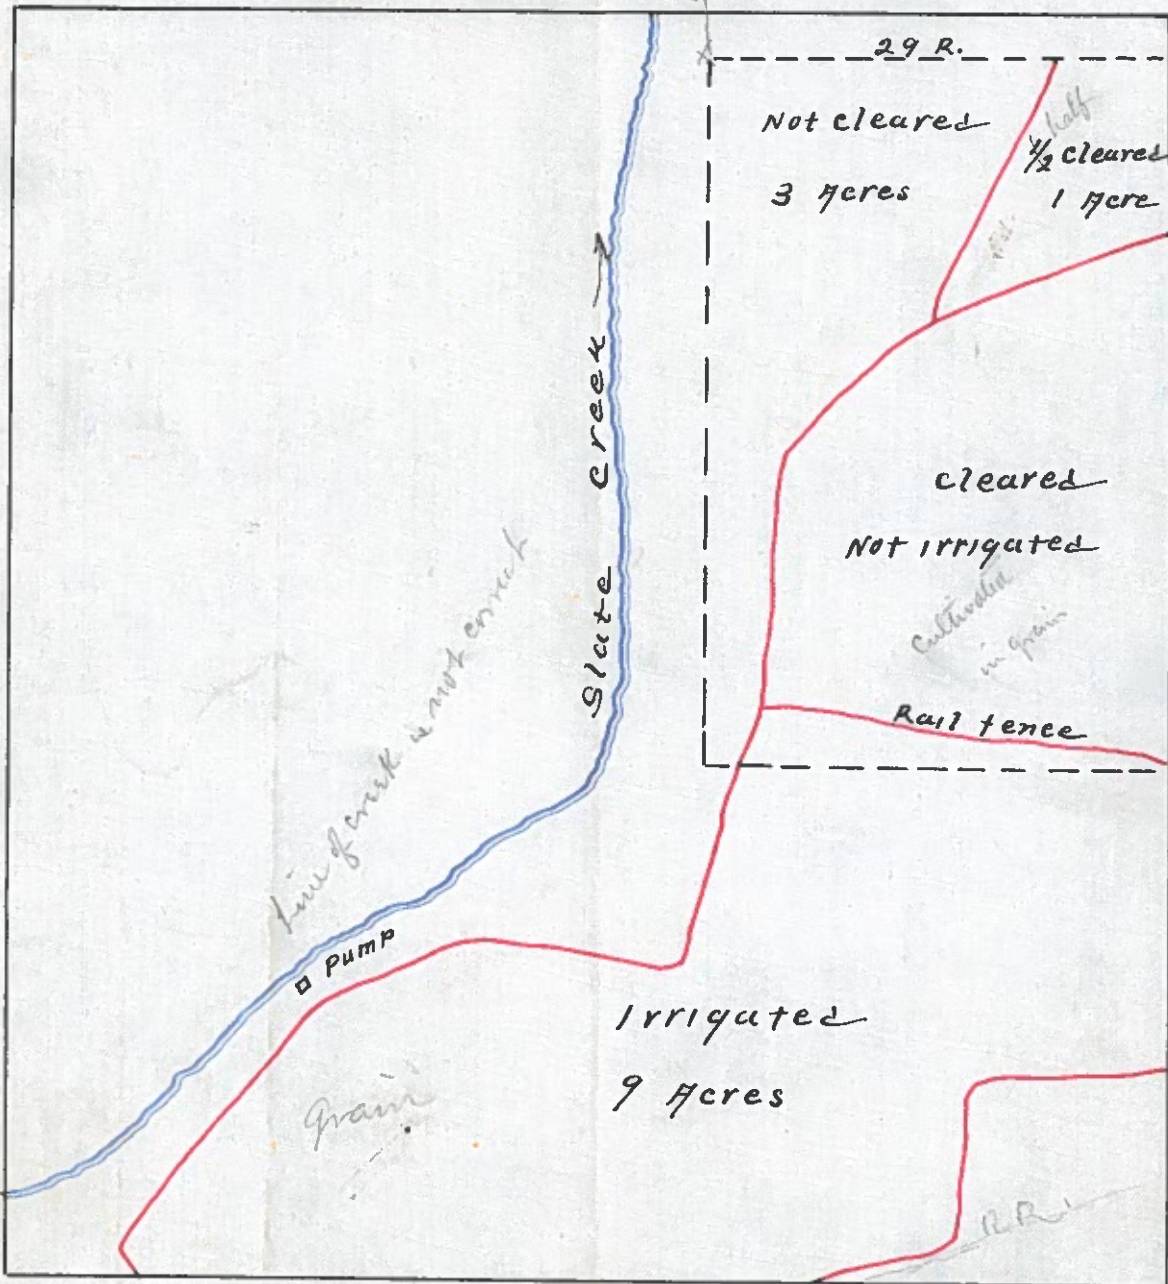

Not cleared

3 acres

1/2 cleared
1 acre

cleared
Not irrigated

Cultivated
in grain

Rail fence

Irrigated

9 acres

line of creek is not correct

Pump

Grain

RR

S.W. 1/4 N.W. 1/4 Sec. 6. T. 37 S. R. 6 W