


— MAP —

Accompanying application of MEDFORD. C. PITTMAN
of Eagle Point, Jackson County, Oregon. for permit to
the waters of Spring tributary to McNeil Creek
Jackson County, Oregon. for Domestic purposes.

— October 1928. —

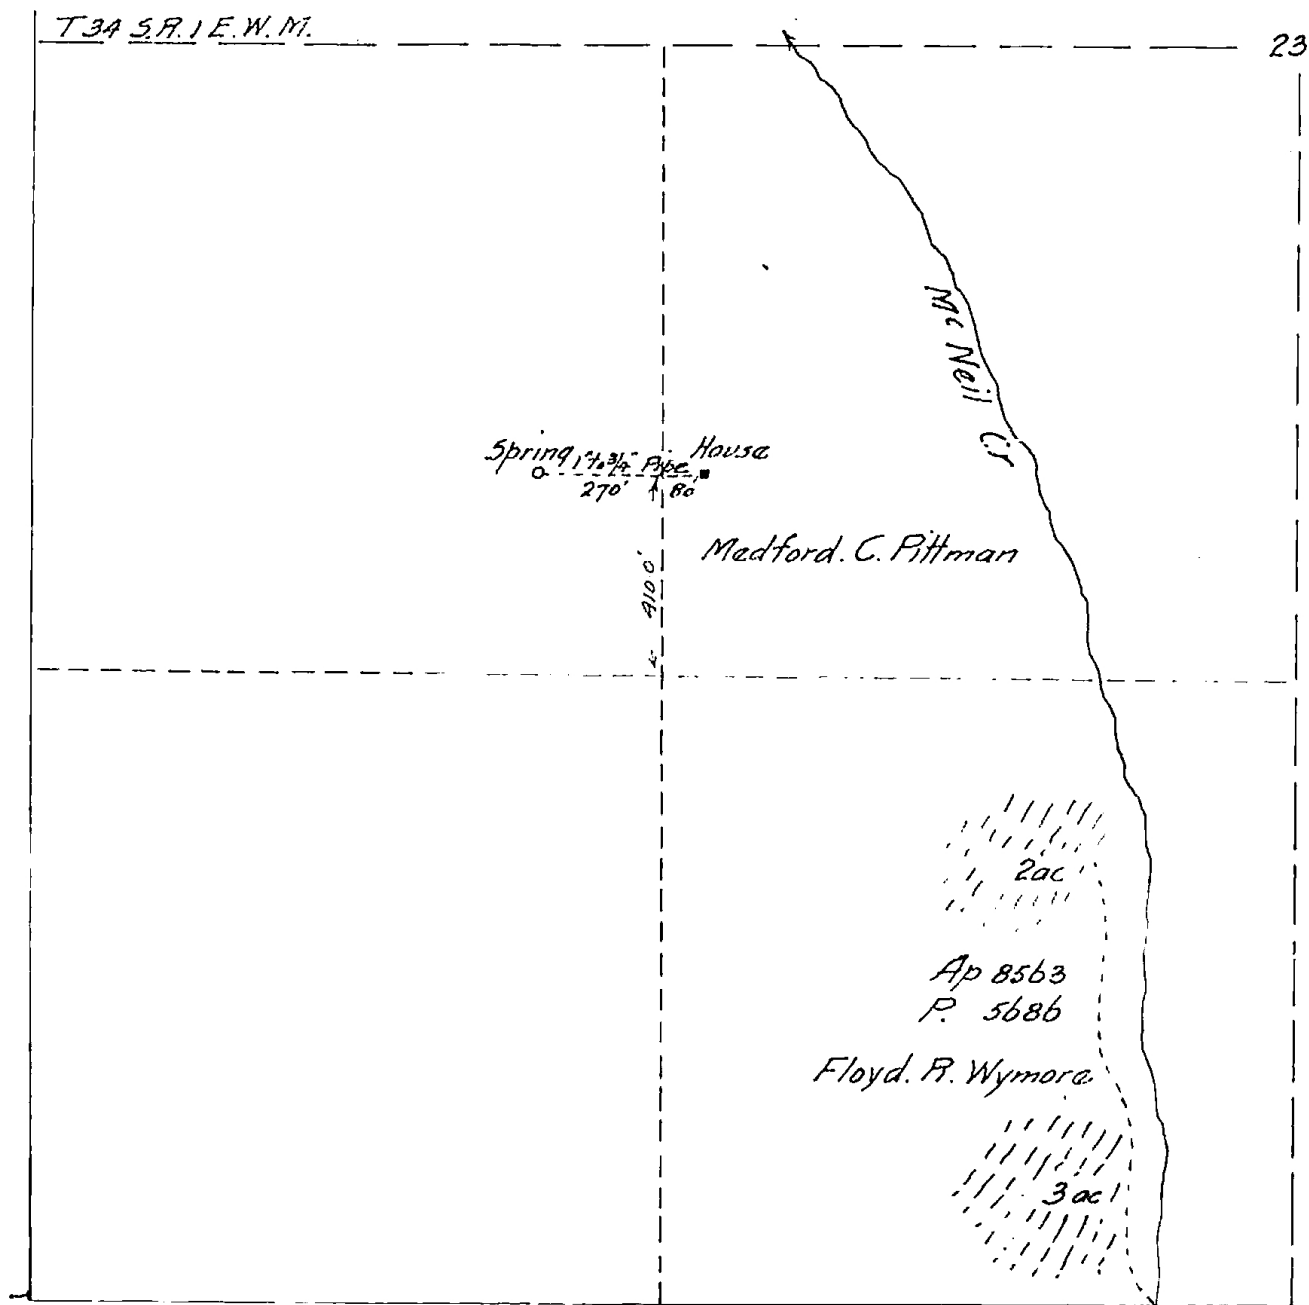

Map made from measurements made by Mr Pittman showing
location of Spring, place of use, together with Streams
and Ditches in immediate vicinity. compiled by.

— Fred. N. Cummings. C.E. —