


SECTION

TOWNSHIP 225, RANGE 10 W, W. M.

North

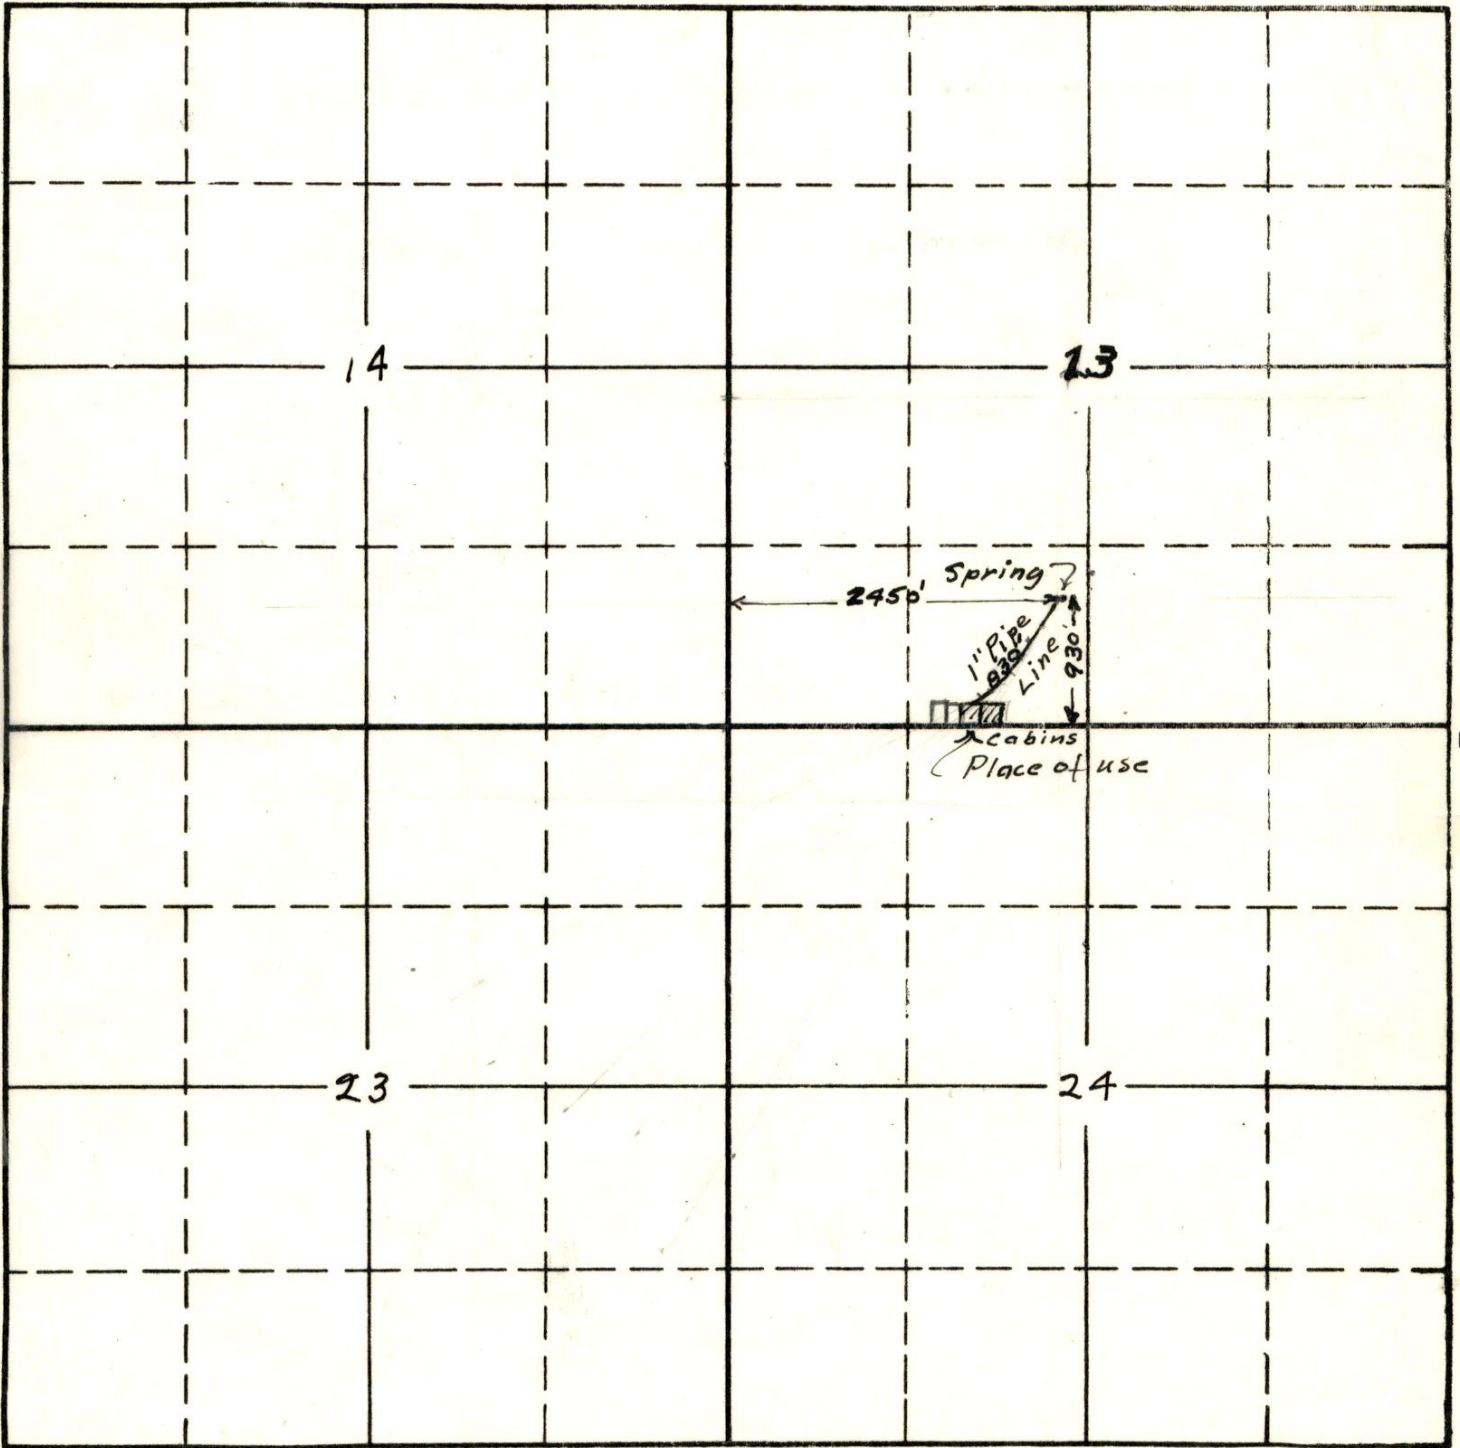

South

West

East

RECEIVED
SEP 9 1936
STATE ENGINEER
SALEM, OREGON

APPLICATION No. 16565
PERMIT No. 12349