

This map was prepared for assessment purpose only.

SECTION 4 T.3S. R.7E. W.M.

CLACKAMAS COUNTY

1" = 400'

3 7E 4
& INDEX

CANCELLED NOS.

TL	501	329	204
	203	324	200
	502	318	201
	191	315	301
	104	100	302
	105	101	303
	270	102	304
	190	103	305
	202		306

33


MAP 2 7E 33C

SEE MAP 2 7E 33DC

SEE MAP 2 7E 33D

34

321
322
323
325
326
327
328
300
331
332
333
335
330
990

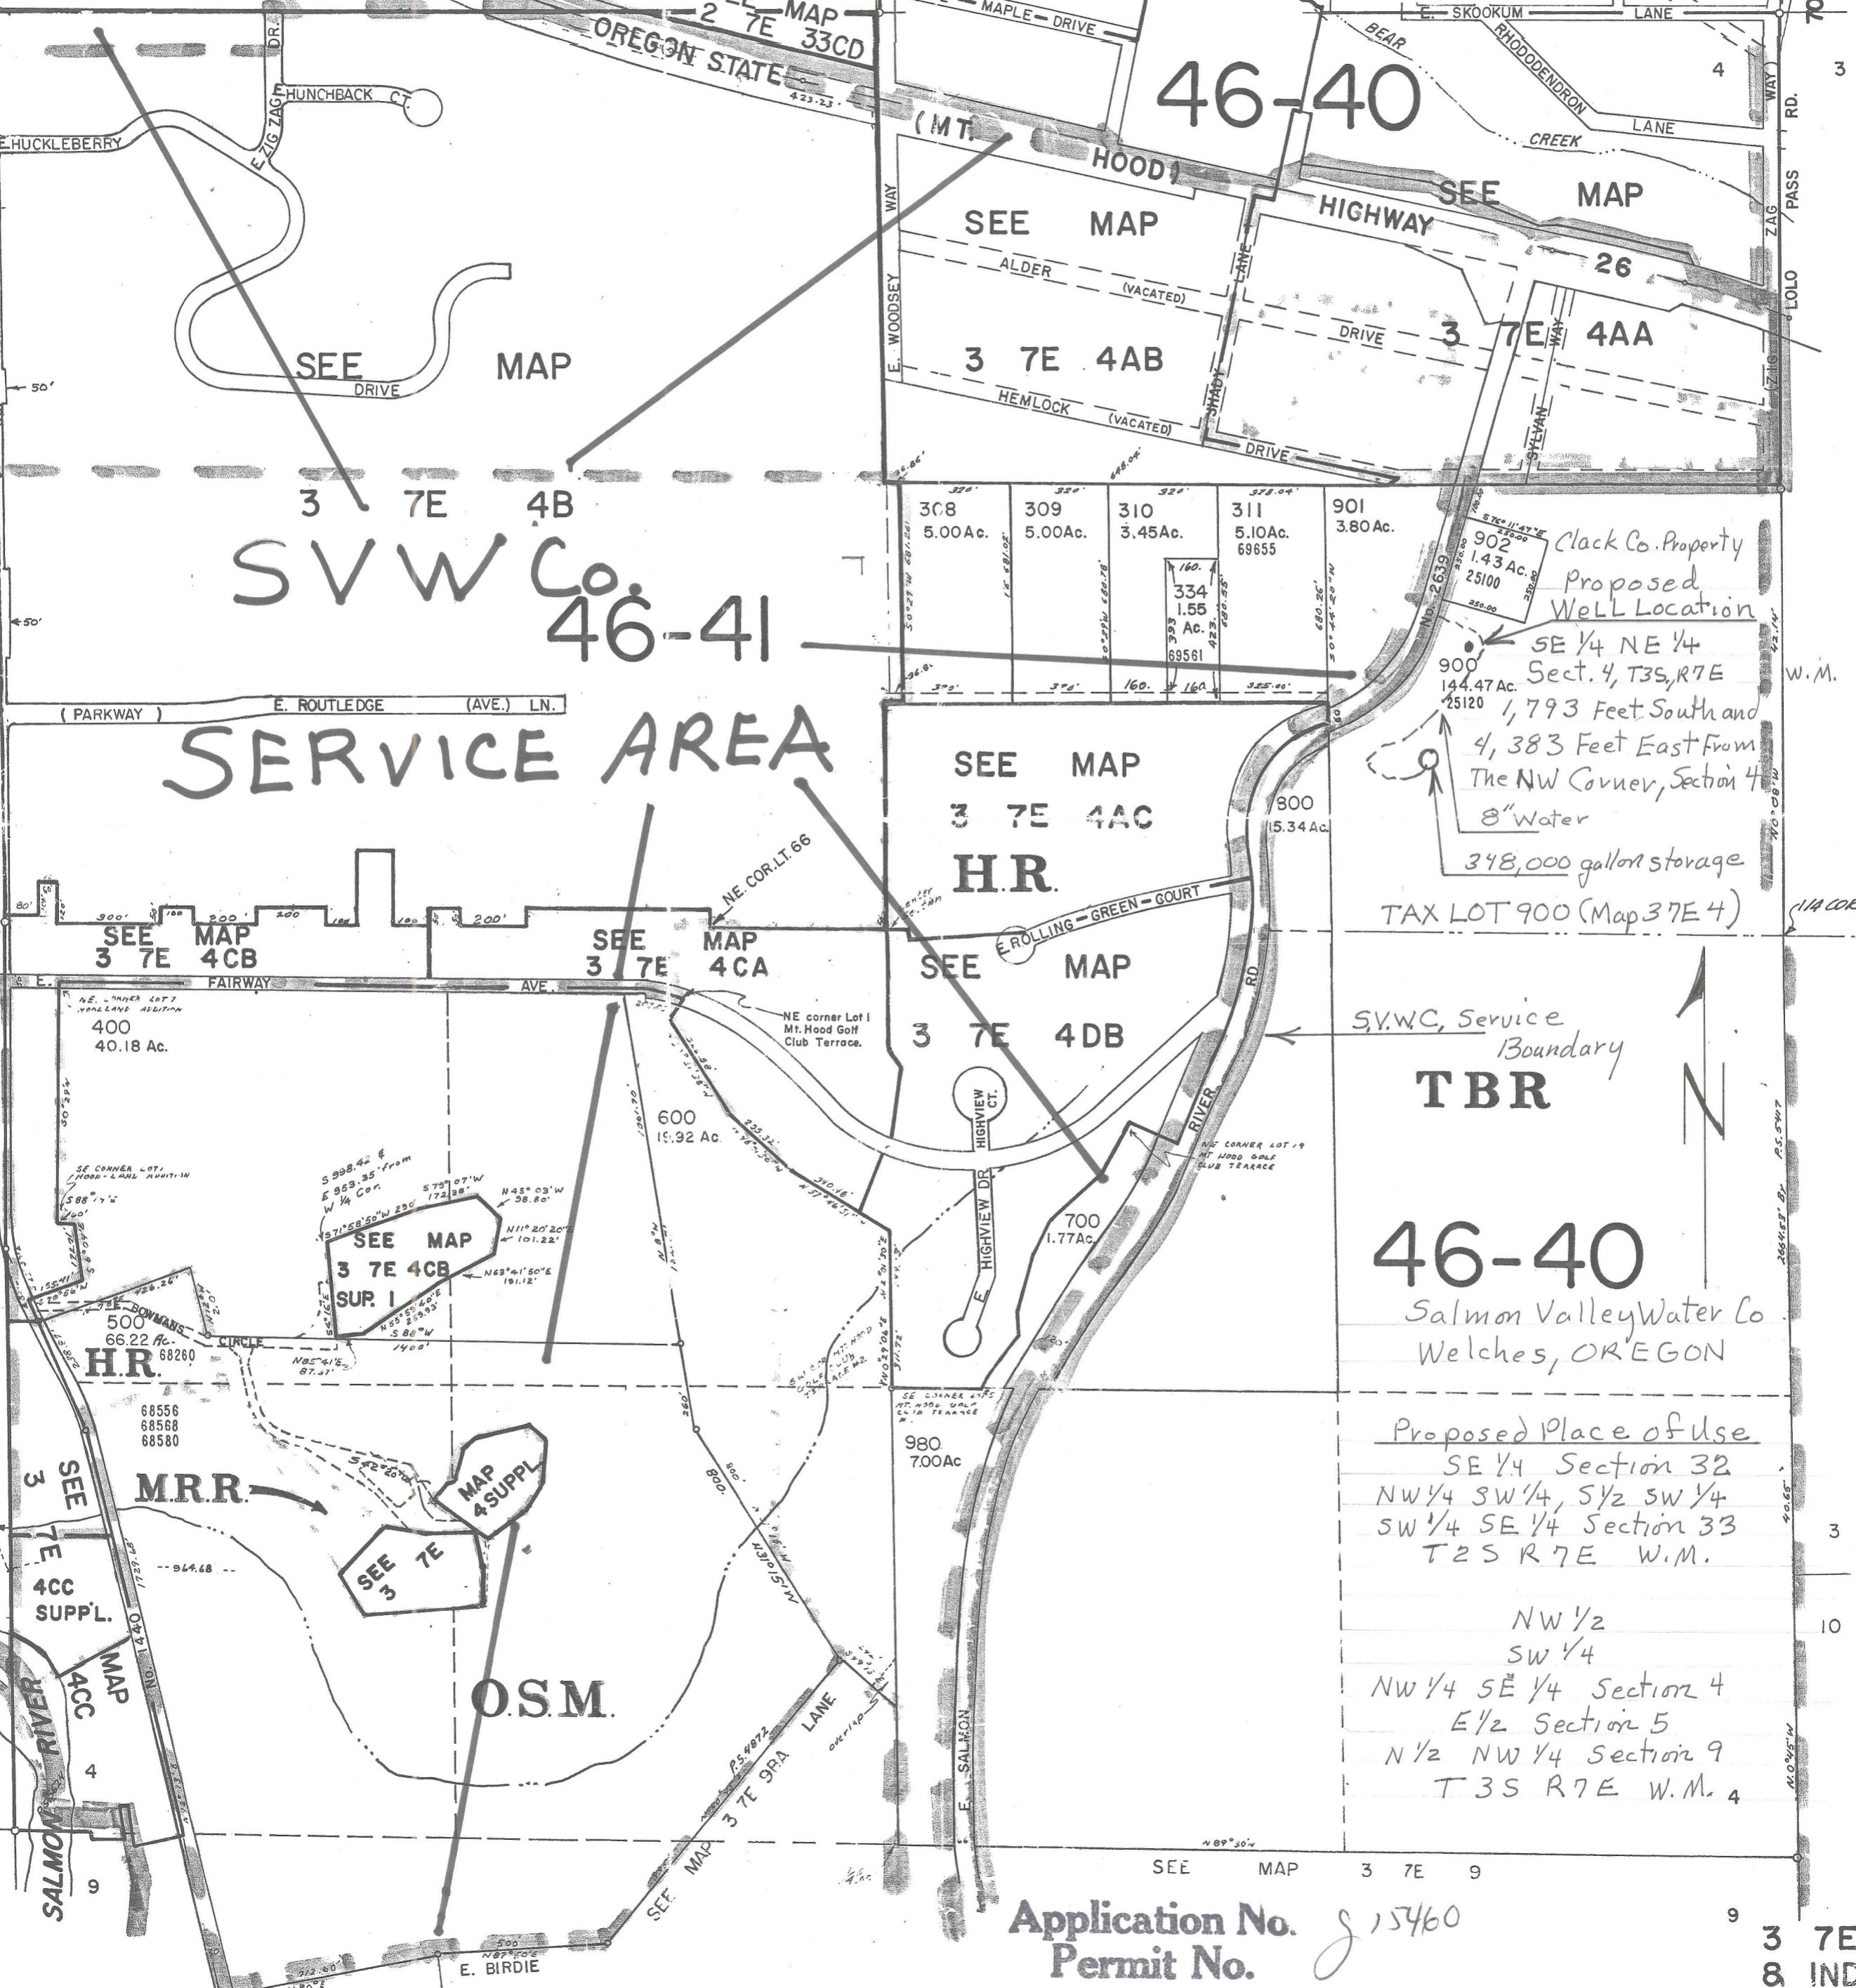

SVWC Co. 46-41

SERVICE AREA

H.R.

TBR

46-40

Salmon Valley Water Co
Welches, OREGON

Proposed Place of Use
SE 1/4 Section 32
NW 1/4 SW 1/4, S 1/2 SW 1/4
SW 1/4 SE 1/4 Section 33
T 2 S R 7 E W.M.

NW 1/2
SW 1/4
NW 1/4 SE 1/4 Section 4
E 1/2 Section 5
N 1/2 NW 1/4 Section 9
T 3 S R 7 E W.M. 4

Application No. 15460
Permit No.

3 7E 4
& INDEX