

This map was prepared for assessment purpose only.


SECTION 4 T.3S. R.7E. W.M.
CLACKAMAS COUNTY

1" = 400'

3 7E 4
& INDEX

CANCELLED NOS.

TL	501	329	200	307
	203	324	201	312
	502	318	301	313
	191	315	302	314
	104	100	303	316
	105	101	304	327
	2701	102	305	328
	190	103	306	330
	202			331
				332
				333
				335
				336
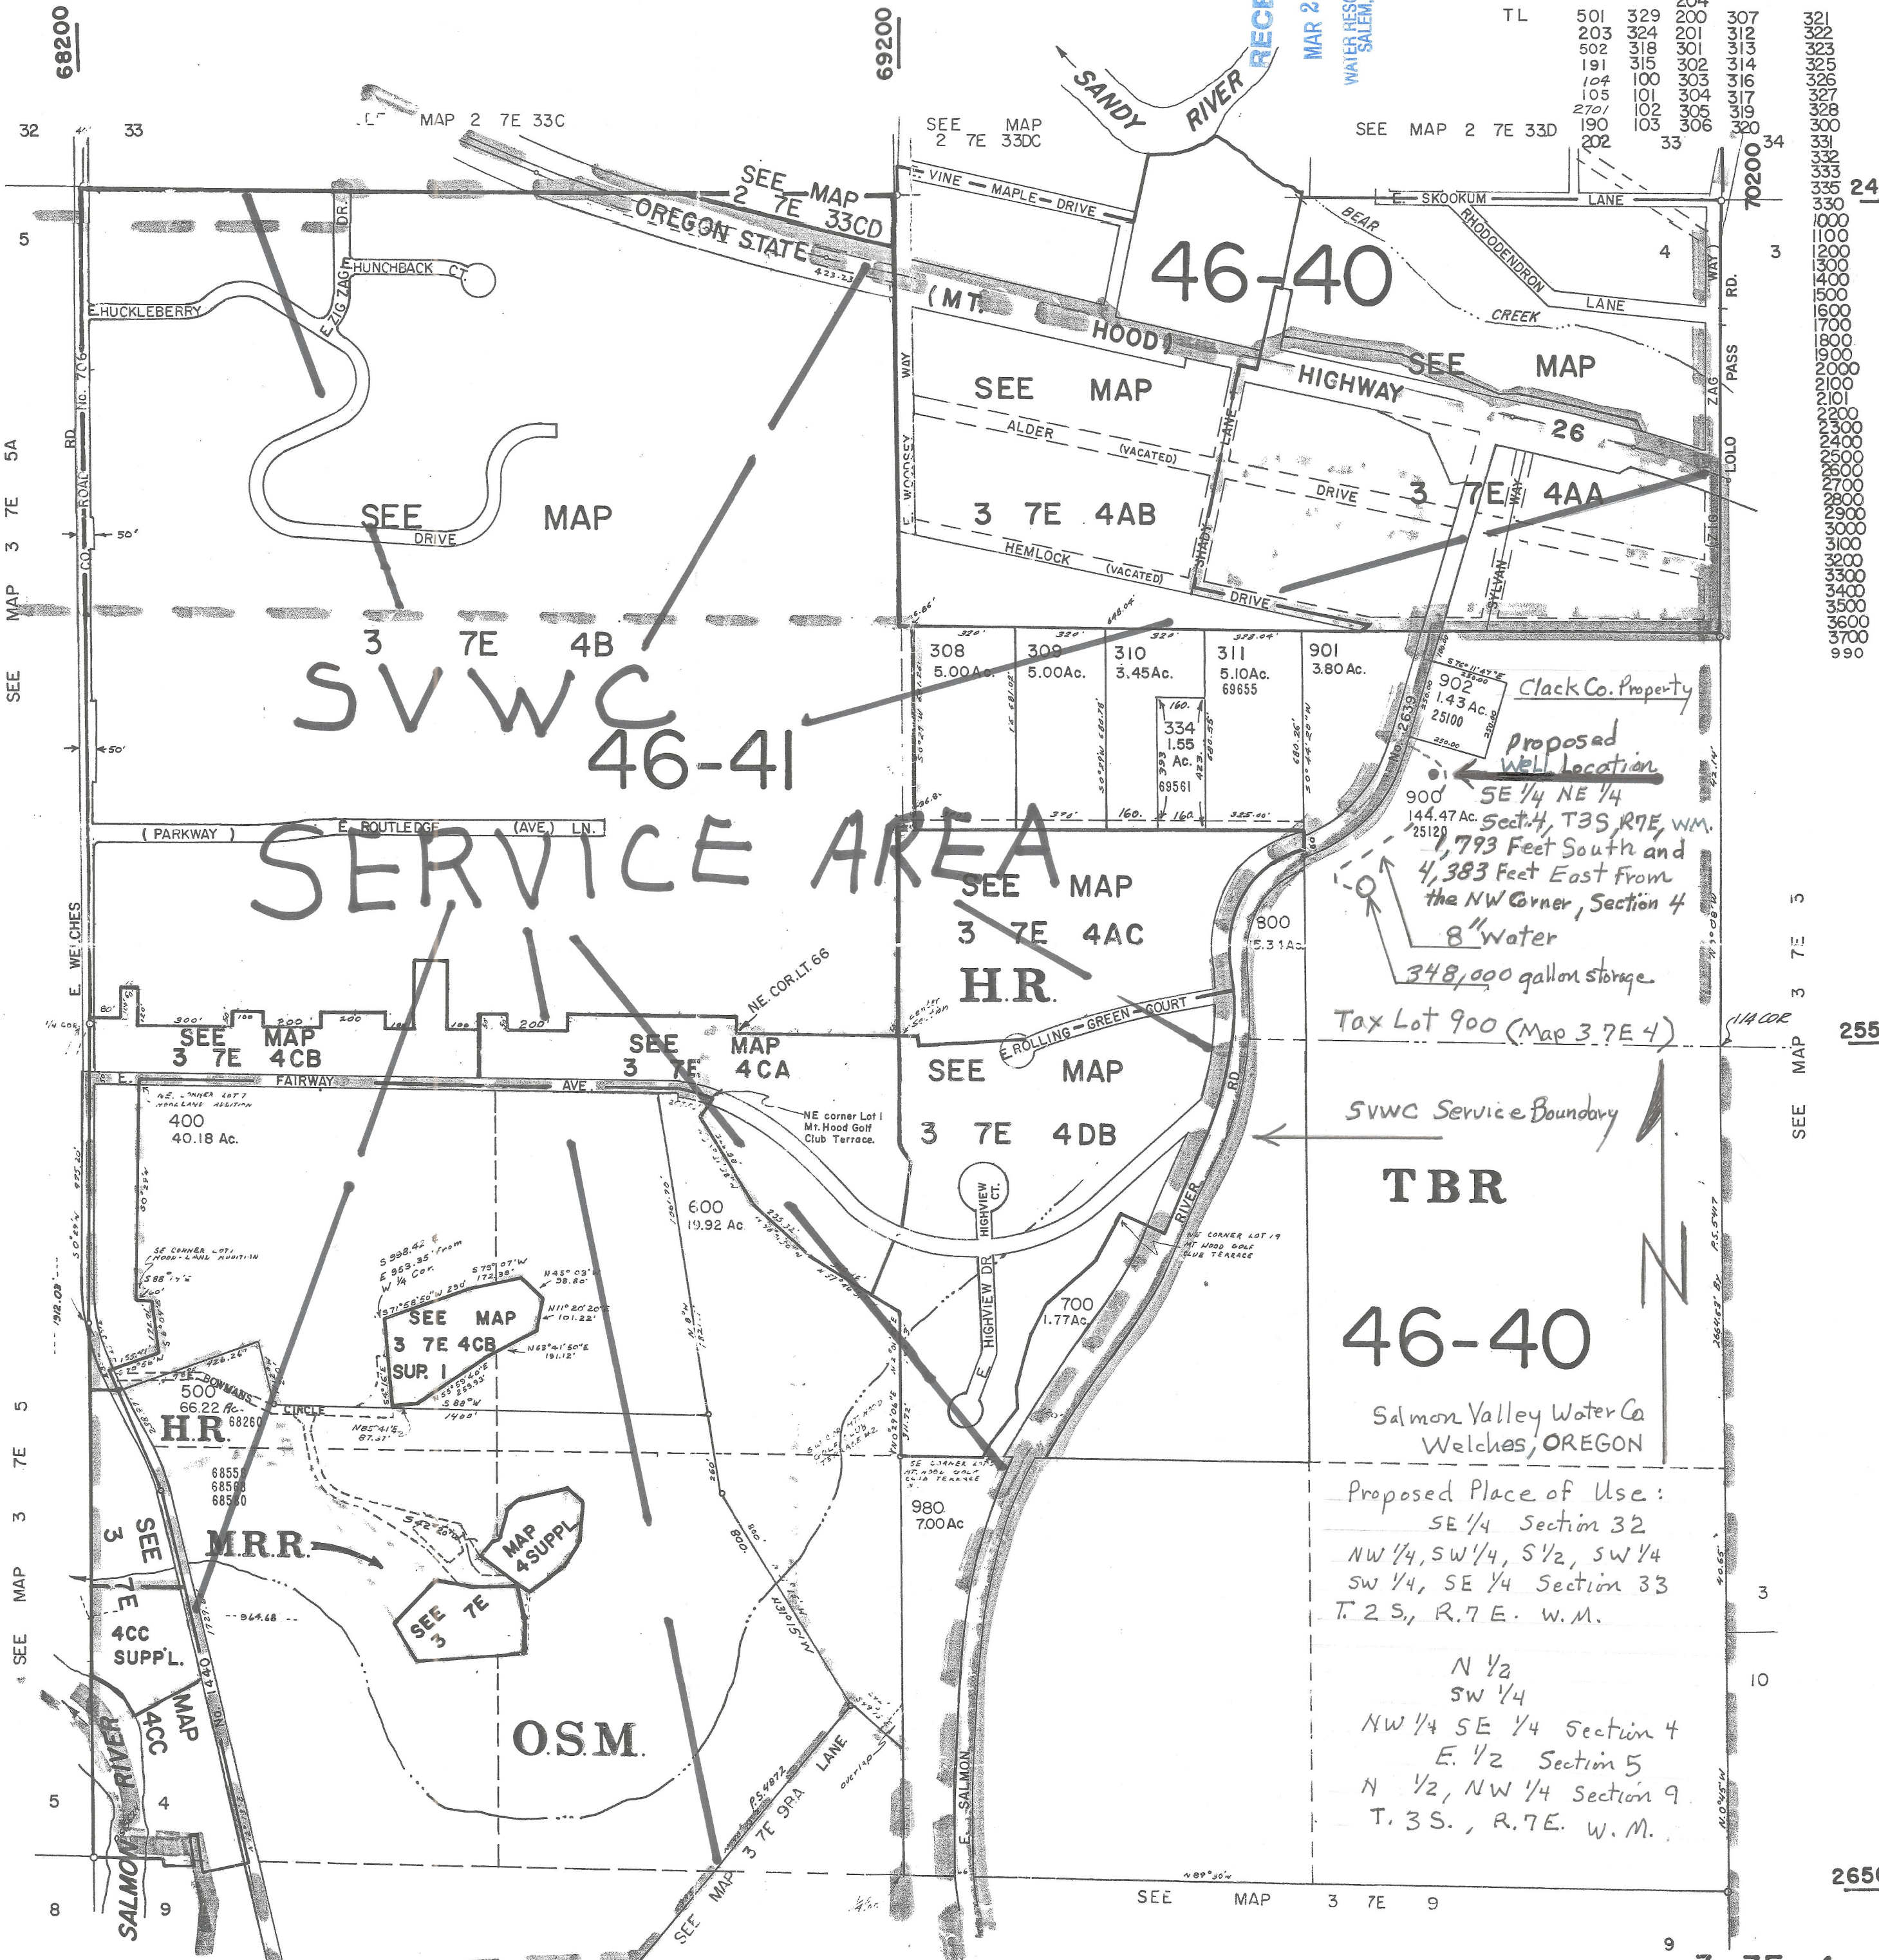

Clack Co. Property
 Proposed Well Location
 SE 1/4 NE 1/4
 Sect. 4, T.3S, R.7E, W.M.
 793 Feet South and
 4,383 Feet East From
 the NW Corner, Section 4
 8" water
 348,000 gallon storage

Tax Lot 900 (Map 3 7E 4)

SVWC Service Boundary

TBR
46-40
 Salmon Valley Water Co
 Welches, OREGON

Proposed Place of Use:
 SE 1/4 Section 32
 NW 1/4, SW 1/4, S 1/2, SW 1/4
 SW 1/4, SE 1/4 Section 33
 T. 2 S., R. 7 E. W.M.

N 1/2
 SW 1/4
 NW 1/4 SE 1/4 Section 4
 E. 1/2 Section 5
 N 1/2, NW 1/4 Section 9
 T. 3 S., R. 7 E. W.M.

Application No. 915460
 Permit No.

3 7E 4
& INDEX
 BOOK 34