


Legend

- TL 300
- Well 1
- Place of Use

Well #1 is 2359 South
 and 1247 East from NW
 Corner Section 4



JACKSON COUNTY
WATERMASTER

1

This map is based on a digital database compiled by Jackson County from a variety of sources. Jackson County cannot accept responsibility for errors, omissions, or positional accuracy. There are no warranties, expressed or implied.

Date: 03/03/2017, 34-1W-04 TL 300.mxd, hayness

G-18584