

5-88481


RECEIVED BY OWRD

DEC 05 2017

SALEM, OR

SEE MAP 12 11 30

1. water diversion point located 170 ft. east and 420 ft. north from southwest corner of section 19
2. water pump located 170 ft. east and 435 ft. north from southwest corner of section 19
3. Water Storage tank located 225 ft. east and 600 ft. north from southwest corner of section 19.
4. House / Place of use located 150 ft. east and 580 ft. north of southwest corner of section 19.

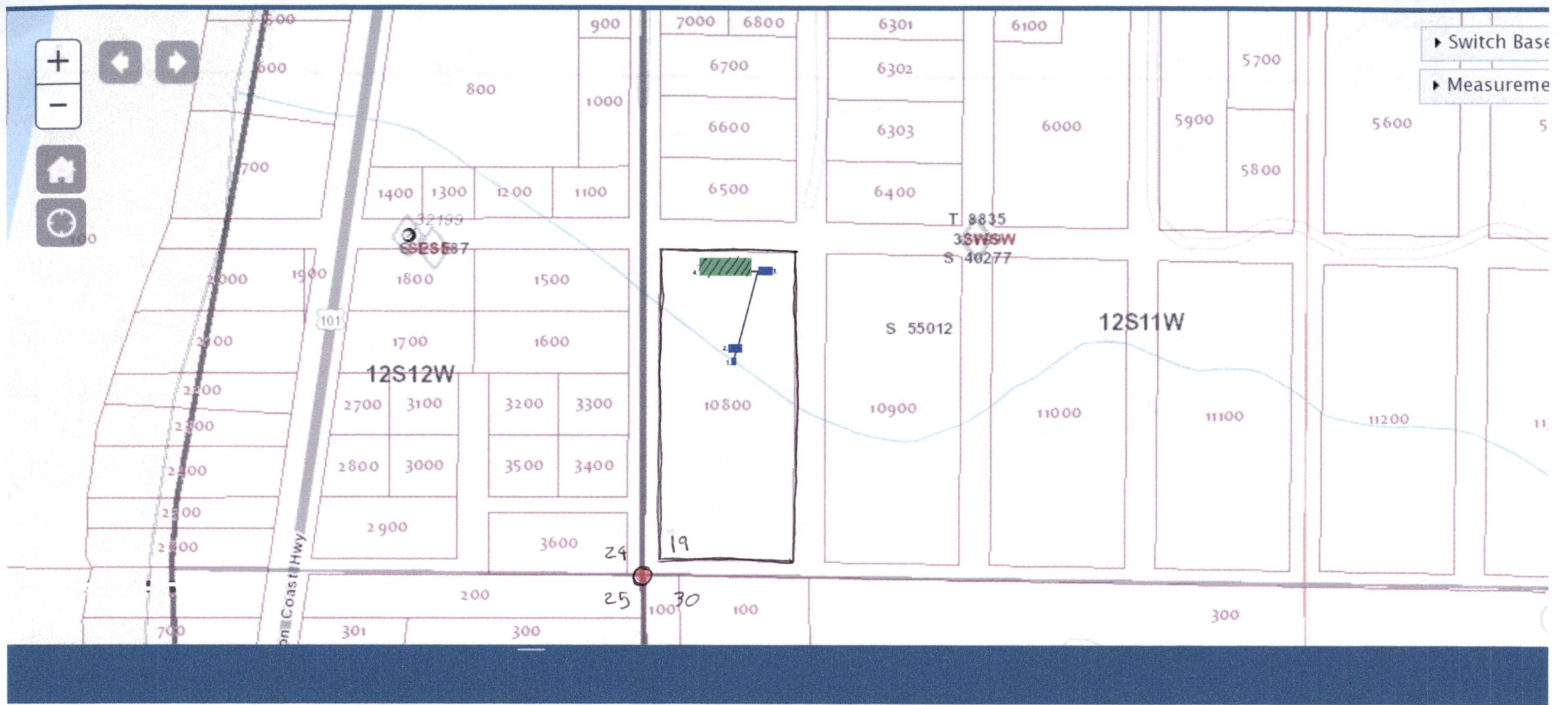

1. Water diversion point located 170 ft. East and 420 ft. North from southwest corner of section 19
2. water pump located 170 ft. east and 435 ft. north from southwest corner of section 19
3. water storage tank located 225 ft. east and 600 ft. north from southwest corner of section 19
4. House/Place of use located 150 ft. east and 580 ft. north from southwest corner of section 19.



1. **Water Diversion Point** (See Water Intake Diagram for more information)
 2. **Water Pump** (See Water Diagram for more information)
 3. **Water Storage Tank** (See Water Diagram for more information)
 4. **House / Place Of Use** (See Water Diagram for more information)
- ⊕ **Southwest Corner of Section 19**

RECEIVED BY OWRD

DEC 05 2017

SALEM, OR

Township: 12
Range: 11
Section: 19
1/4 1/4: CØ
Tax Lot: 10800
County: Lincoln
Subdivision: Seal Rock View
Lot: 1-5
Block: 3

19488-5