



LUNDY POND

T 4S R 4W, Section 36

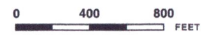

1" = 800'

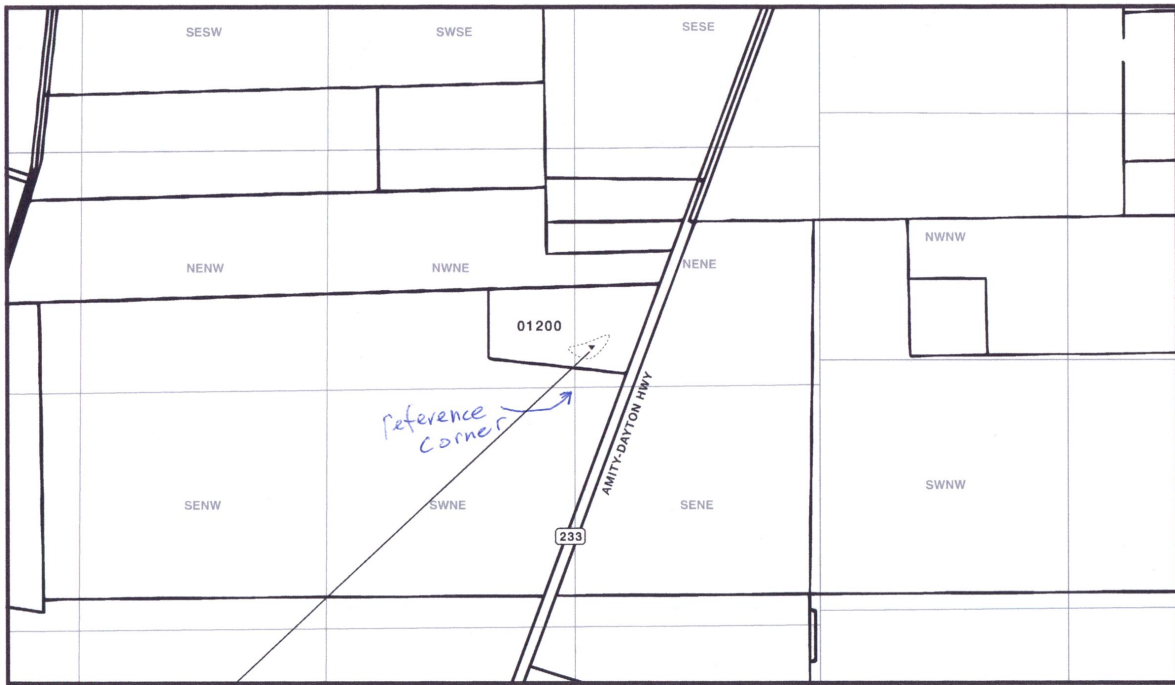

- Proposed pond located 202 feet North and 90 feet East from the Southwest corner of the NENE 1/4 /14.

RECEIVED

DEC 5 2017

OWPRD