
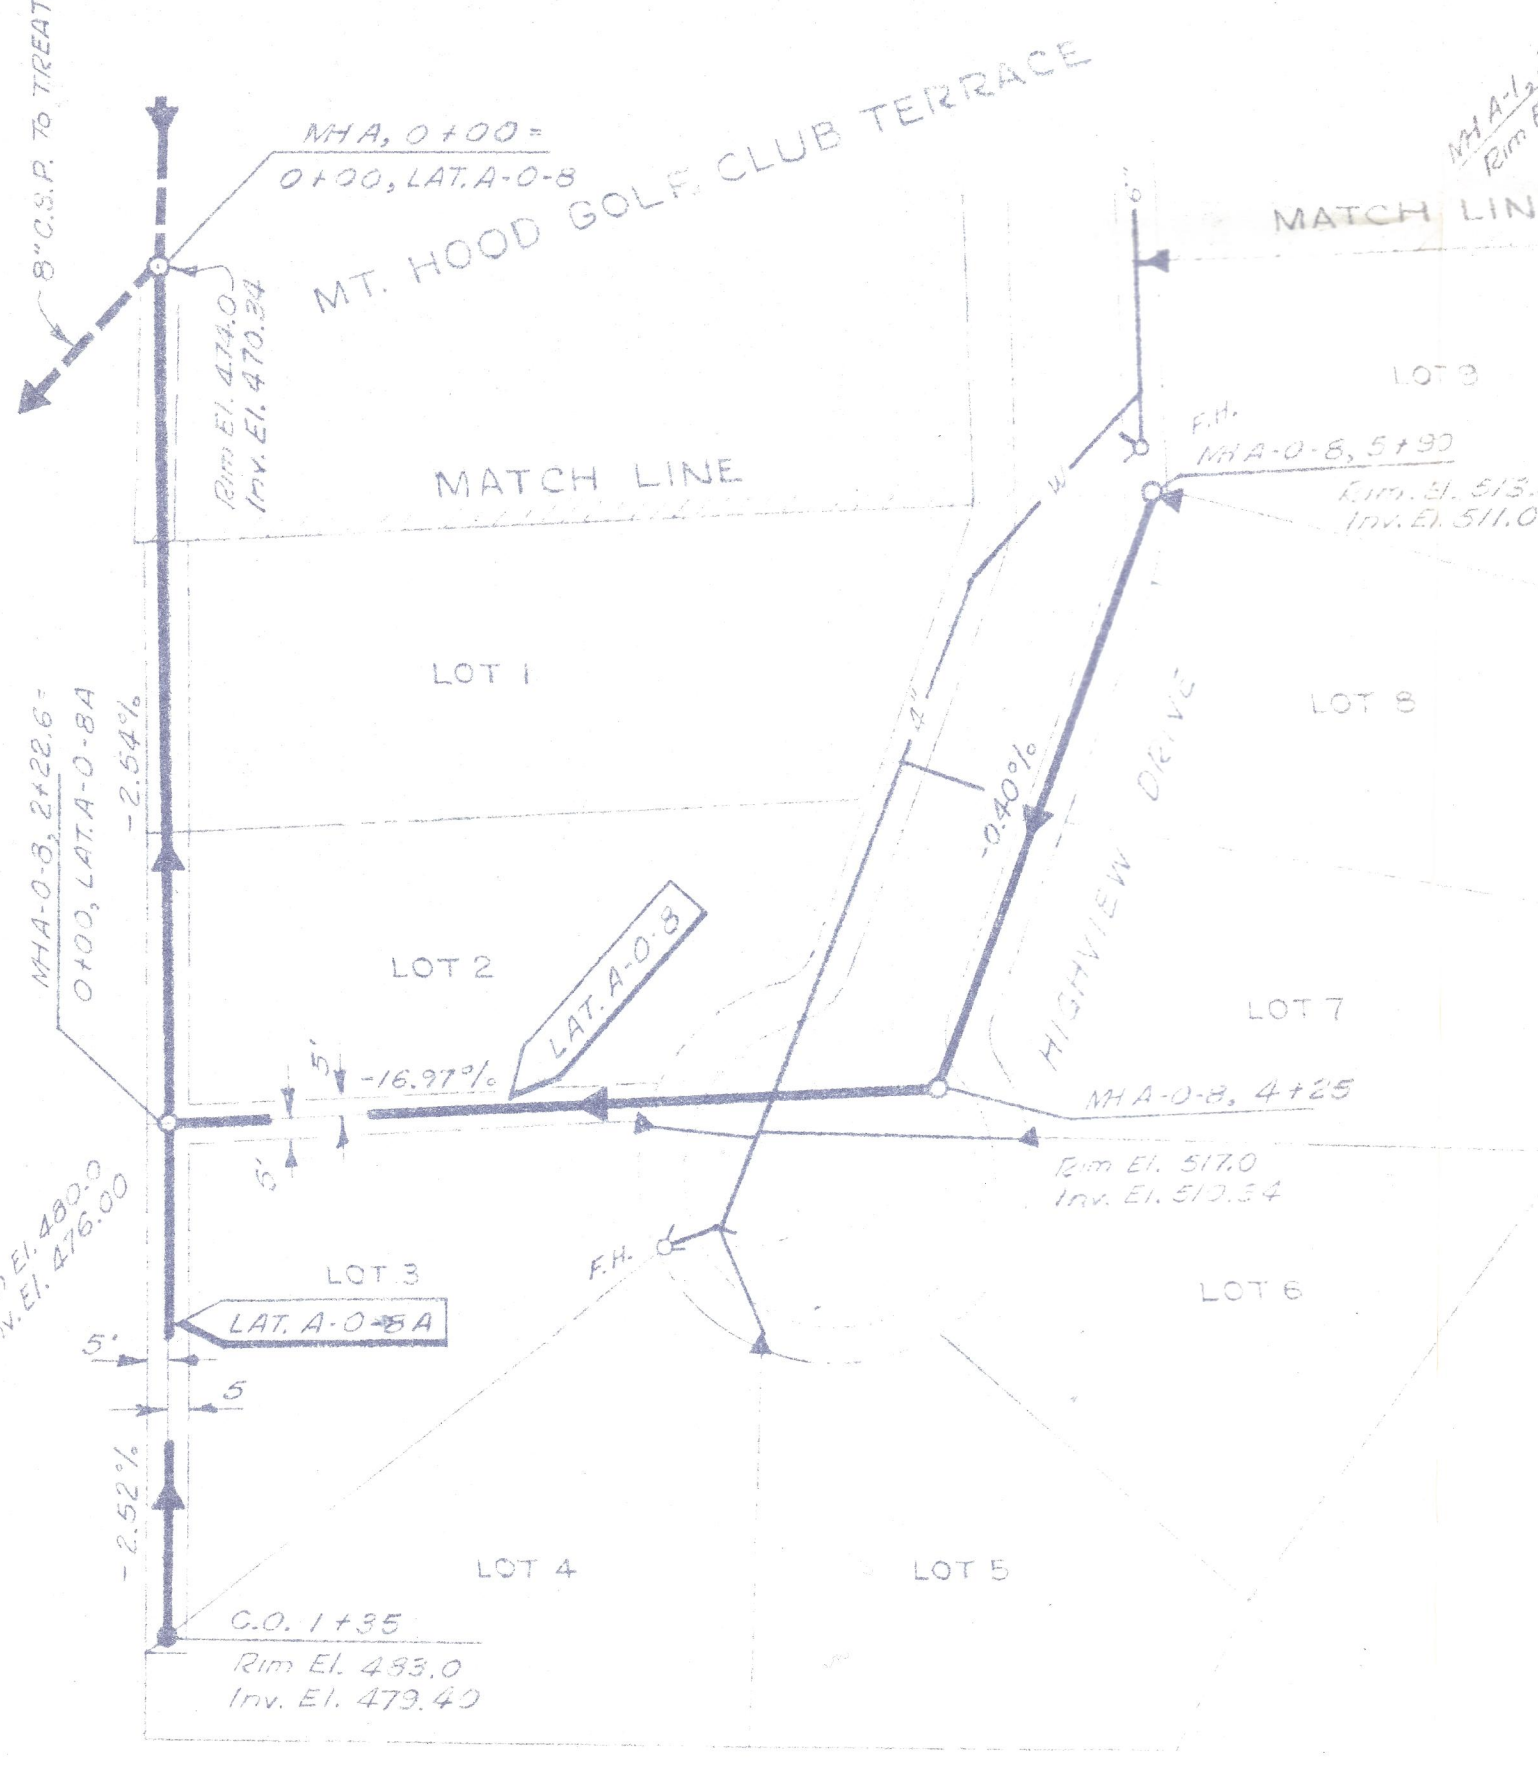


PROPOSED DISTRICT BOUNDARIES
 MT. HOOD GOLF SANITARY DISTRICT
 GOLF CLUB TERRACE WATER DISTRICT
 SCALE: 1" = 400'

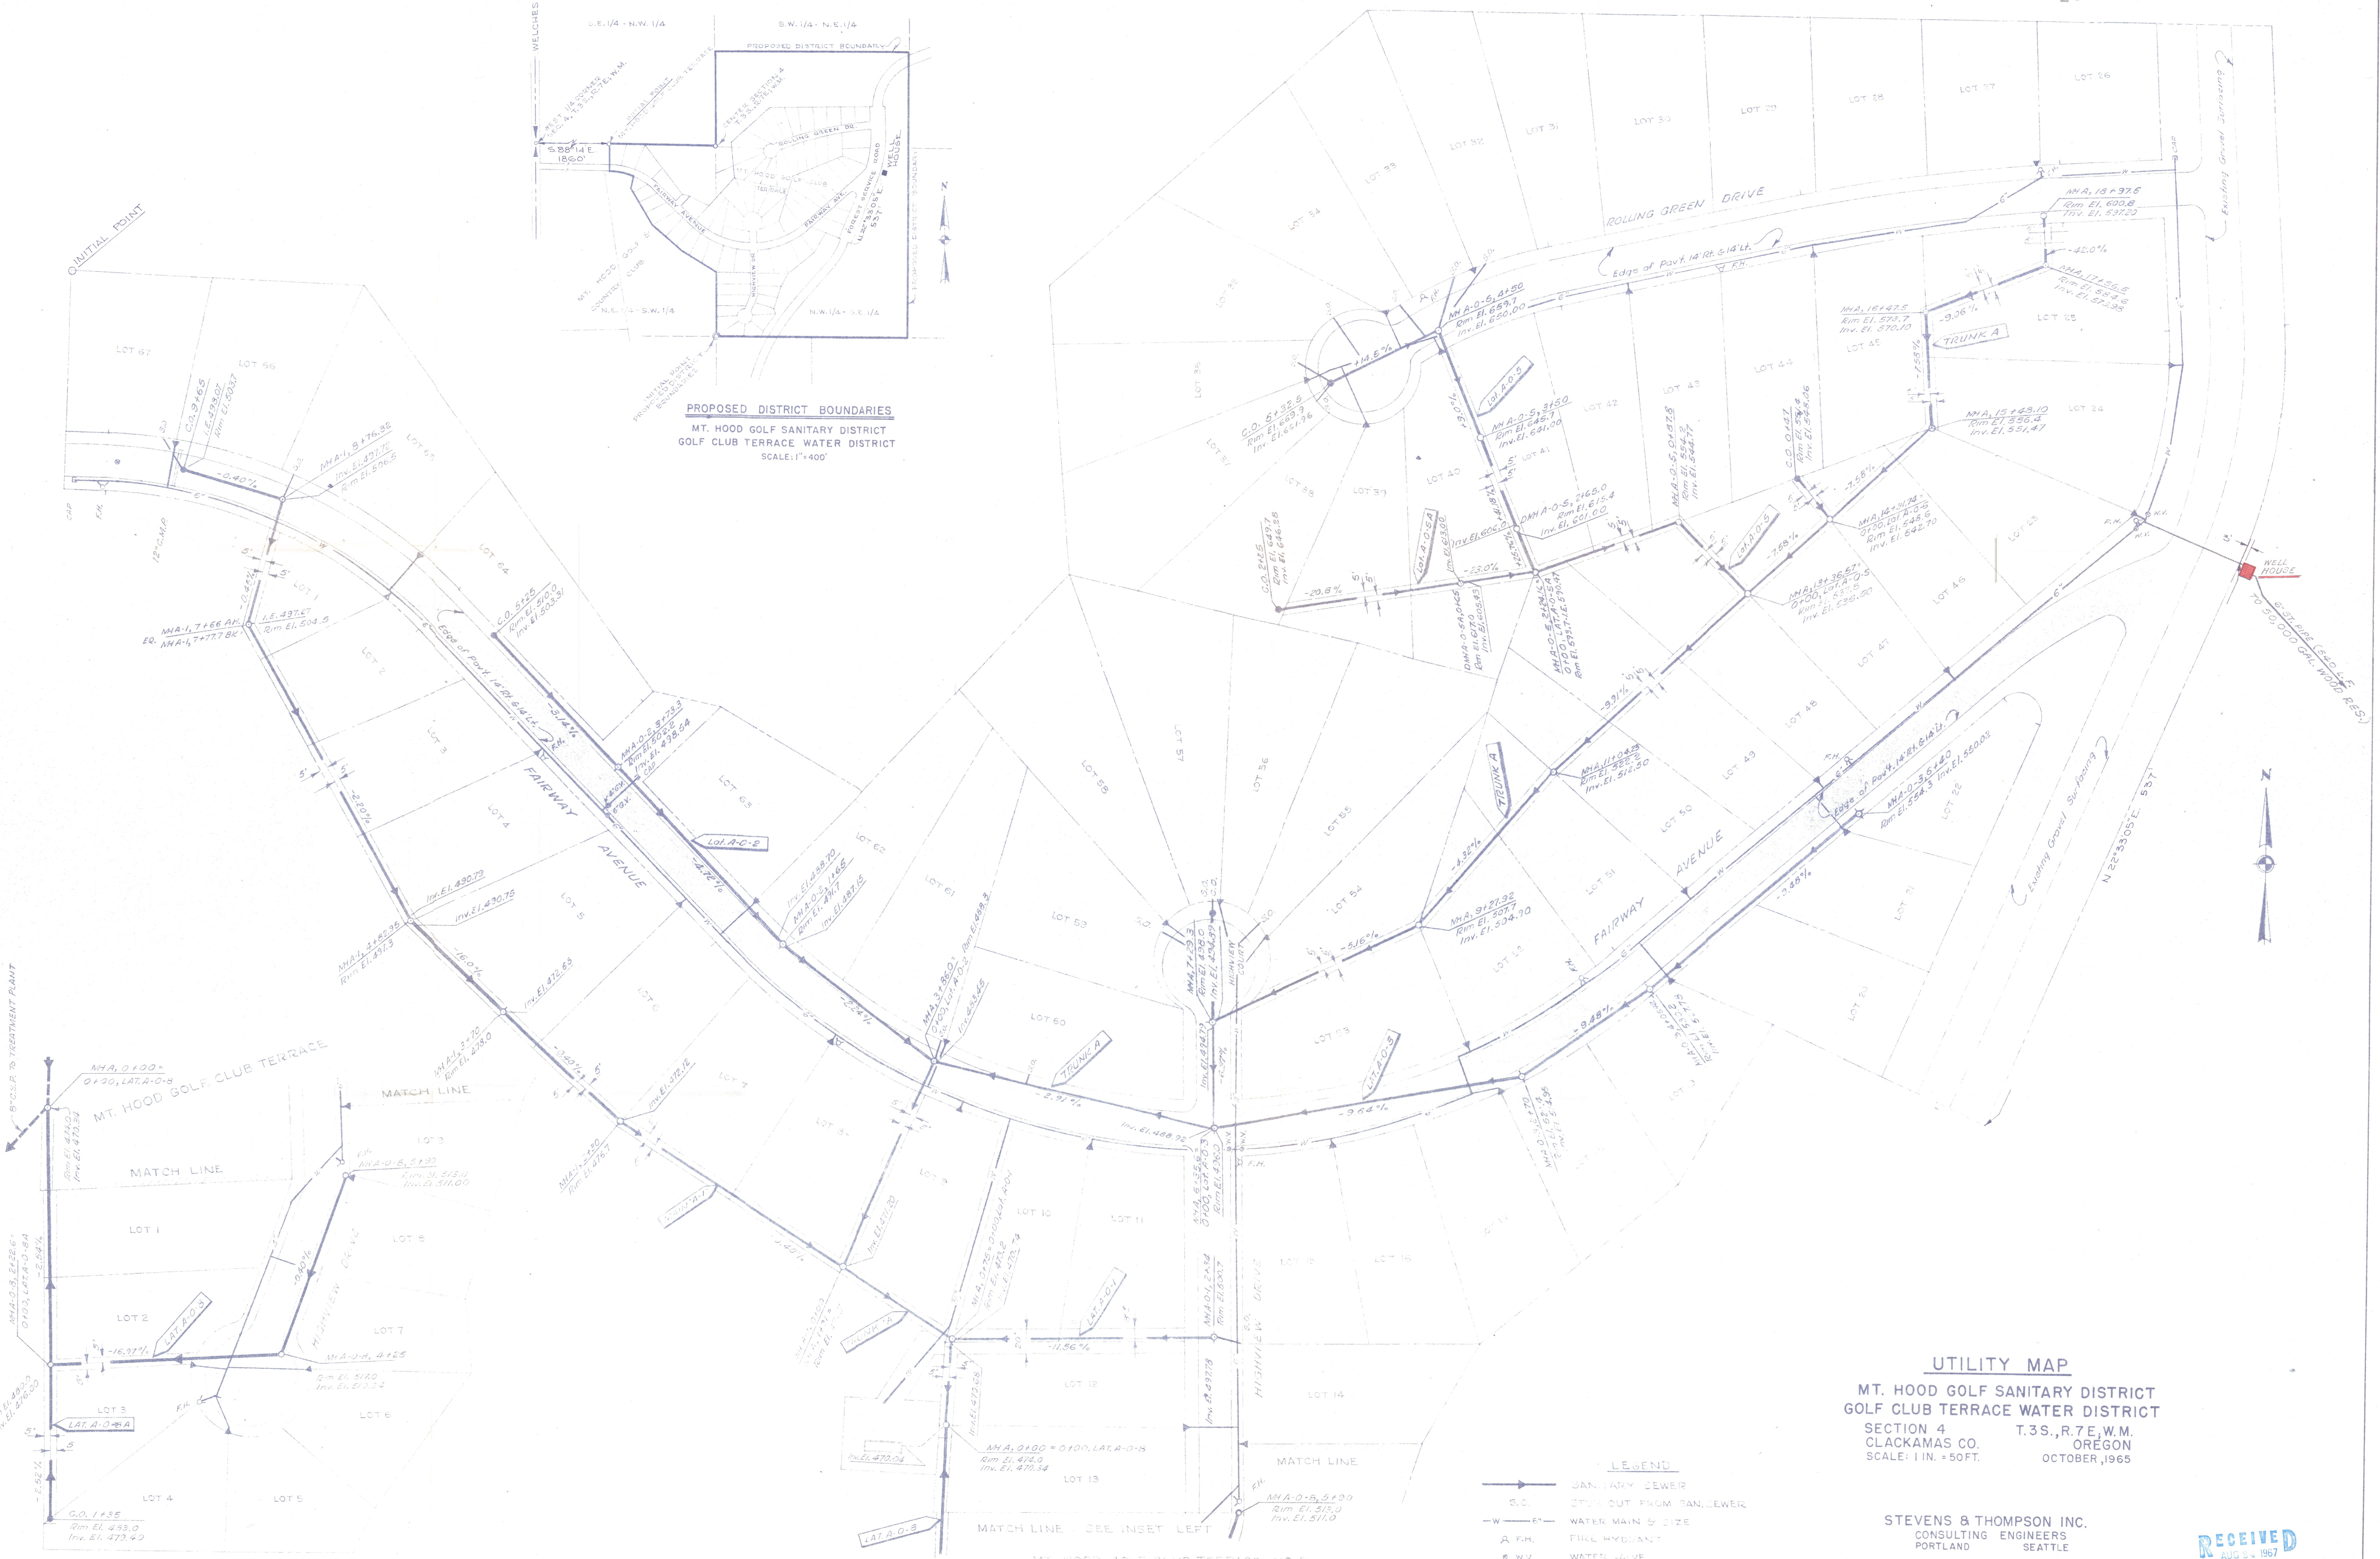

UTILITY MAP
 MT. HOOD GOLF SANITARY DISTRICT
 GOLF CLUB TERRACE WATER DISTRICT
 SECTION 4 T.3S., R.7E, W.M.
 CLACKAMAS CO. OREGON
 SCALE: 1 IN. = 50 FT. OCTOBER, 1965

- LEGEND**
- SANITARY SEWER
 - S.O. STUB OUT FROM SAN. SEWER
 - WATER MAIN 6" D.I.Z.E.
 - F.H. FIRE HYDRANT
 - W.V. WATER VALVE
 - ROUTE SERVICE WATER
- NOTE: EXISTING SANITARY SEWER STUBOUTS ARE INDICATED ON THIS MAP.

STEVENS & THOMPSON INC.
 CONSULTING ENGINEERS
 PORTLAND SEATTLE

