

Legend

 TL 602


 POD Poormas Creek Pond:

 Pond

Poormas Creek POD:
1242 ft West and
1270 ft South from Center of NW
Corner Section 7

Pond:
1150 West and
1206 ft South from Center of
NW Corner Section 7

1 inch = 500 feet

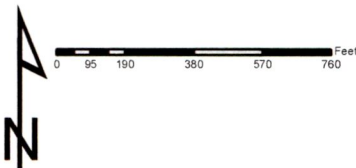

JACKSON COUNTY
WATERMASTER

Prepared by Shavon Haynes

This map is based on a digital database compiled by Jackson County from a variety of sources. Jackson County cannot accept responsibility for errors, omissions, or positional accuracy. There are no warranties, expressed or implied.

Date: 10/05/2017, 38S-2W-7-tax lot 602 Ben Beck.mxd haynes

R-88487