

07 3W 03DC

07 3W 03DC  
KEIZER



MARION COUNTY, OREGON  
SW1/4 SE1/4 SEC3 T7S R3W W.M.  
SCALE 1" = 100'

LEGEND


- LINE TYPES
- Taxlot Boundary
  - Road Right-of-Way
  - Railroad Right-of-Way
  - Private Road ROW
  - Subdivision/Plat Bndry
  - Waterline - Taxlot Bndry
  - Historical Boundary
  - Easement
  - Railroad Centerline
  - Taxcode Line
  - Map Boundary
  - Waterline - Non Bndry

- SYMBOL TYPES
- Survey Monument
  - Road Station
  - DLC Corner
  - 1/16TH Section Cor.
  - 1/4 Section Cor.
  - Section Corner

NUMBERS  
Tax Code Number  
**000 00 00 0**

Acreage 0.25 AC  
All acres listed are Net Acres, excluding any portions of the taxlot within public ROWs


NOTES  
Tick Marks: If a tick mark is indicated on the end of a line, then the dimension goes to the tick mark. This is used when dimensions extend into public right-of-ways.

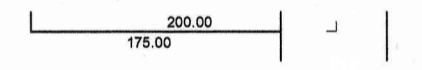

CANCELLED NUMBERS

2300			
2800			
2900			

DISCLAIMER: THIS MAP WAS PREPARED FOR ASSESSMENT PURPOSES ONLY

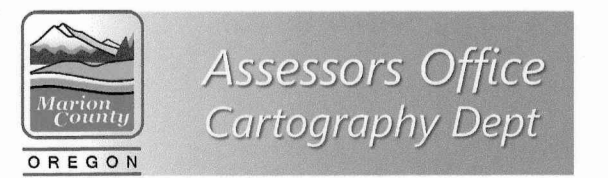

FOR ADDITIONAL MAPS VISIT OUR WEBSITE AT [www.co.marion.or.us](http://www.co.marion.or.us)

PLOT DATE: 7/6/2016

KEIZER  
07 3W 03DC

1/16 COR

SEE MAP 073W03DB

SEE MAP 073W03DA

1/16 COR

POLK COUNTY

WILLAMETTE RIVER

850' EAST  
POD = SW 1/4 of SE 1/2 Sec 3

520' NORTH

1/4 COR

07 3W 03DC

MENLO AVENUE N

MENLO

SHORELINE DRIVE

DRIVE N

MARINO

DRIVE

MANBRIN DRIVE

MANBRIN GARDENS ANNE NO. 2

MANBRIN

MANBRIN DRIVE

GARDENS ANNE NO. 2

1500 PARCEL 1 0.26 AC  
1501 PAR 2  
P.P. 07-10

WAYNE DRIVE N

RIVERCREST

924 20 22 0

SUNSET PARK

SEE MAP 073W10AA

SUNSET AV

1600 0.81 AC

1800 0.48 AC

1900 0.71 AC

2000 0.97 AC

2100 0.68 AC

2200 0.64 AC

2400 0.68 AC

2500 0.61 AC

2700 0.29 AC

3400 1.55 AC

3500 1.53 AC

3800 0.23 AC

3700 0.68 AC

3600 0.20 AC

14

12

11

10

9

8

7

6

5

4

3

5

4

3

2

1

4

3

2

1





































