

3
RECEIVED


OCT 4 1978

WATER RESOURCES DEPT.
SALEM, OREGON

T12S R22E W.M.

Scale 4" = 1 mi.

Div No. 1- 1360' S & 430' W from NE cor Sec 34
Div No. 3- 80' S & 1080' E from NW cor Sec 26

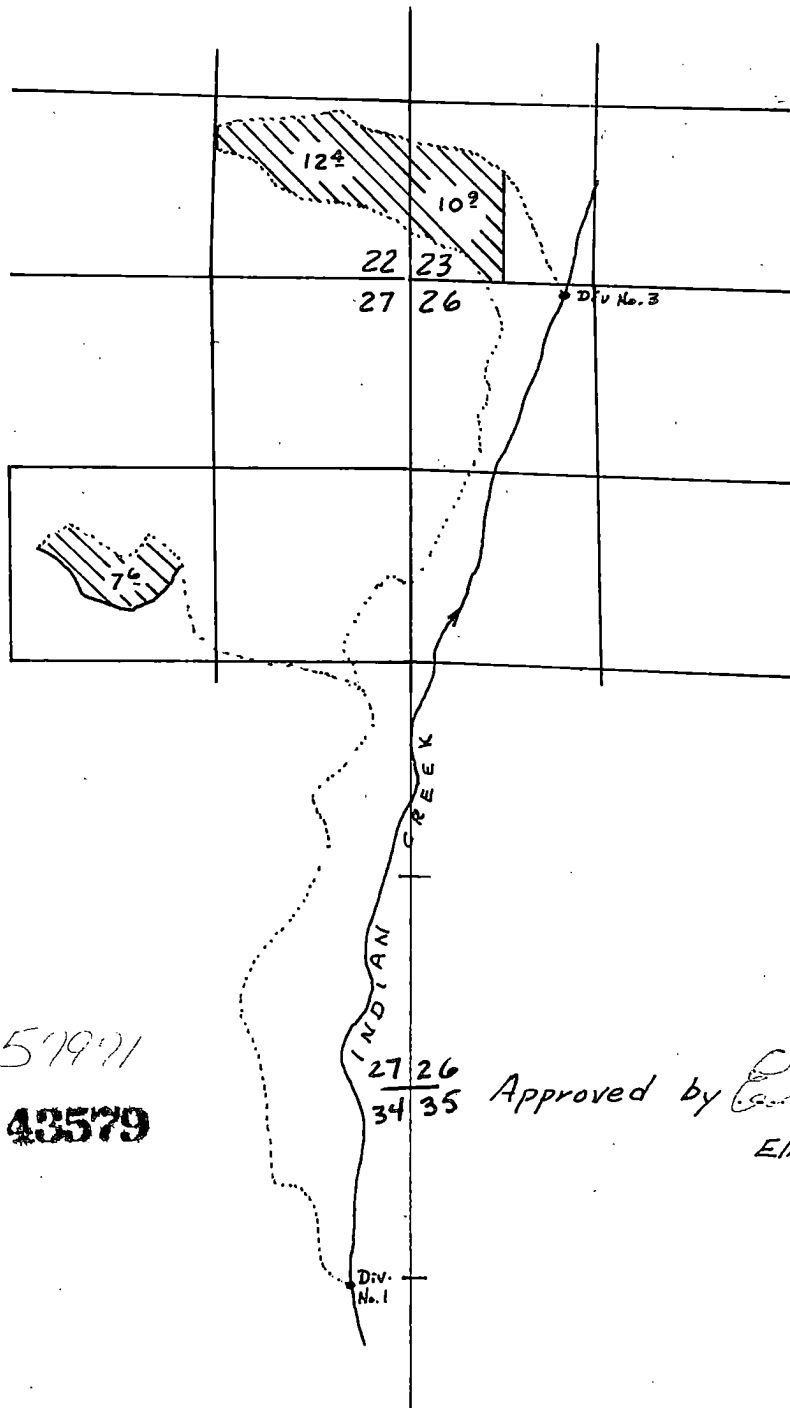

Application No. 57971
Permit No. 43579

Approved by *Elmer J. Jackson*
Elmer J. Jackson

Info: Mr. Jackson. Land is irr. as filed. System is unchanged since Toll report 6/12/75.

Source: Indian Crk. D.P. # 1 on FP map. All Land is flood irr. See Toll report.

Use: Irr. of hay crop.

Ditches are all 2'-3' wide & 1' deep

Tie: Inspection of F.P. map.

Chris Hughes

FE

7/24/79


OCT 4 1978

INSPECT
This

Scale 4" = 1 mi


Div No. 1-1360' S & 430' W from NE cor Sec 34

Div No. 3- 80's $\pm 1080'$ E from NW cor sec 26

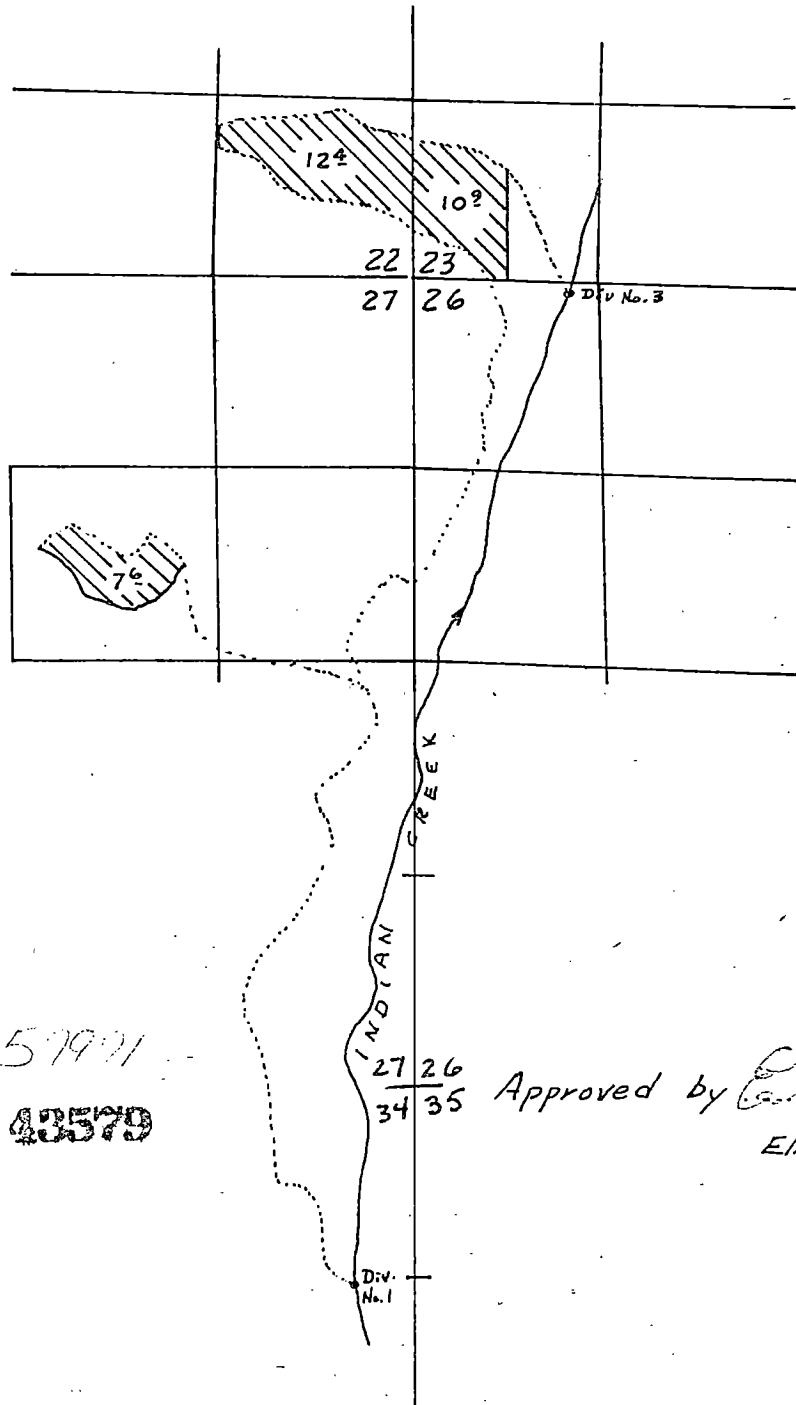

Application No. 57921
Permit No. 43579

Approved by Elmer J. Jackson
Elmer J. Jackson

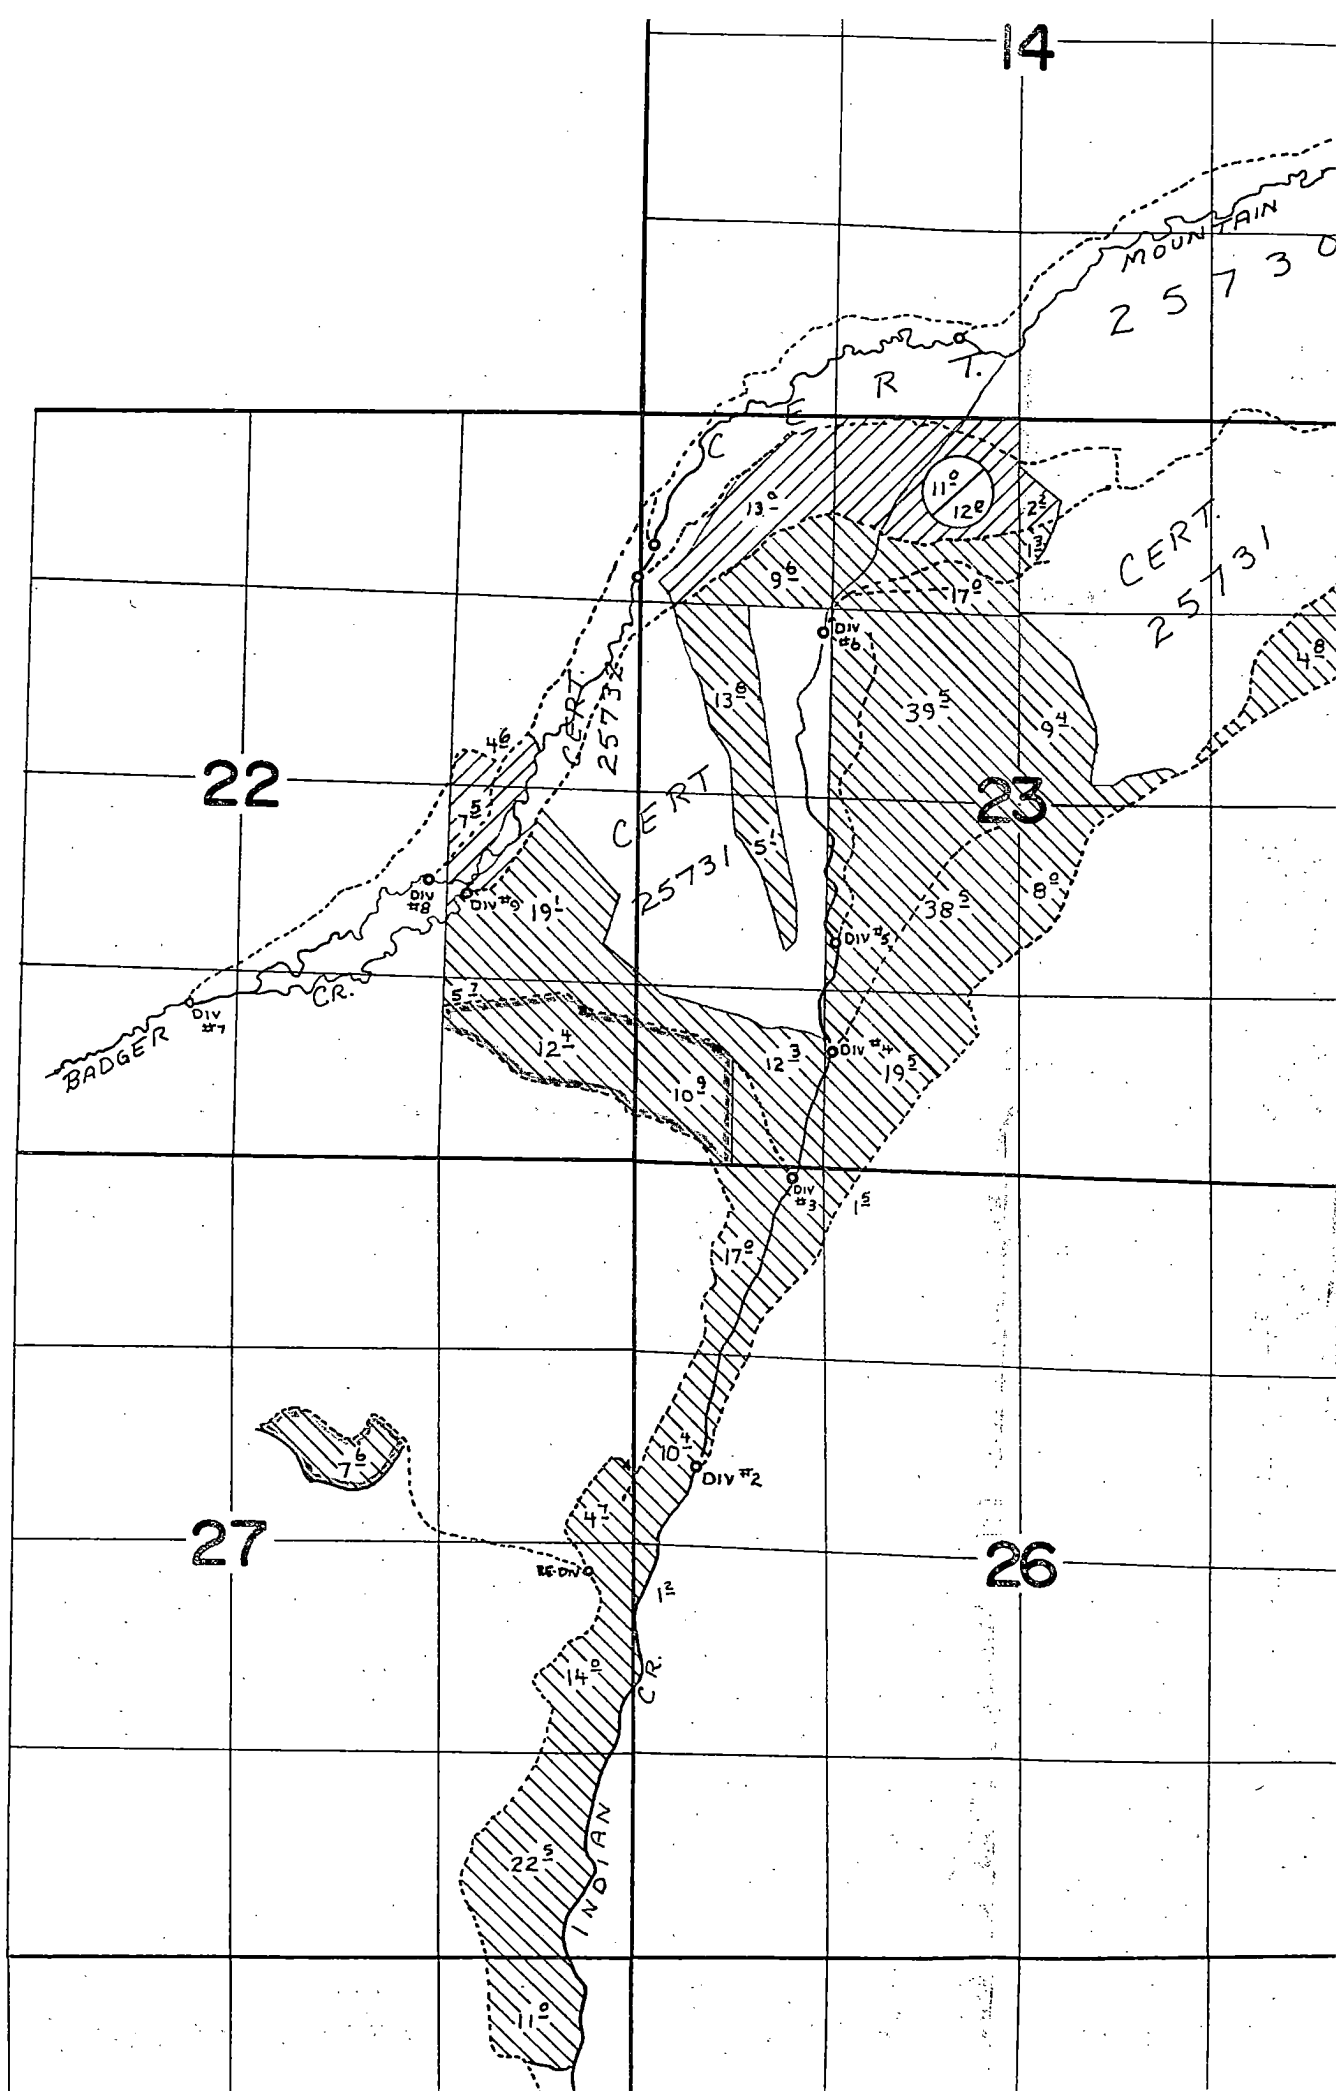


INFO- ELMER JACKSON- HE SHOWED ALL LAND IRRIGATED
AND DIV PTS. THIS IS ALL LAND UNDER THIS PERMIT
AND OLD CERTS. THAT JACKSON IRR.

DIV- EARTH DAMS IN CREEK CHANNELS

SOME OF DAMS HAVE HEADGATE TO CONTROL
FLOW OF WATER. HEADGATE IS 1' SQUARE
ALL IRRIGATION IN FLOOD

DITCHES- MAIN DITCHES ARE

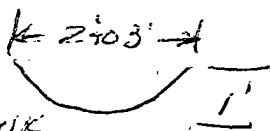

TURNOUTS IN DITCH BANK

SPREADER DITCHES ALL THROU. FIELD

DITCHES BELOW OTHER DITCHES PICK-UP
RUN-OFF PLUS WHAT IS DIVERTED FROM
CREEK AND SPREAD THIS WATER

USE- PASTURE (COW)

IFT- SEE QUAD SHEETS


TE- DOV-355-87

DOV-355-85

DOV-255-263

Leary
FE
6/12/75

NOTE:

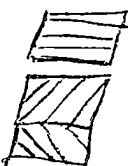

LAND IRR. FROM

BADGER CR.

INDIAN CR. ON DOV-355-85 & 255-263

" " ON DOV-355-87 (ON WEST SIDE OF PHOTO)

INDIAN CR. IS AN INTERMITTENT STREAM

LAND SHOW IS ALL LAND ~~THE~~ COVERED.

SOME YEARS, JACKSON SAID, LAND IS
COVERED VERY WELL BUT NOT IN
OTHER YEARS.

HEAVY TIMBERED AREA ON PHOTO
HAVE BEEN THINNED AND GRASS
IS GROWING.

ALL IRRIGATED LANDS HAVE BEEN
SEEDED TO GRASSES.

INDIAN CR. NEVER MAKES IT TO BADGER CR.

LAYOUT IS THE
ADJ.'S LAYOUT
12/1/75 AMT
ACKNOWLEDG IS TOTAL
LAND IN ADJ. MINS
AMOUNT OF
EXISTING RIGHT
1/1/75