


T.12S.,R.22E.,W.M.



DIV. LOC.

- #1-1360'S & 430'W FROM NE COR SEC 34
- #2-2080'S & 420' E FROM NW COR SEC 26
- #3- 80'S & 1080' E FROM NW COR SEC 26
- #4- 800'N & 1340' E FROM SW COR SEC 23
- #5-1550'N & 1350' E FROM SW COR SEC 23
- #6-1480'S & 1250' E FROM NW COR SEC 23
- #7-1020'N & 3080'W FROM SE COR SEC 22
- #8-1910'N & 1420'W FROM SE COR SEC 22
- #9-1830'N & 1170'W FROM SE COR SEC 22

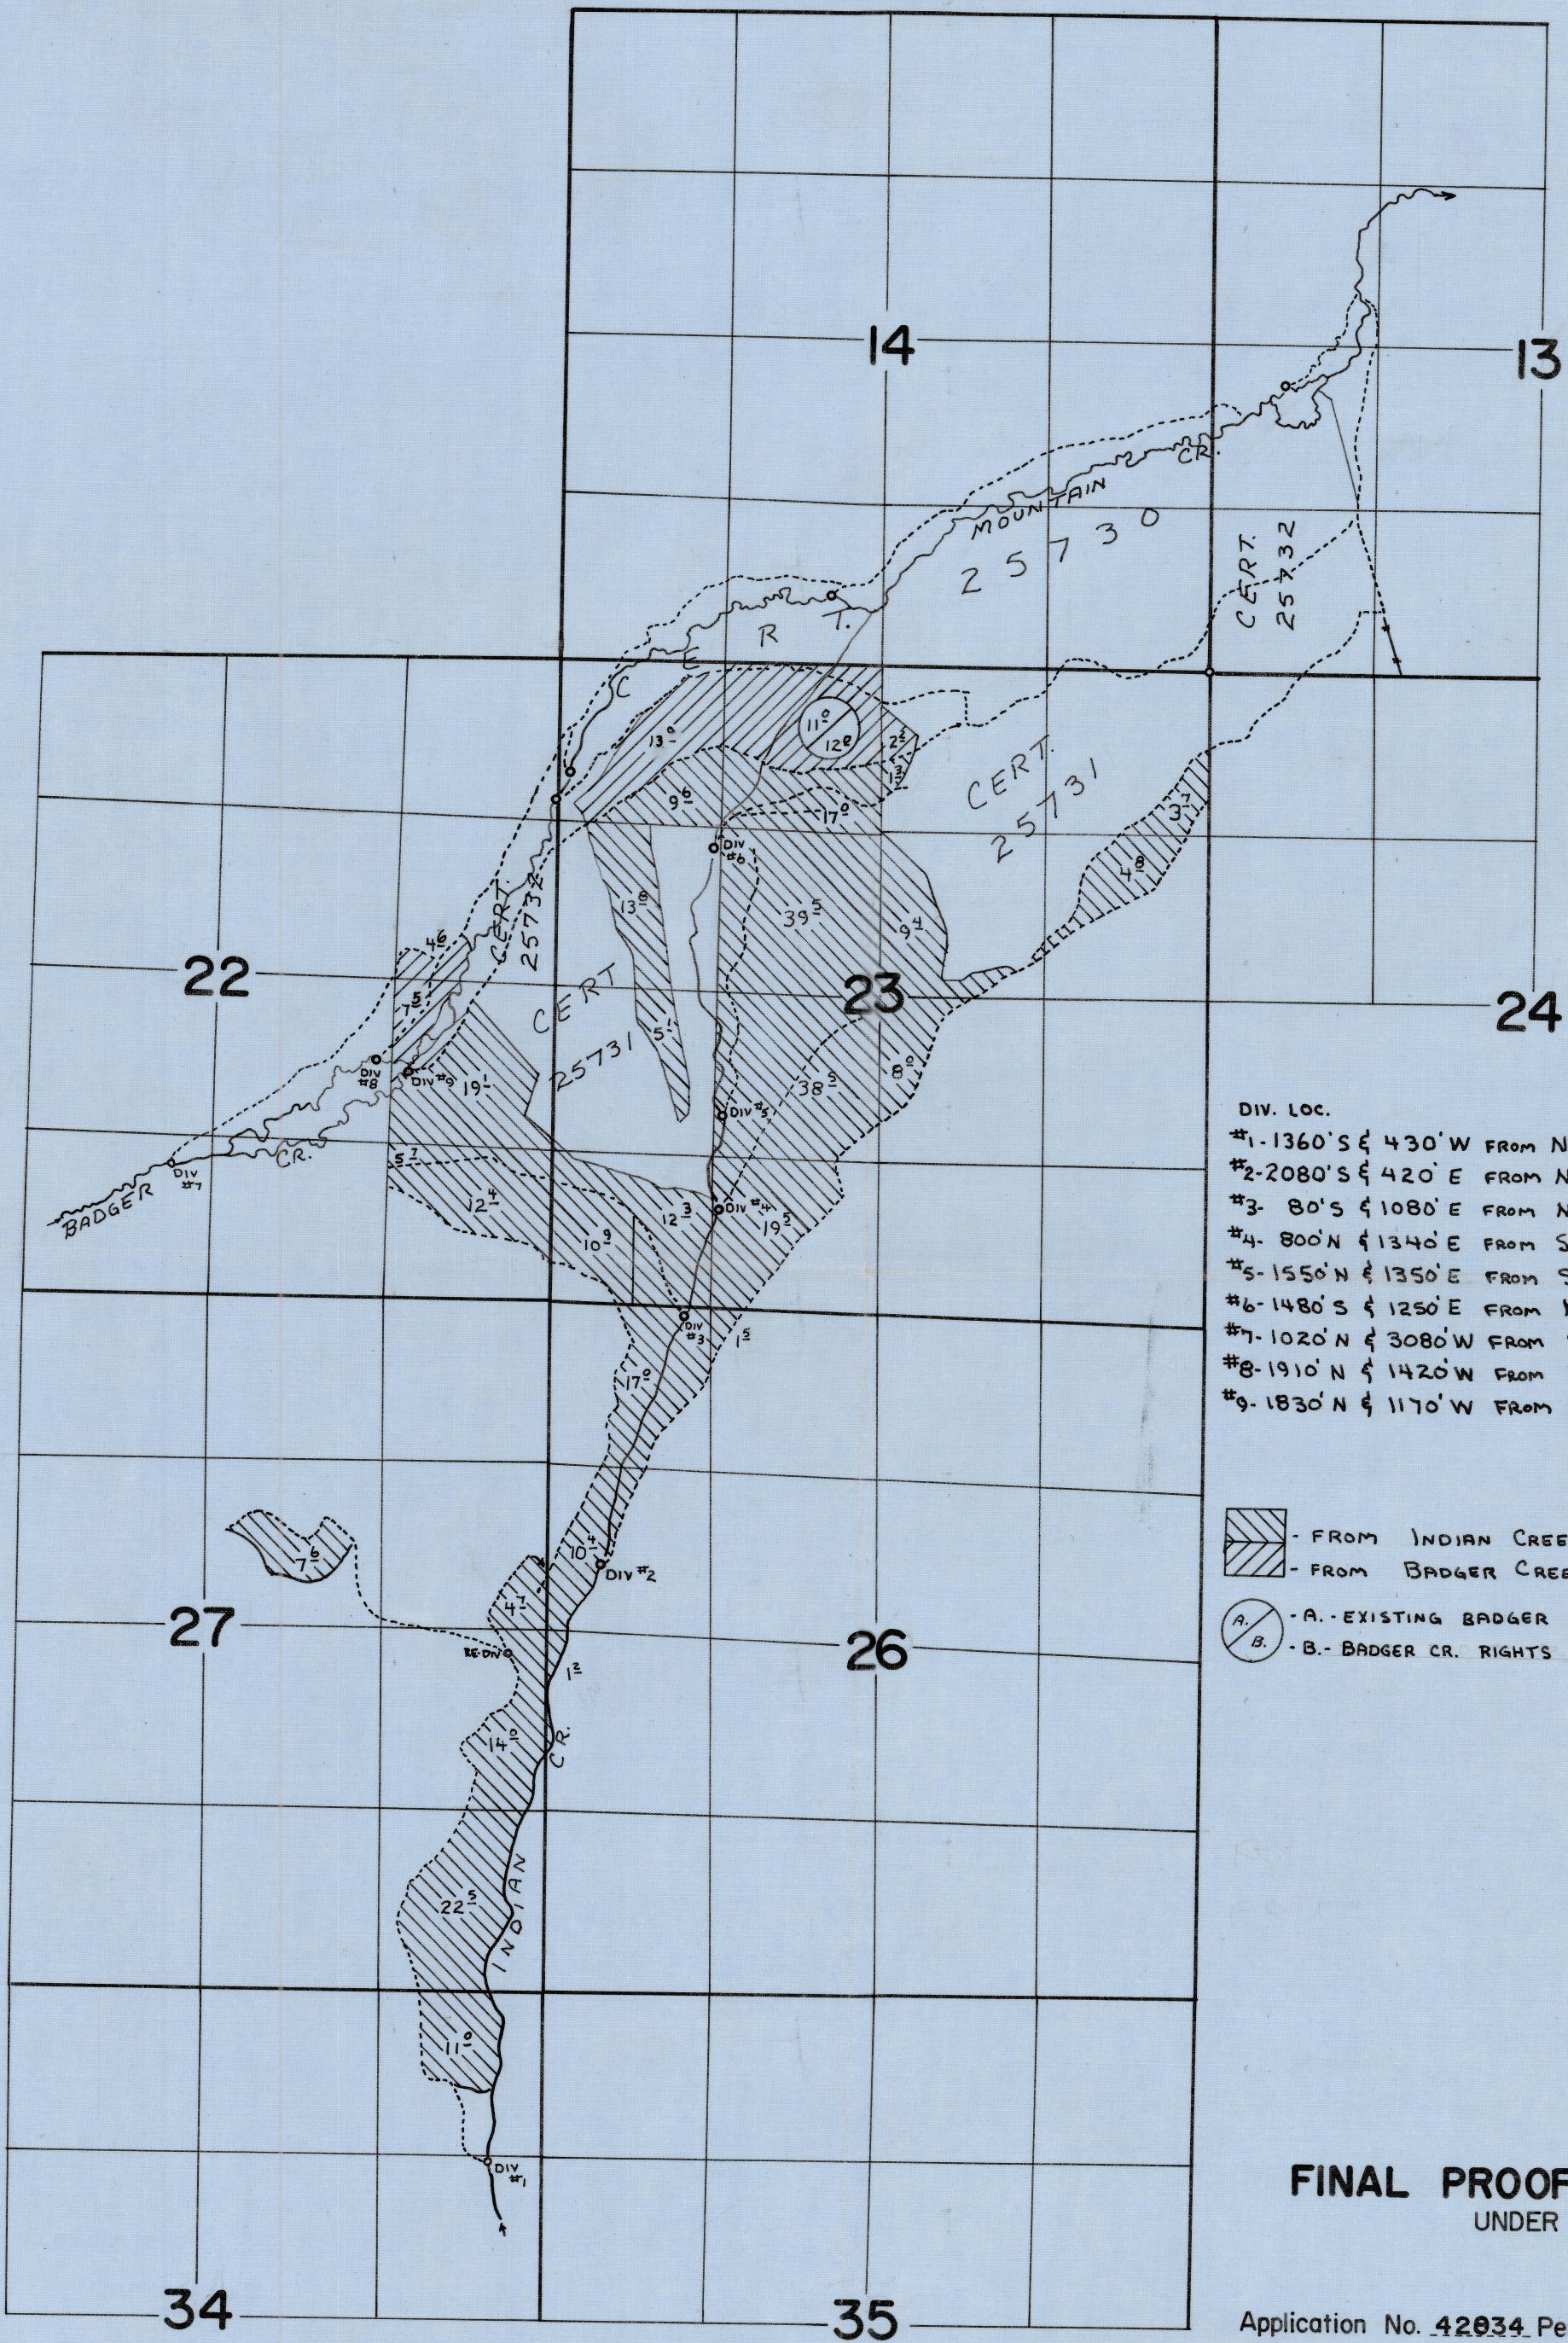

- FROM INDIAN CREEK
- FROM BADGER CREEK



- A.- EXISTING BADGER CR. RIGHTS
- B.- BADGER CR. RIGHTS (THIS PERMIT)

FINAL PROOF SURVEY
UNDER

Application No. 42034 Permit No. 32015
IN NAME OF

ELMER J. JACKSON

Surveyed June 12, 1975 by L. Tall