



GROUND WATER APPLICATION MAP

SECTION 17, MAP 2S 2W TAX LOT 1600
WASHINGTON COUNTY, OREGON

PREPARED FOR:
JON BARRY KRAXBERGER LIVING TRUST
PO BOX 2073
BEAVERTON OR 97075

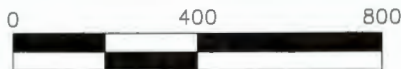

1 inch = 400 ft.

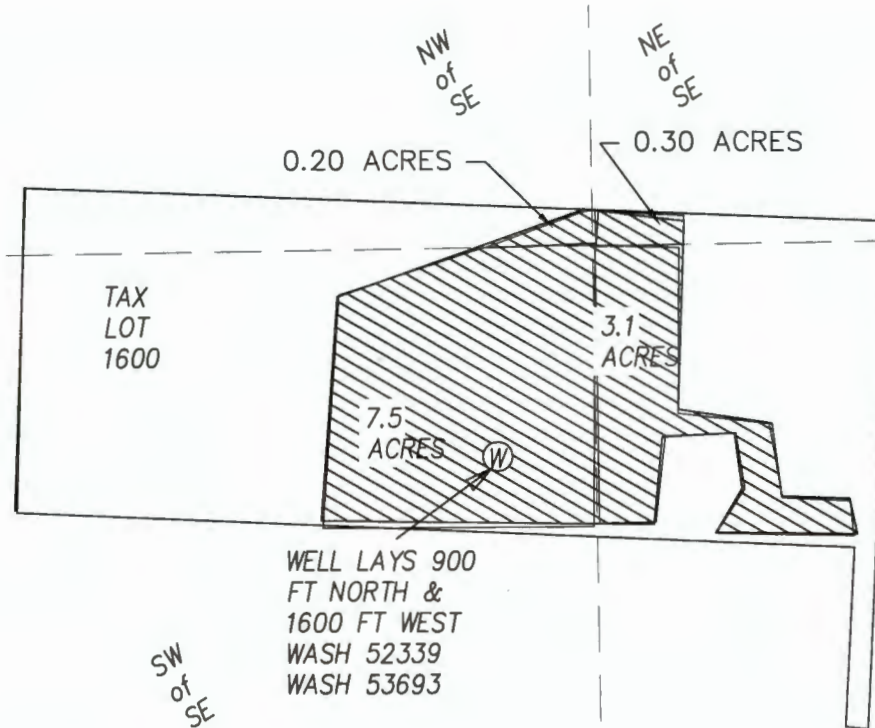

MAP BASES: WASHINGTON COUNTY TAX MAP T2S
R2W SEC. 17
2017 AERIAL PHOTO FROM GOOGLE EARTH.

THIS MAP WAS PREPARED FOR THE PURPOSE OF
IDENTIFYING THE LOCATION OF A WATER RIGHT
ONLY AND IS NOT INTENDED TO PROVIDE LEGAL
DIMENSIONS OR LOCATION OF PROPERTY
OWNERSHIP LINES.

RECEIVED

MAR 27 2019

OWRD

SUPERSEDING

17 16
20 21
SECTION
CORNER

Stuntzner
Engineering
& Forestry, LLC

Project: 317-059
By: JEFFREY KEE
Date: DEC 15, 2017
Revised by WLF, CWRE
on 11-19-18

GROUND WATER APPLICATION MAP

SECTION 17, MAP 2S 2W TAX LOT 1600
WASHINGTON COUNTY, OREGON

RECEIVED


JAN 05 2018

OWRD

PREPARED FOR:
JON BARRY KRAXBERGER LIVING TRUST
PO BOX 2073
BEAVERTON OR 97075



1 inch = 400 ft.

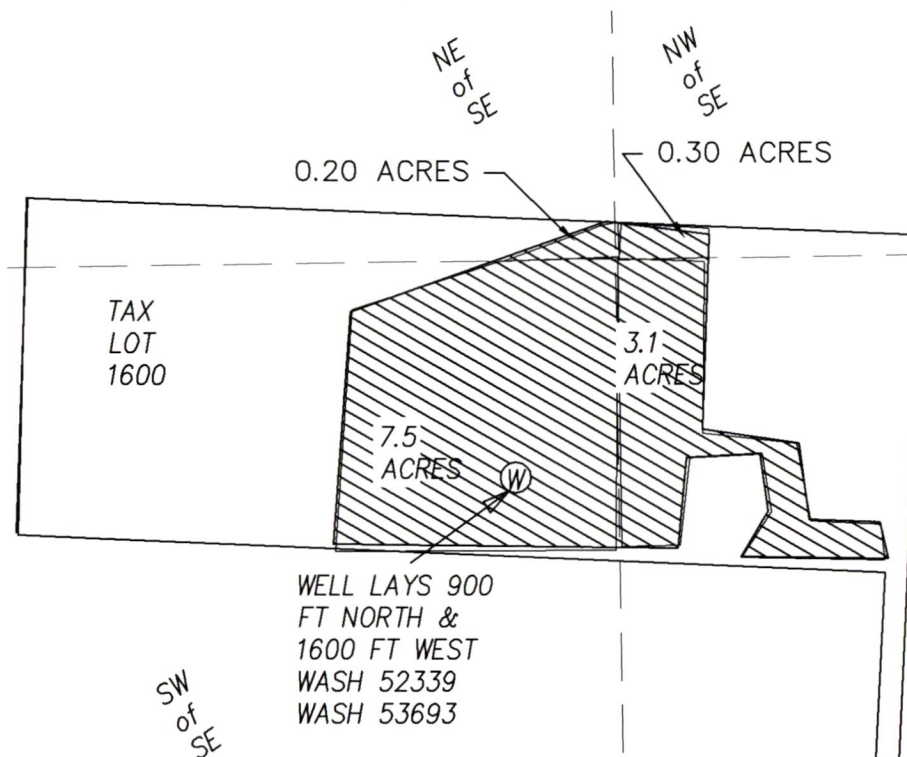

SE of SE

SW of SE

WELL LAYS 900
FT NORTH &
1600 FT WEST
WASH 52339
WASH 53693

TAX
LOT
1600

17 16
20 21

SECTION
CORNER

MAP BASES: WASHINGTON COUNTY TAX MAP T2S
R2W SEC. 17
2017 AERIAL PHOTO FROM GOOGLE EARTH.

THIS MAP WAS PREPARED FOR THE PURPOSE OF
IDENTIFYING THE LOCATION OF A WATER RIGHT
ONLY AND IS NOT INTENDED TO PROVIDE LEGAL
DIMENSIONS OR LOCATION OF PROPERTY
OWNERSHIP LINES.



Project: 317-059
By: JEFFREY KEE
Date: DEC 15, 2017