


Margo Lucas

1" = 1320'

Tax Lot:

Township 9 South, Range 4 West, Section 15, Tax Lot 607 & 608

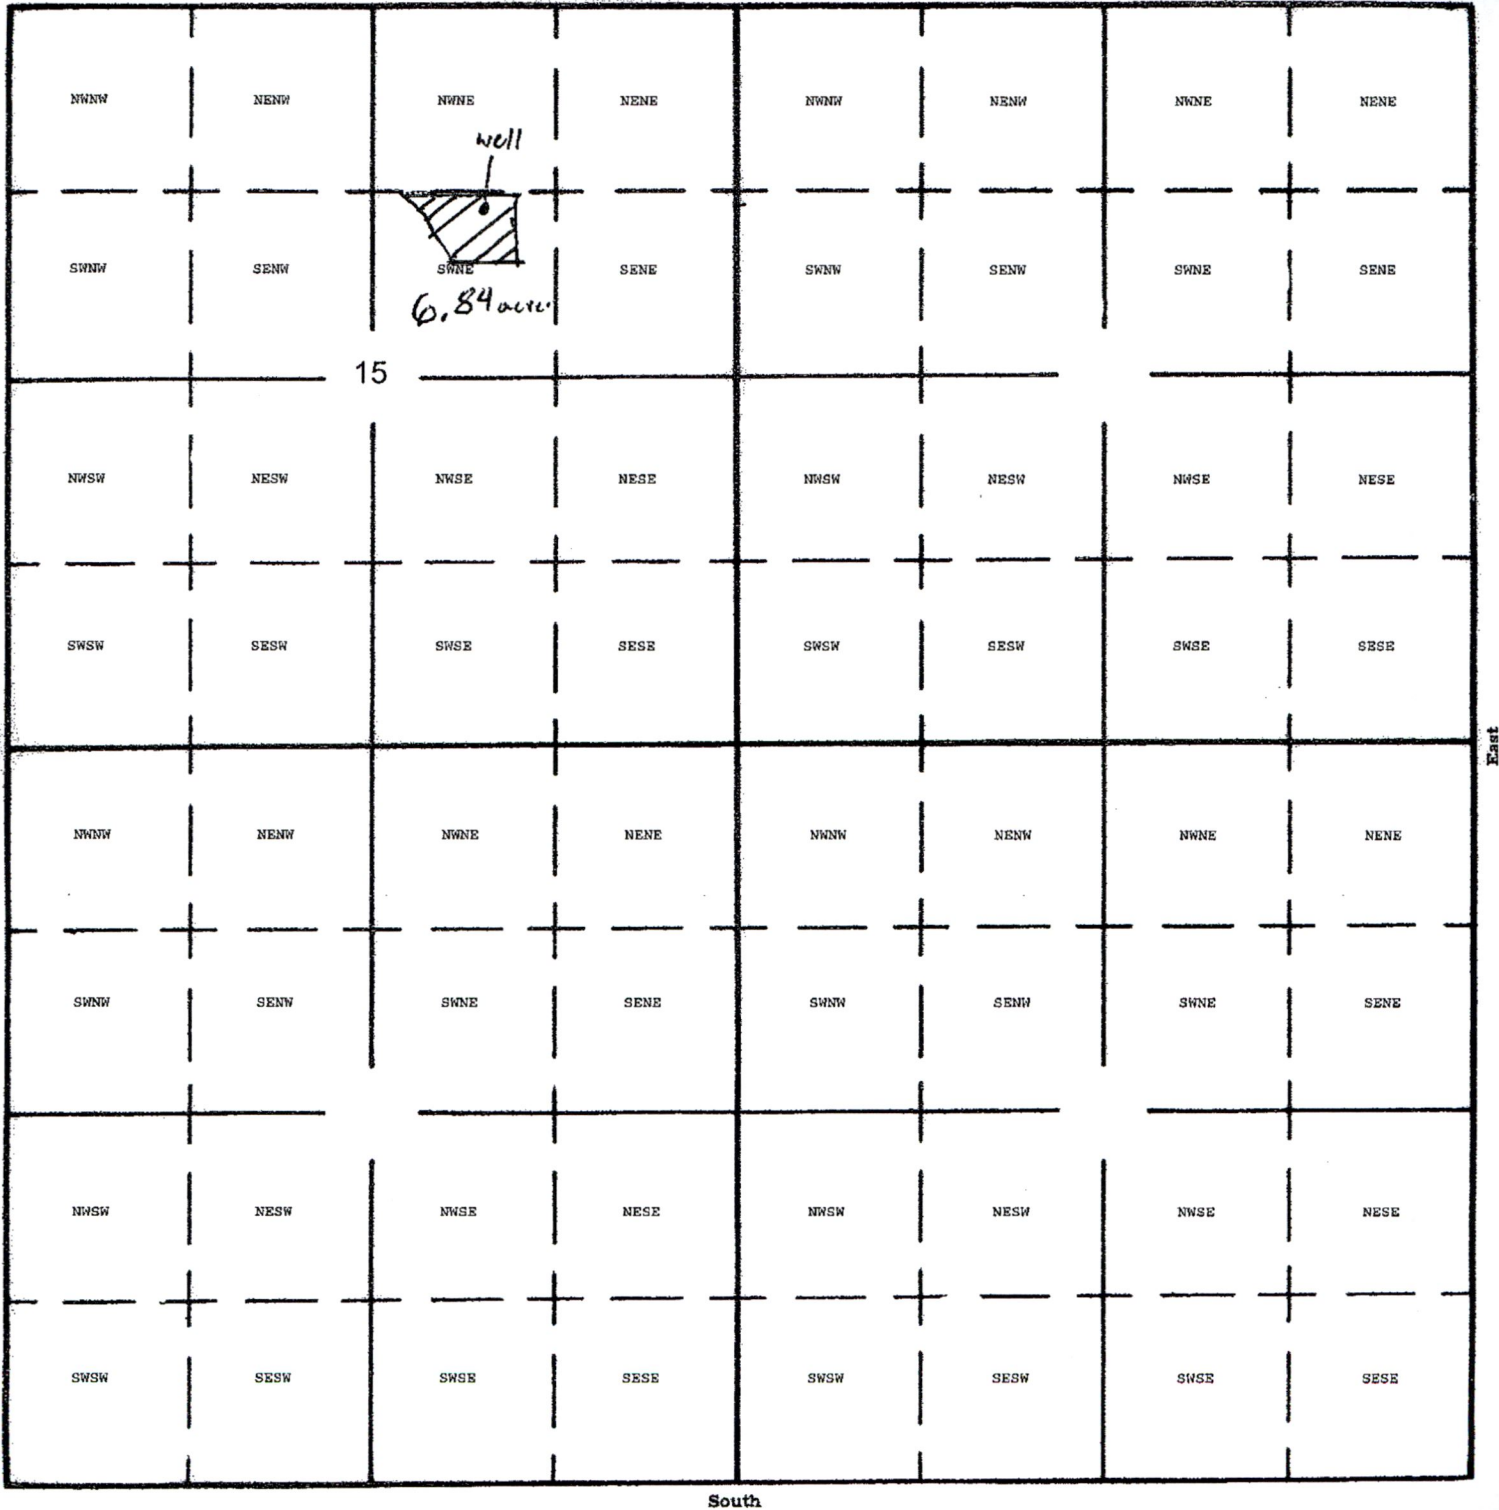

Well 1 (POLK 3884): 1390' Feet South and 1785' Feet West from NE Corner Section 15

RECEIVED

JAN 24 2018

G-18599

OWRD

IMPORTANT
This Map for Assessment
and Taxation Purposes
ONLY

**SEC.15 T9S R4W WM
POLK COUNTY**

9.4.15

See Map 9.4.10 Scale 1" = 400'

10 11
15 14

RECEIVED
JAN 24 2018

OWPRD

Cancelled No.

501
502
505
506
507

See Map 9.4.14


See Map 9.4.23

Q6/02/17

See Map 9.4.22

9.4.15

6-18589

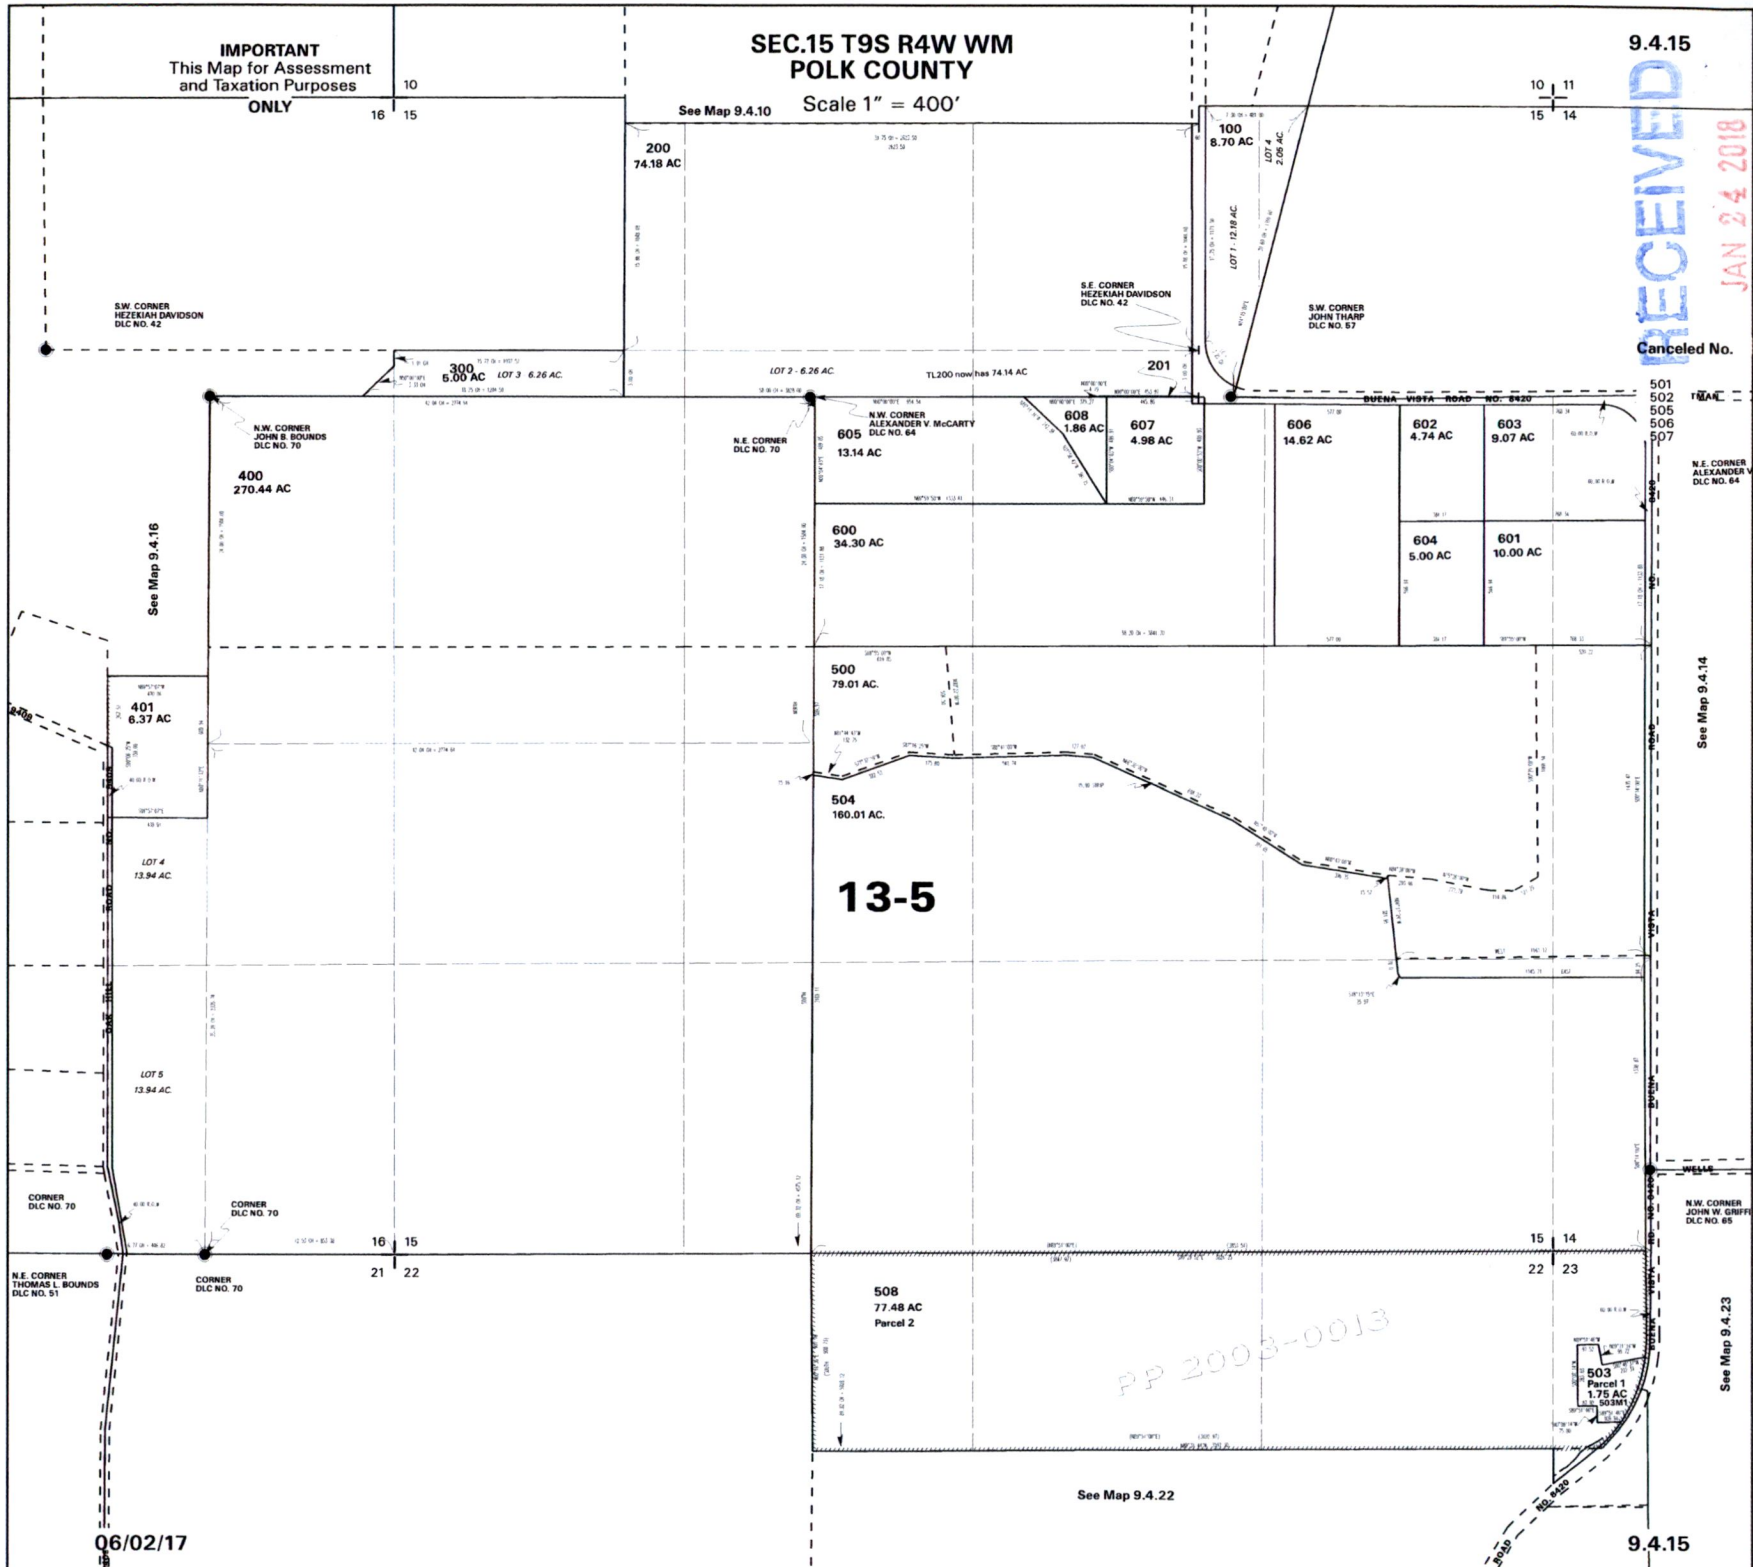

13-5

PP 2003-0013

503
Parcel 1
1.75 AC
DLC NO. 65

508
77.48 AC
Parcel 2

400
270.44 AC

401
6.37 AC

LOT 4
13.94 AC

LOT 5
13.94 AC

500
79.01 AC

504
160.01 AC

600
34.30 AC

605
13.14 AC

607
4.98 AC

606
14.62 AC

602
4.74 AC

603
9.07 AC

604
5.00 AC

601
10.00 AC

808
1.86 AC

100
8.70 AC

LOT 1 - 12.19 AC

LOT 4
2.08 AC

S.W. CORNER
HEZEKIAH DAVIDSON
DLC NO. 42

S.E. CORNER
HEZEKIAH DAVIDSON
DLC NO. 42

S.W. CORNER
JOHN THARP
DLC NO. 57

N.W. CORNER
JOHN B. BOUNDS
DLC NO. 70

N.E. CORNER
DLC NO. 70

N.W. CORNER
ALEXANDER V. McCARTY
DLC NO. 64

N.E. CORNER
ALEXANDER V.
DLC NO. 64

N.E. CORNER
THOMAS L. BOUNDS
DLC NO. 51

CORNER
DLC NO. 70

CORNER
DLC NO. 70

N.W. CORNER
JOHN W. GRIFF
DLC NO. 65

10
16 15

16 15

15 14

21 22

22 23

200
74.18 AC

201

LOT 2 - 6.26 AC


TL200 now has 74.14 AC

BUENA VISTA ROAD NO. 6420

ROAD

ArcGIS Web Map

G-18599

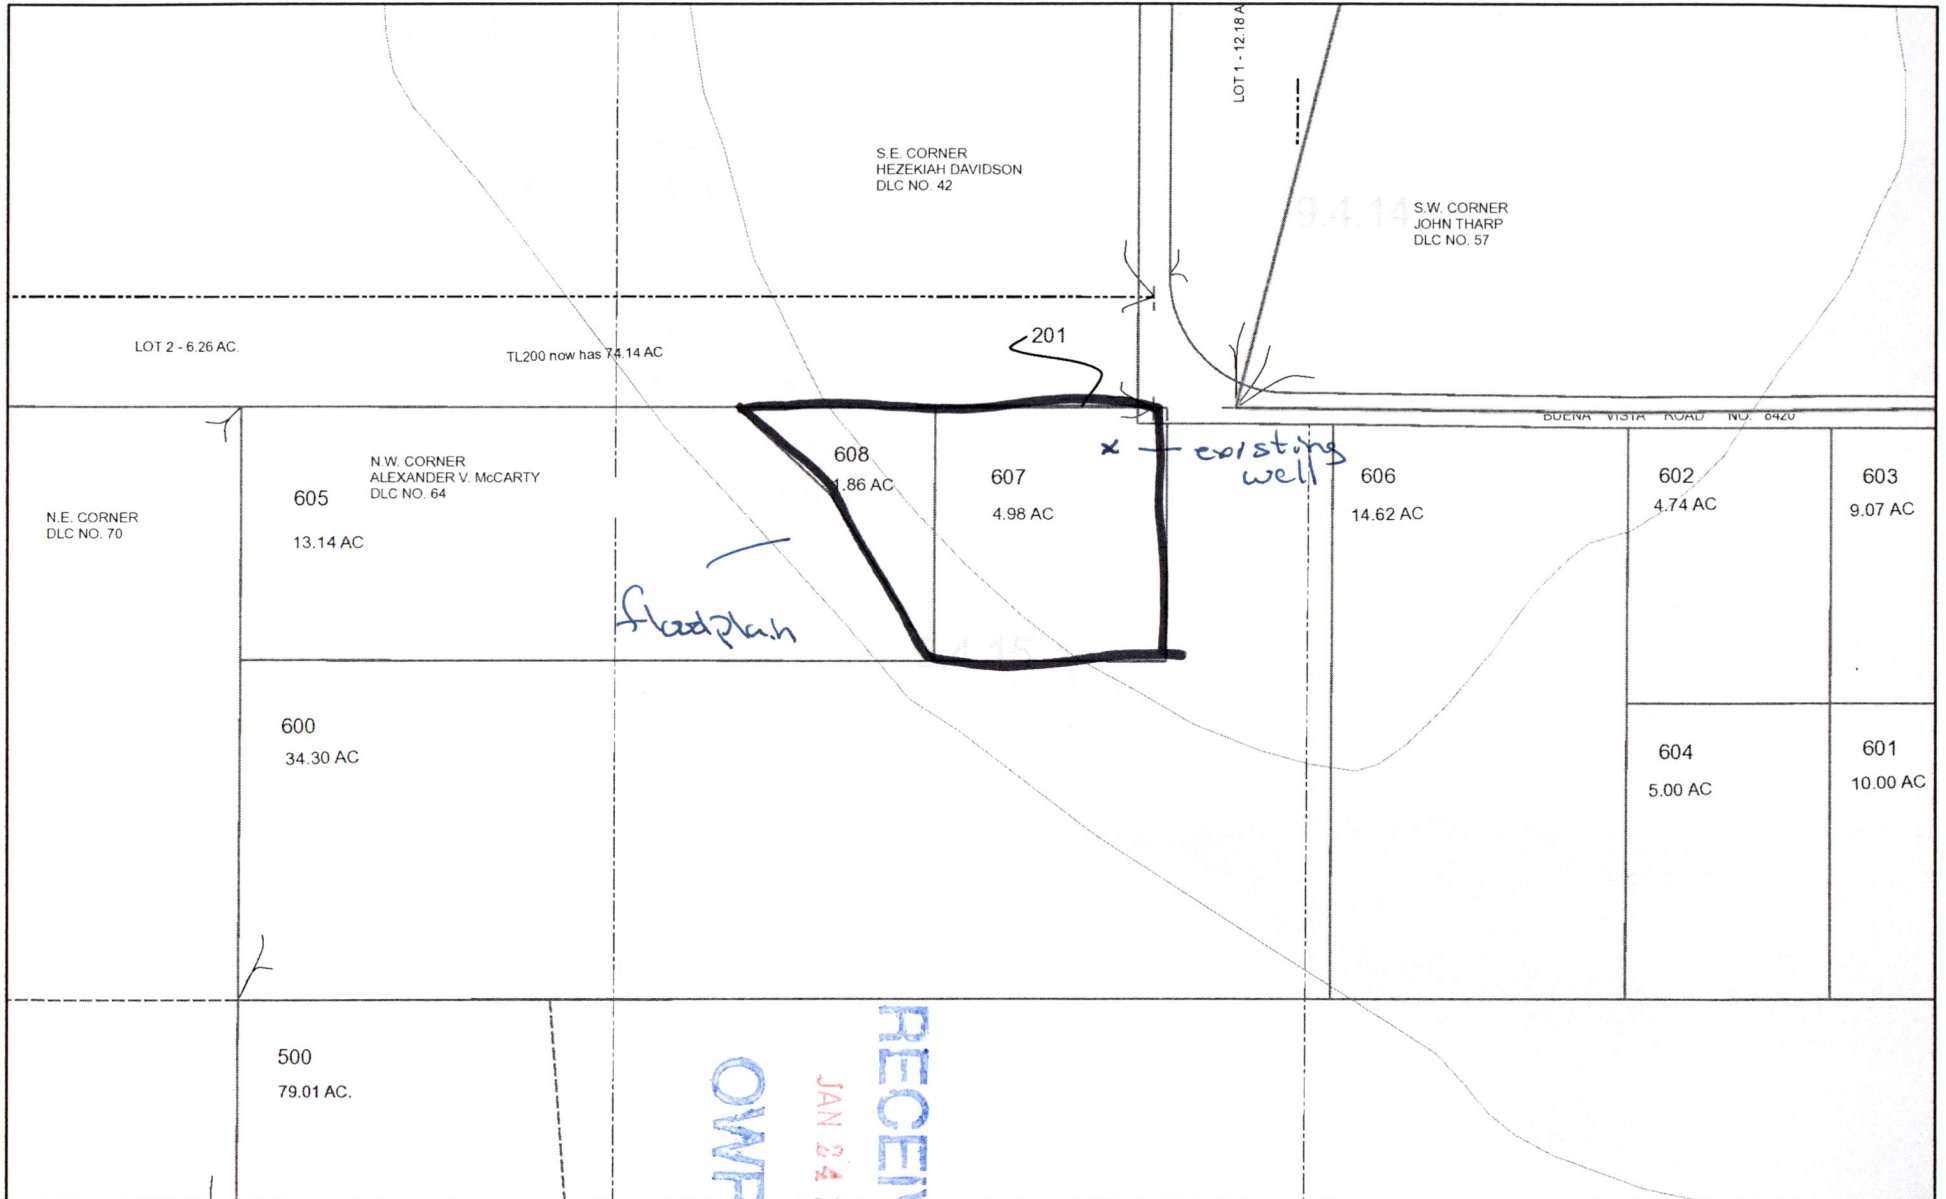

January 24, 2018

RECEIVED
JAN 24 2018
OWFPD

