


T36S R6W Southwest Quarter Section 6

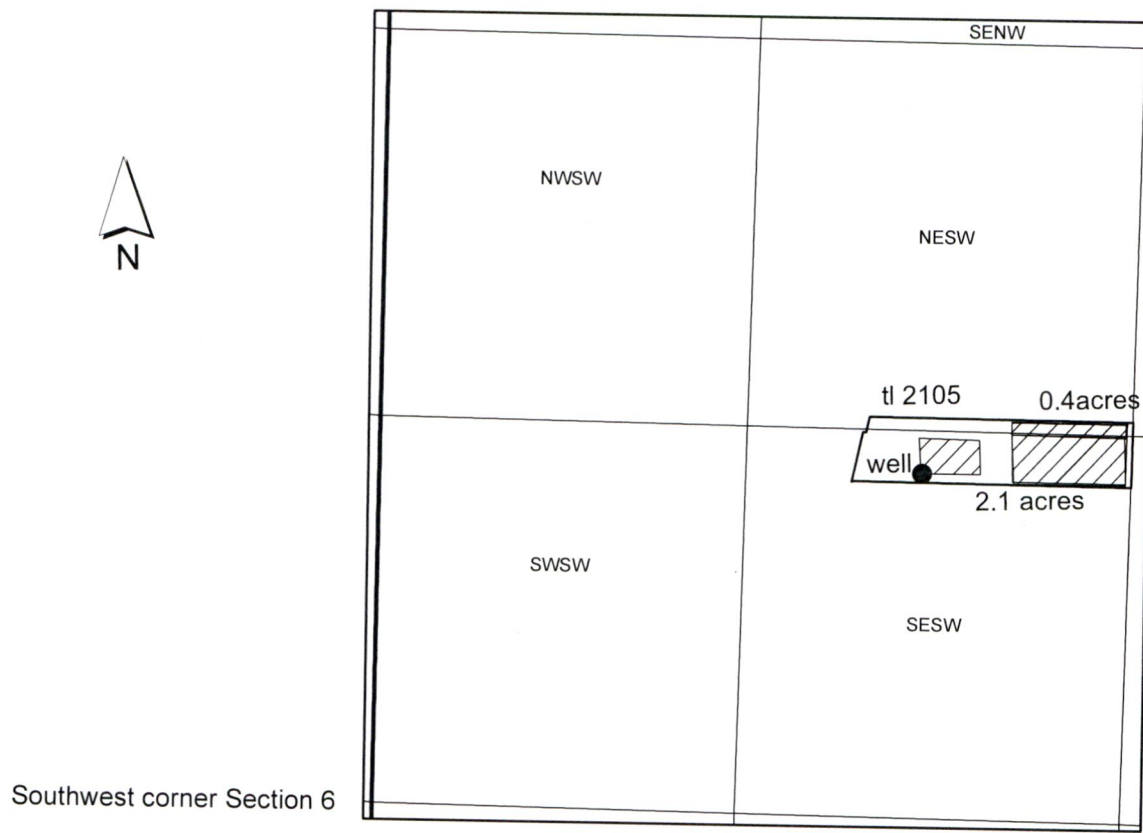

1 inch = 660 feet

The well is located approximately 1181 ft north and 1873 ft east of the southwest corner of Section 6, according to the landowner.

RECEIVED

JAN 18 2017

OWRD