


Township 1 S., Range 22 E., W.M.

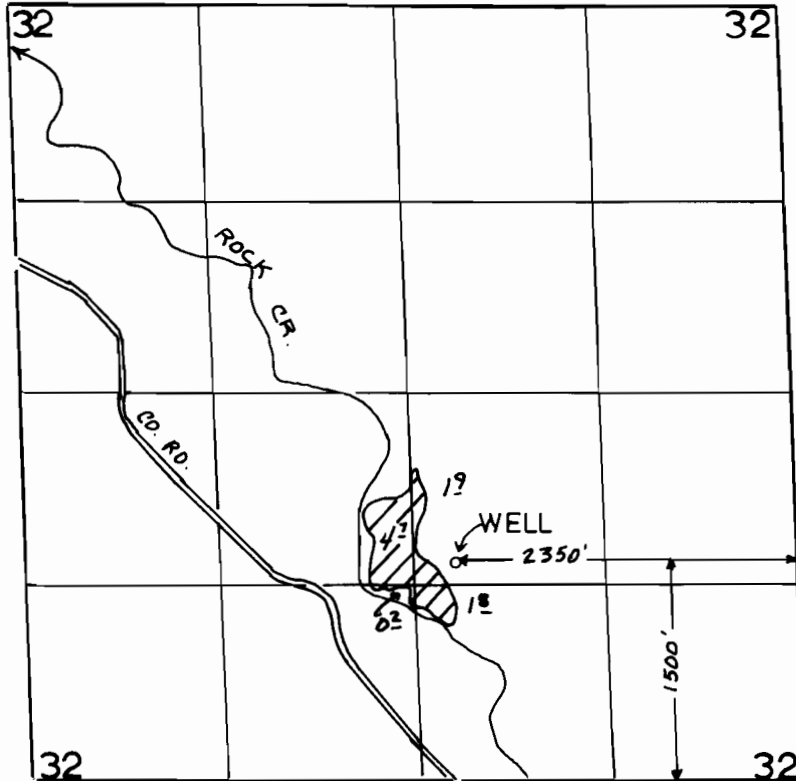

SCALE 1" = 1320'

FINAL PROOF SURVEY
UNDER

Application No. G.115.32 Permit No. G.10.744.
IN NAME OF

.....RICHARD E. HARPER.....

Surveyed 3-14-2000 by J. MILLER....