


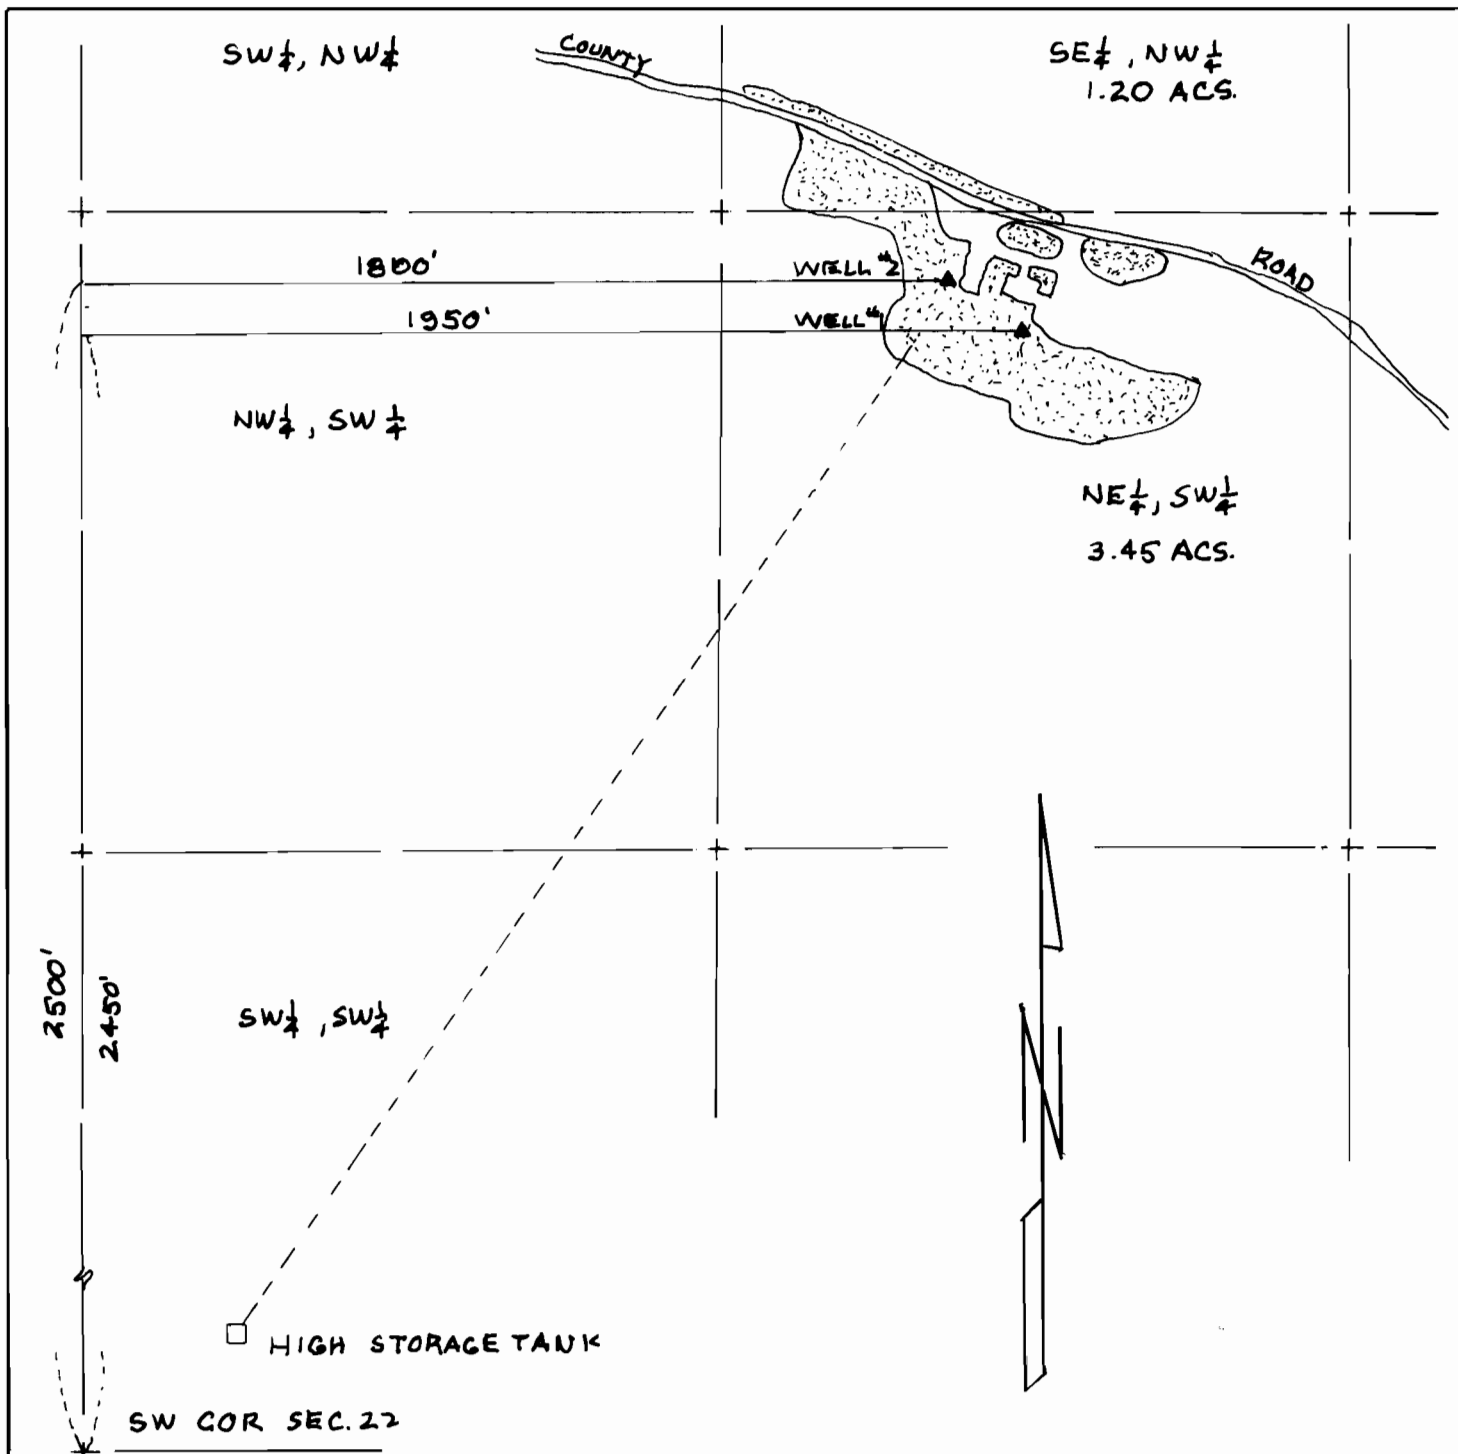

K	KRUMBEIN ENGINEERING LTD. ENGINEERS — SURVEYORS — PLANNERS 361 S.E. Second Pendleton, Oregon	Scale 1" = 400'	Drn By DHK	Drng No 0228A	Revision 1
		Date 6-12-02	Ckd By	Job No 0242	Revision 2
FINAL PROOF SURVEY LORENZEN FARM SE 1/4, NW 1/4 & NE 1/4, SW 1/4 SECTION 22, T.3N., R.31E.W.M UMATILLA COUNTY, OR.				APPLICATION NO. G-11787 PERMIT NO. G-10893	

RENEWS 6/30/03