


# T.8S., R.1W., W.M.

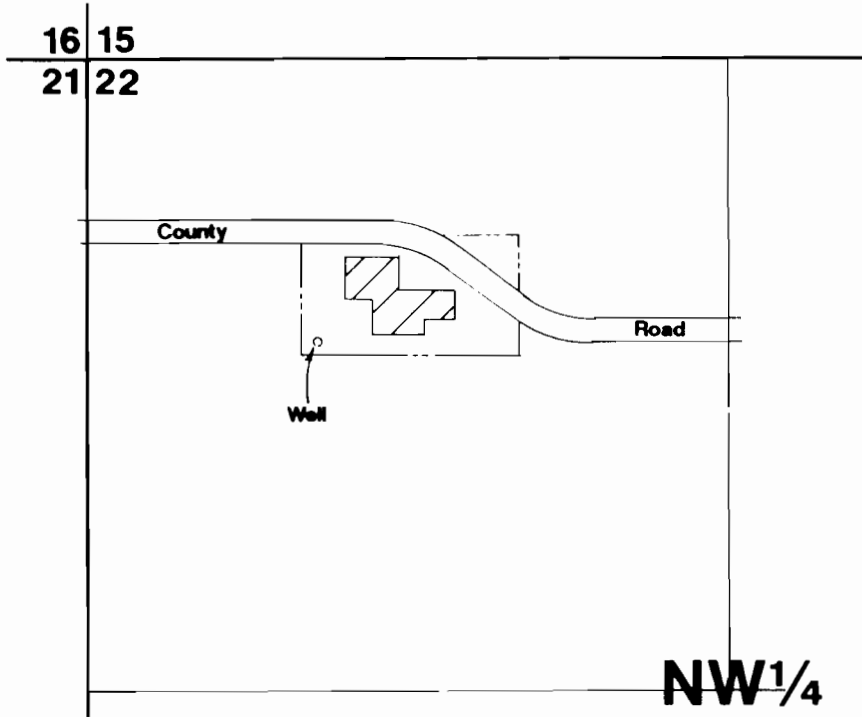

Well located 585'S & 470'E from NW corner Section 22.



## Final Proof Survey

Application # G-11789

Permit # G-10883

In Name Of

### Bruce Packing Co.

Surveyed on November 20, 1992 by Jim Grimm

