


Section 25, T1S, R4W & Section 30, T1S, R3W, W.M.,
Washington County, Oregon

CANCELLATION MAP
Certificate 43715
Metro Regional Government

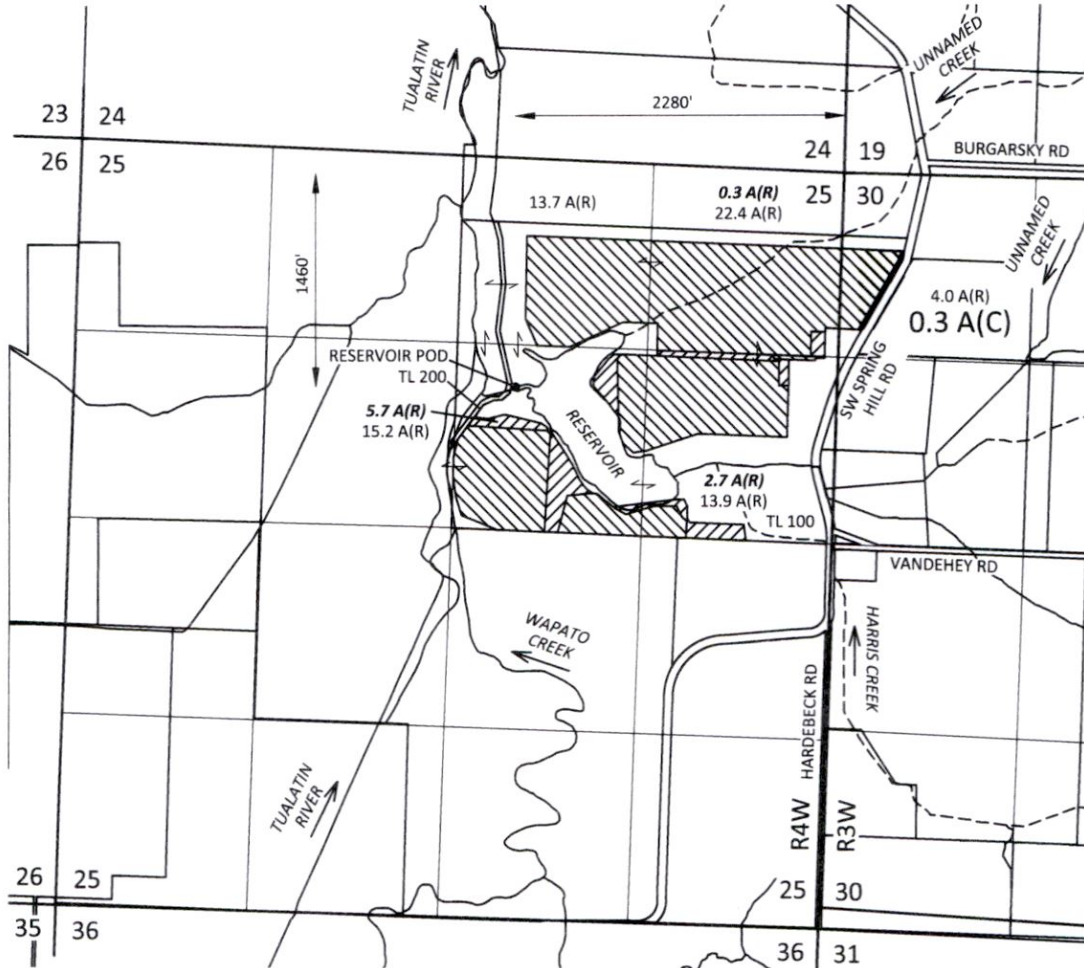

EXPLANATION

REMAINING LANDS (R)

 CERTIFICATE 43715 / PRIORITY: 7/11/1967
PRIMARY IRRIGATION
8.7 ACRES

- xx (A) PRIMARY ACRES
- xx (A) SUPPLEMENTAL ACRES
- POINT OF DIVERSION (POD)

REMAINING LANDS (R)

 CERTIFICATE 43715 / PRIORITY: 7/11/1967
SUPPLEMENTAL IRRIGATION
69.2 ACRES

CANCELED LANDS (C)

 CERTIFICATE 43715 / PRIORITY: 7/11/1967
SUPPLEMENTAL IRRIGATION
0.3 ACRES

RECEIVED

FEB 07 2018

OWRD

December 28, 2017

This map is not intended to provide legal
dimensions or locations of property
ownership lines

Figure 1

SKOOKUM
WATER ASSOCIATES INC

1626 VICTORIAN WAY
EUGENE, OR 97401
(503) 319-8926

