

**STATE OF OREGON
WELL LOCATION MAP**

This map is supplemental to the WATER SUPPLY WELL REPORT

Oregon Water Resources Department

725 Summer St NE, Salem OR 97301
(503)986-0900



LOCATION OF WELL

Latitude: 42.0929401731 Datum: WGS84

Longitude: -123.6064905519

Township/Range/Section/Quarter-Quarter Section

WM 40S 8W 14 NENE

Address of Well:

3827 DICK GEORGE RD CAVE JUNCTION OR 97523


Well Label: L121387

Well Log: JOSE 59780

Printed: September 12, 2016

DISCLAIMER: This map is intended to represent the approximate location of the exempt use well provided by the land owner. It is not intended to be construed as survey accurate in any manner.


Generated by OWRD

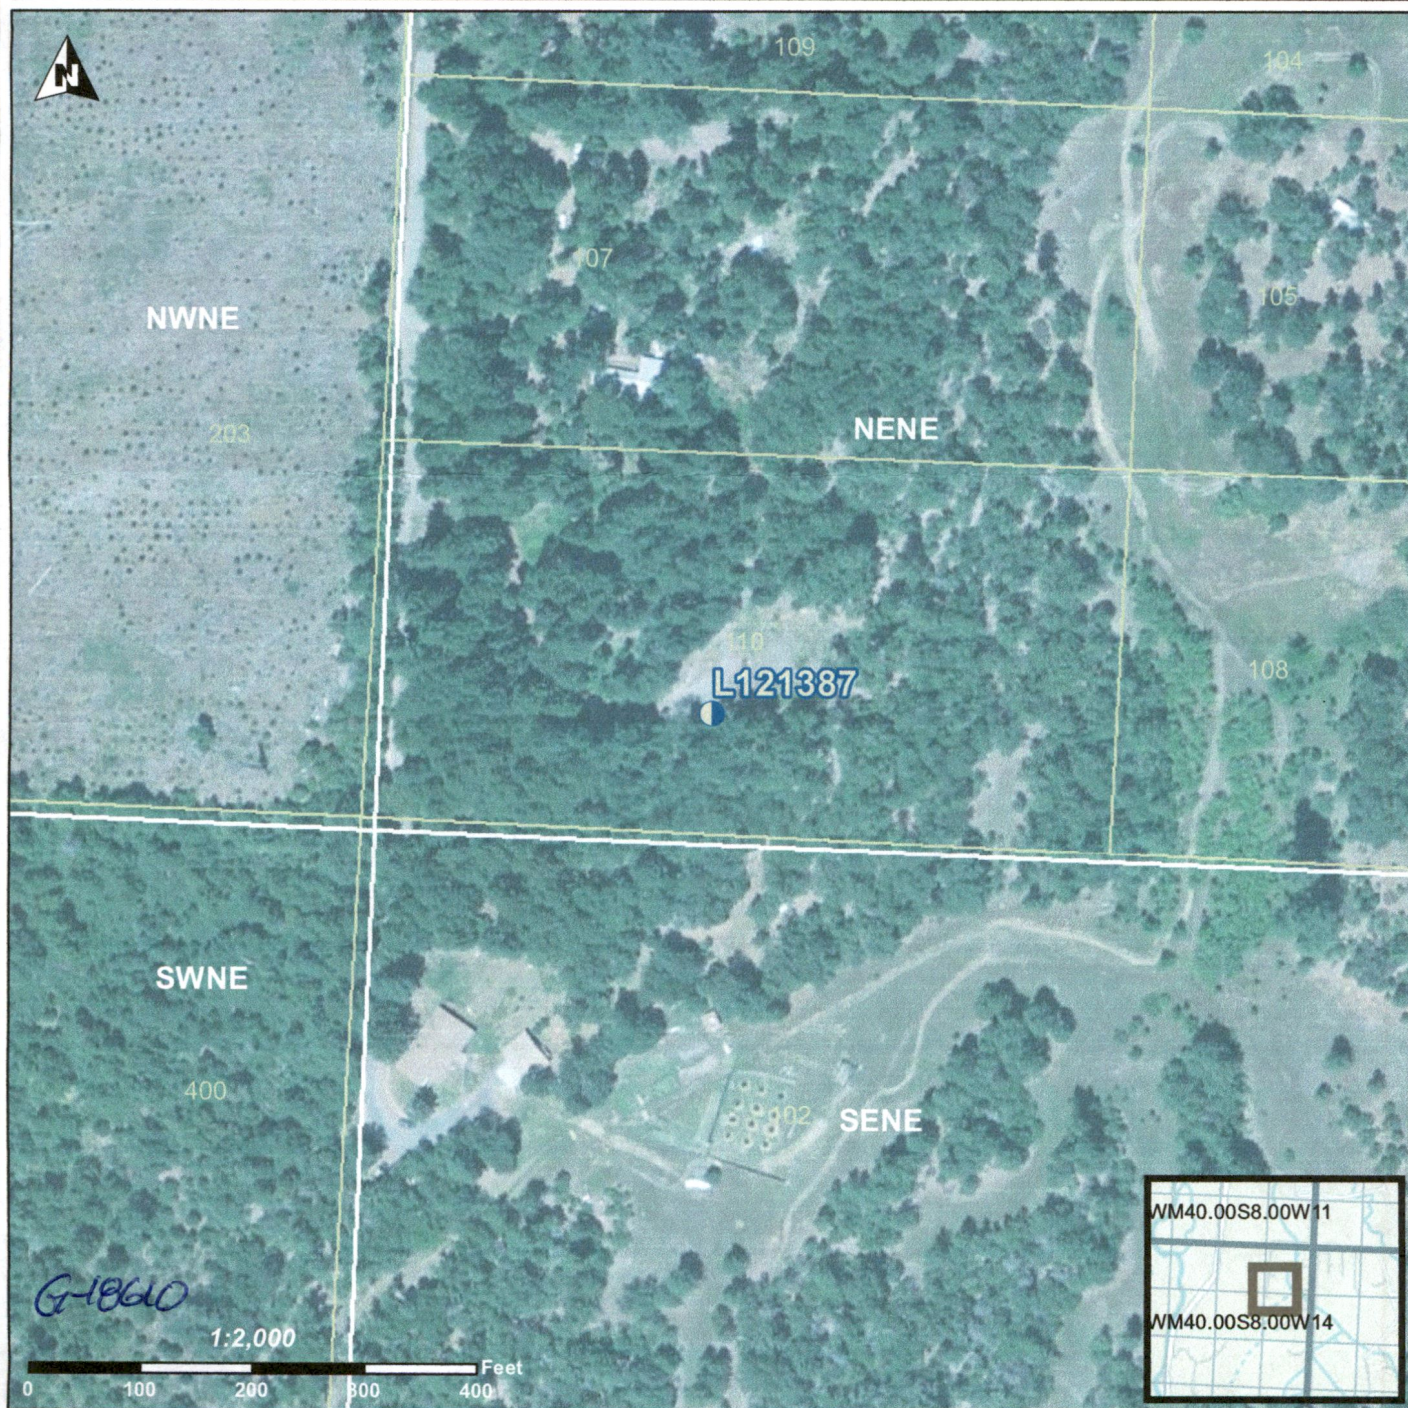

RECEIVED

FEB 15 2018

OWRD

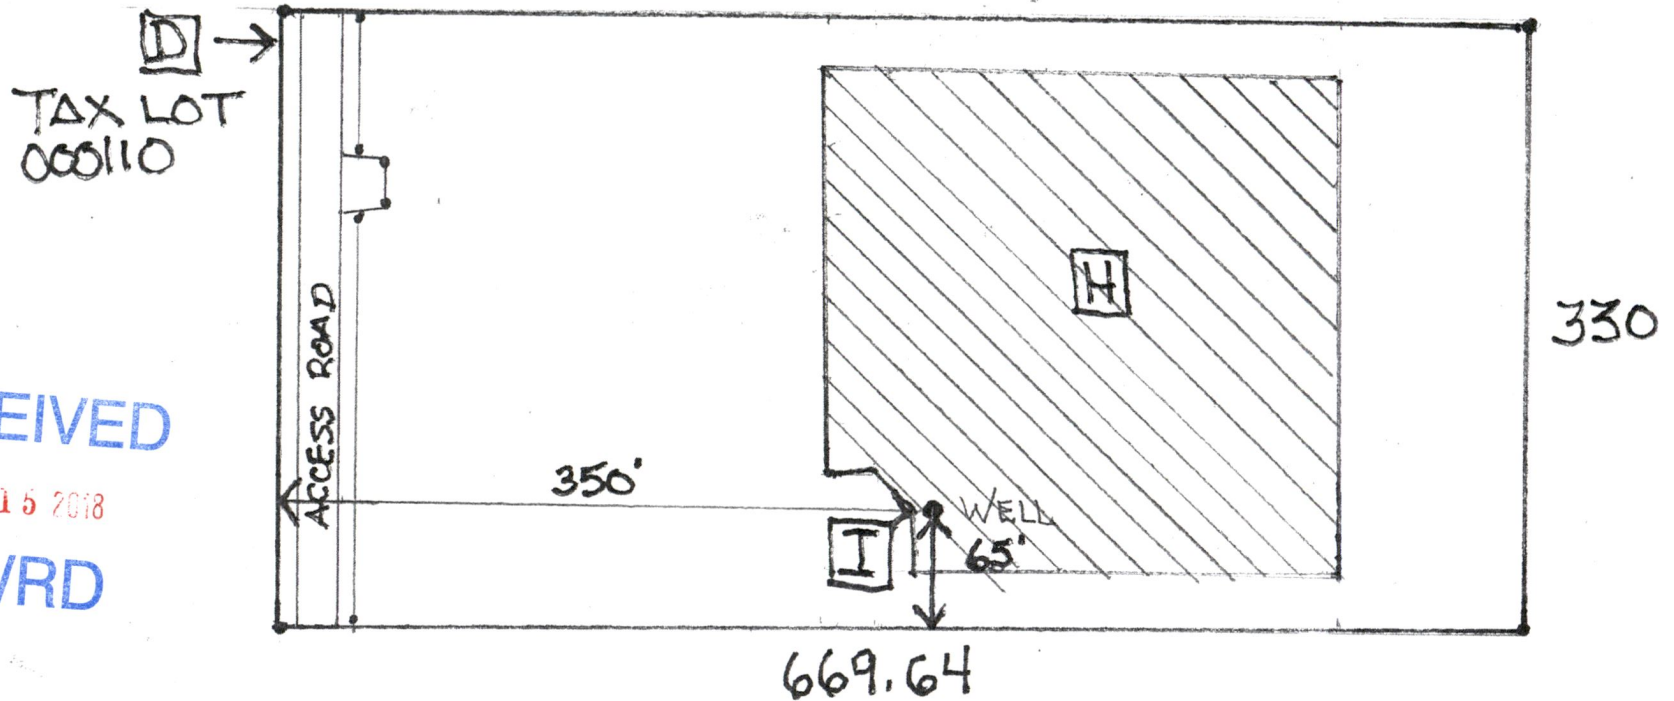

TOWNSHIP: T40S

COUNTY: JOSEPHINE

RANGE/: R08W TAX LOT 110


SECTION 514

MAP: 40081400

LAT: 42° 05' 34" N

LONG: 123° 36' 24" W

SCALE 10=100'-0"

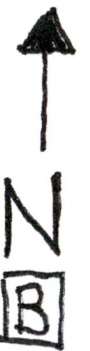


6-18610

OWNER: COLE BRUMFIELD
ADDRESS: 3827 DICK GEORGE ROAD
CAVE JUNCTION, OR 97523

↑ N
SCALE 1-1/2" = 100

RECEIVED
MAY 30 2017

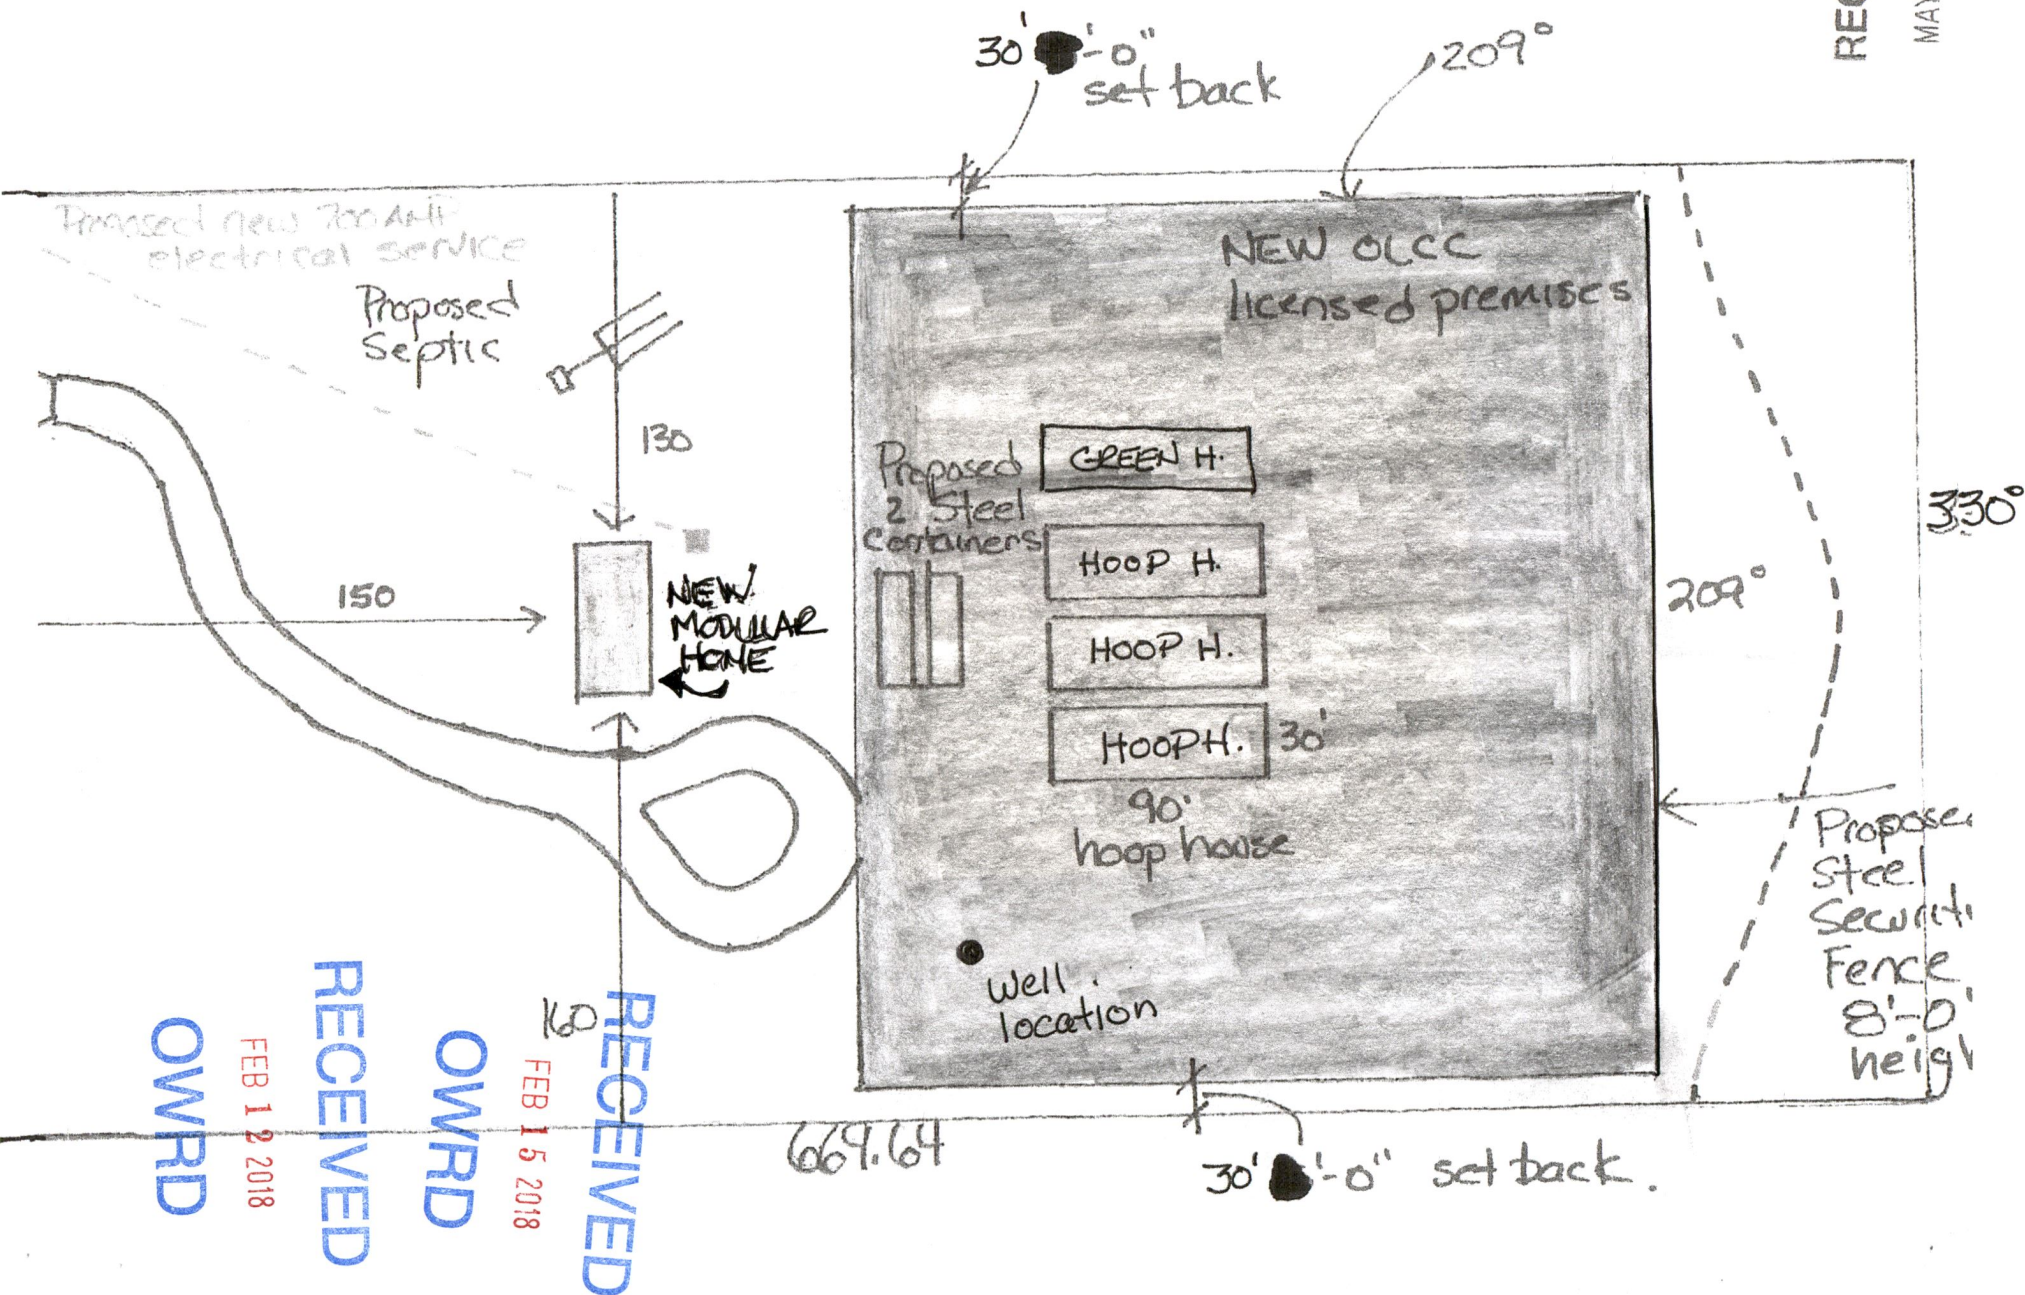


G-18610

OWNER: COLE BRUMFIELD
ADDRESS: 3827 DICK GEORGE ROAD
CAVE JUNCTION, OR 97523

↑ N
SCALE 1-1/2" = 100'

RECEIVED
MAY 8 0 2017

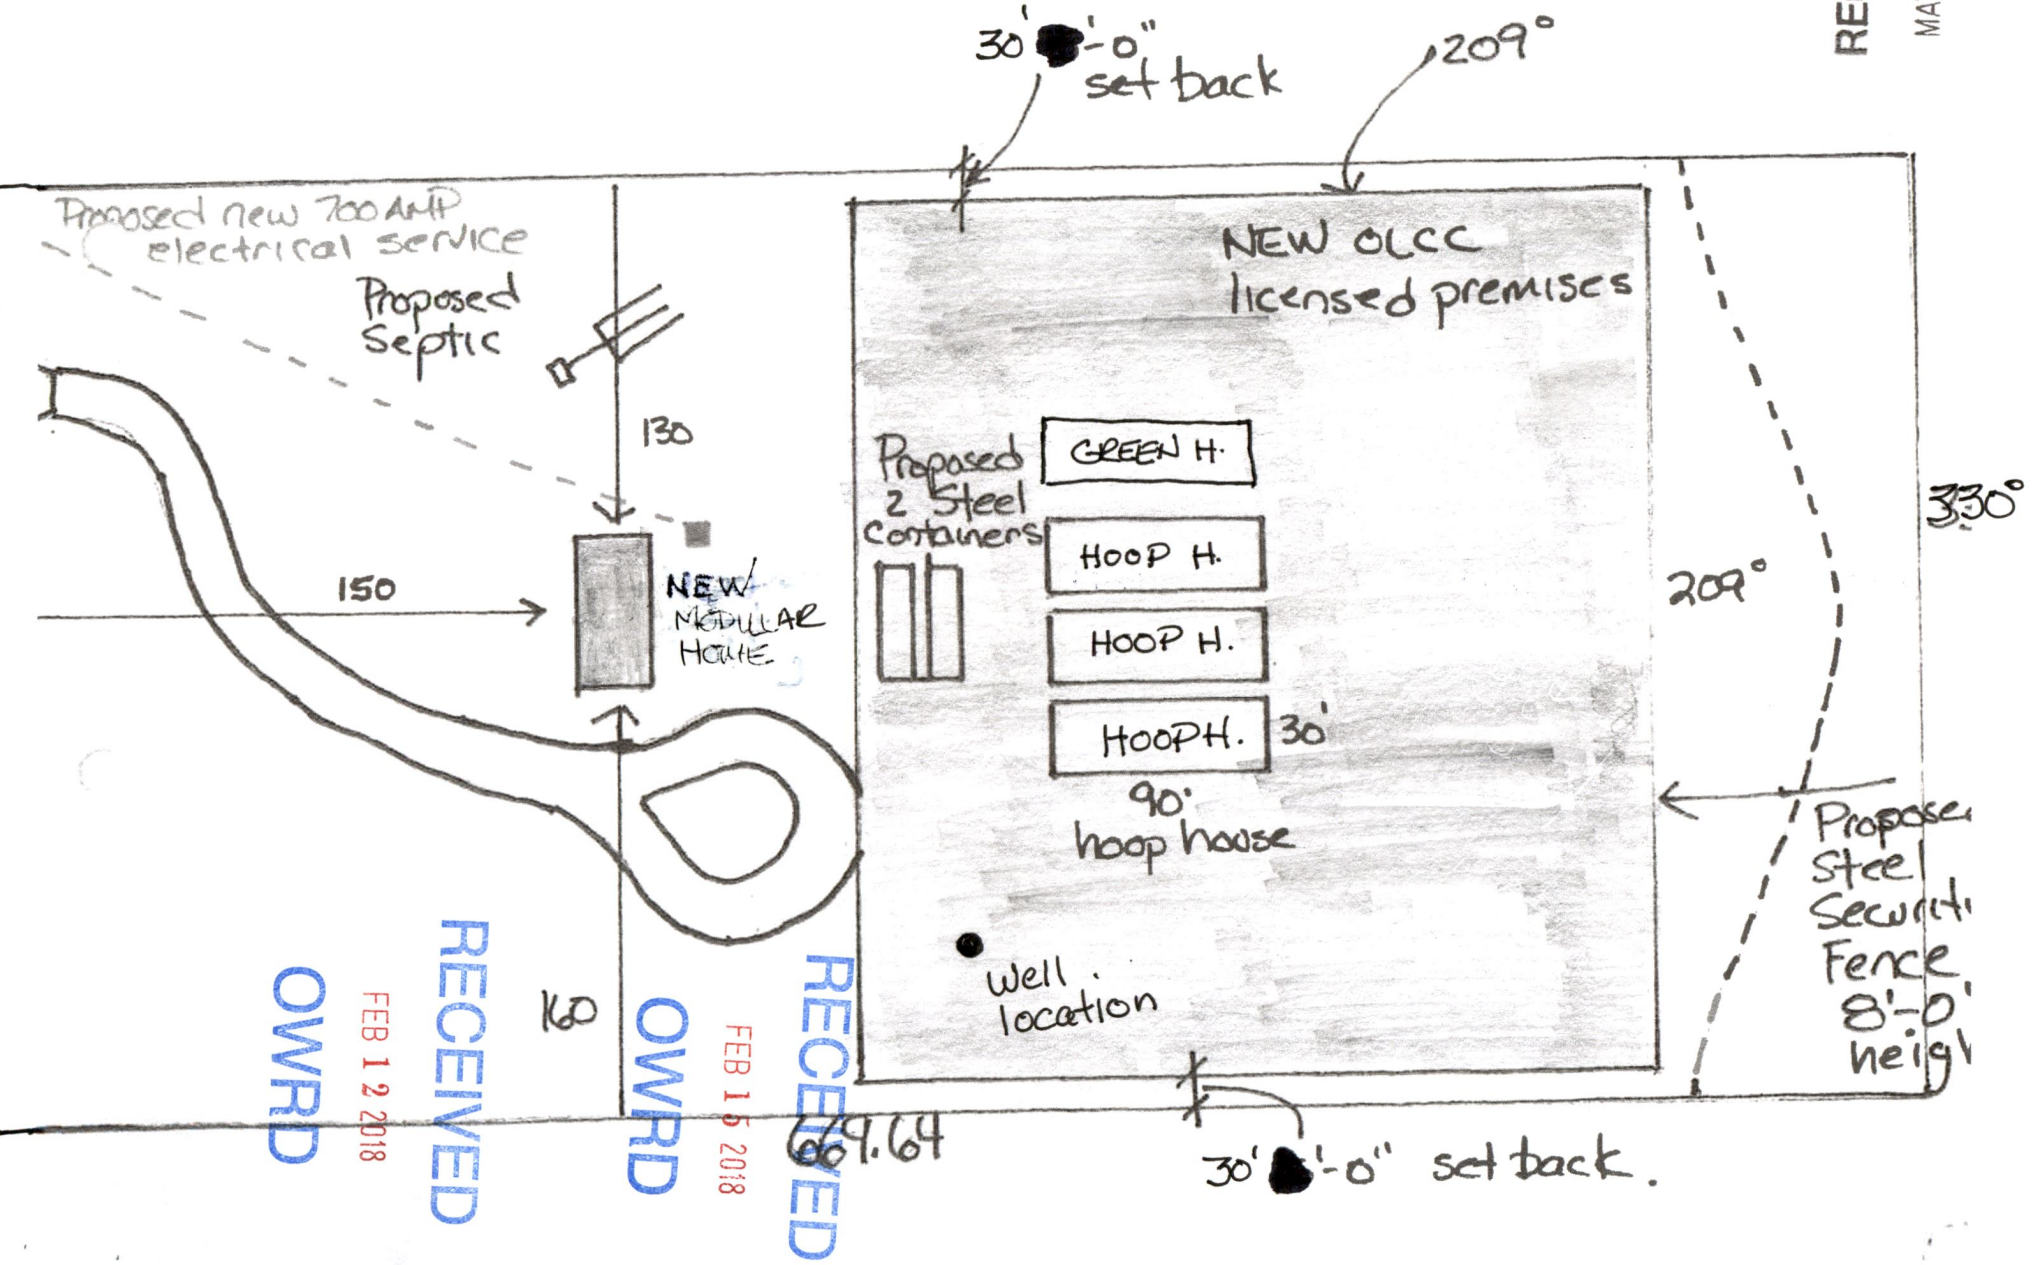

MR. A. CLARK FLEEHAR
P.O. BOX 1365
Grants Pass, Oregon

4-18610

OWRD

FEB 15 2018

RECEIVED

OWRD

FEB 15 2018

RECEIVED

RECEIVED

SEP 28 2017

JO CO - PLANNING

