

08 3W 30

08 3W 30



MARION COUNTY, OREGON

SEC 30 T8S R3W W.M.

SCALE 1" = 400'

LEGEND

LINE TYPES

Taxlot Boundary	Historical Boundary
Road Right-of-Way	Easement
Railroad Right-of-Way	Railroad Centerline
Private Road ROW	Taxcode Line
Subdivision/Plat Bndry	Map Boundary
Waterline - Taxlot Bndry	Waterline - Non Bndry

SYMBOL TYPES

Survey Monument	+ 1/16TH Section Cor
Road Station	⊕ 1/4 Section Cor
DLIC Corner	⊕ 16 15 Section Corner
	⊕ 21 22

NUMBERS

Tax Code Number


000 00 00 0

Acreage 0 25 AC All acres listed are Net Acres, excluding any portions of the taxlot within public ROWs

NOTES

Tick Marks: If a tick mark is indicated on the end of a line, then the dimension goes to the tick mark. This is used when dimensions extend into public right-of-ways.

CANCELLED NUMBERS

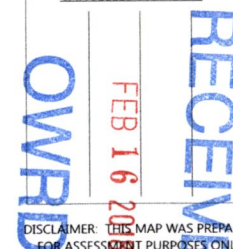

DISCLAIMER: THIS MAP WAS PREPARED FOR ASSESSMENT PURPOSES ONLY



Assessor's Office
Cartography Dept

FOR ADDITIONAL MAPS VISIT OUR WEBSITE AT
www.co.marion.or.us

PLOT DATE: 7/7/2016

08 3W 30


SEE MAP
084W25SEE MAP
083W19CSEE MAP
083W19DSEE MAP
083W20CSEE MAP
083W29BSEE MAP
083W29SEE MAP
084W25DSEE MAP
084W36ASEE MAP
083W31BSEE MAP
083W31ASEE MAP
083W32

08 3W 30


Reservoir

024 00 00 0

NOTE: SEE MAP 8 3W 29
FOR REMAINDER OF PARCEL

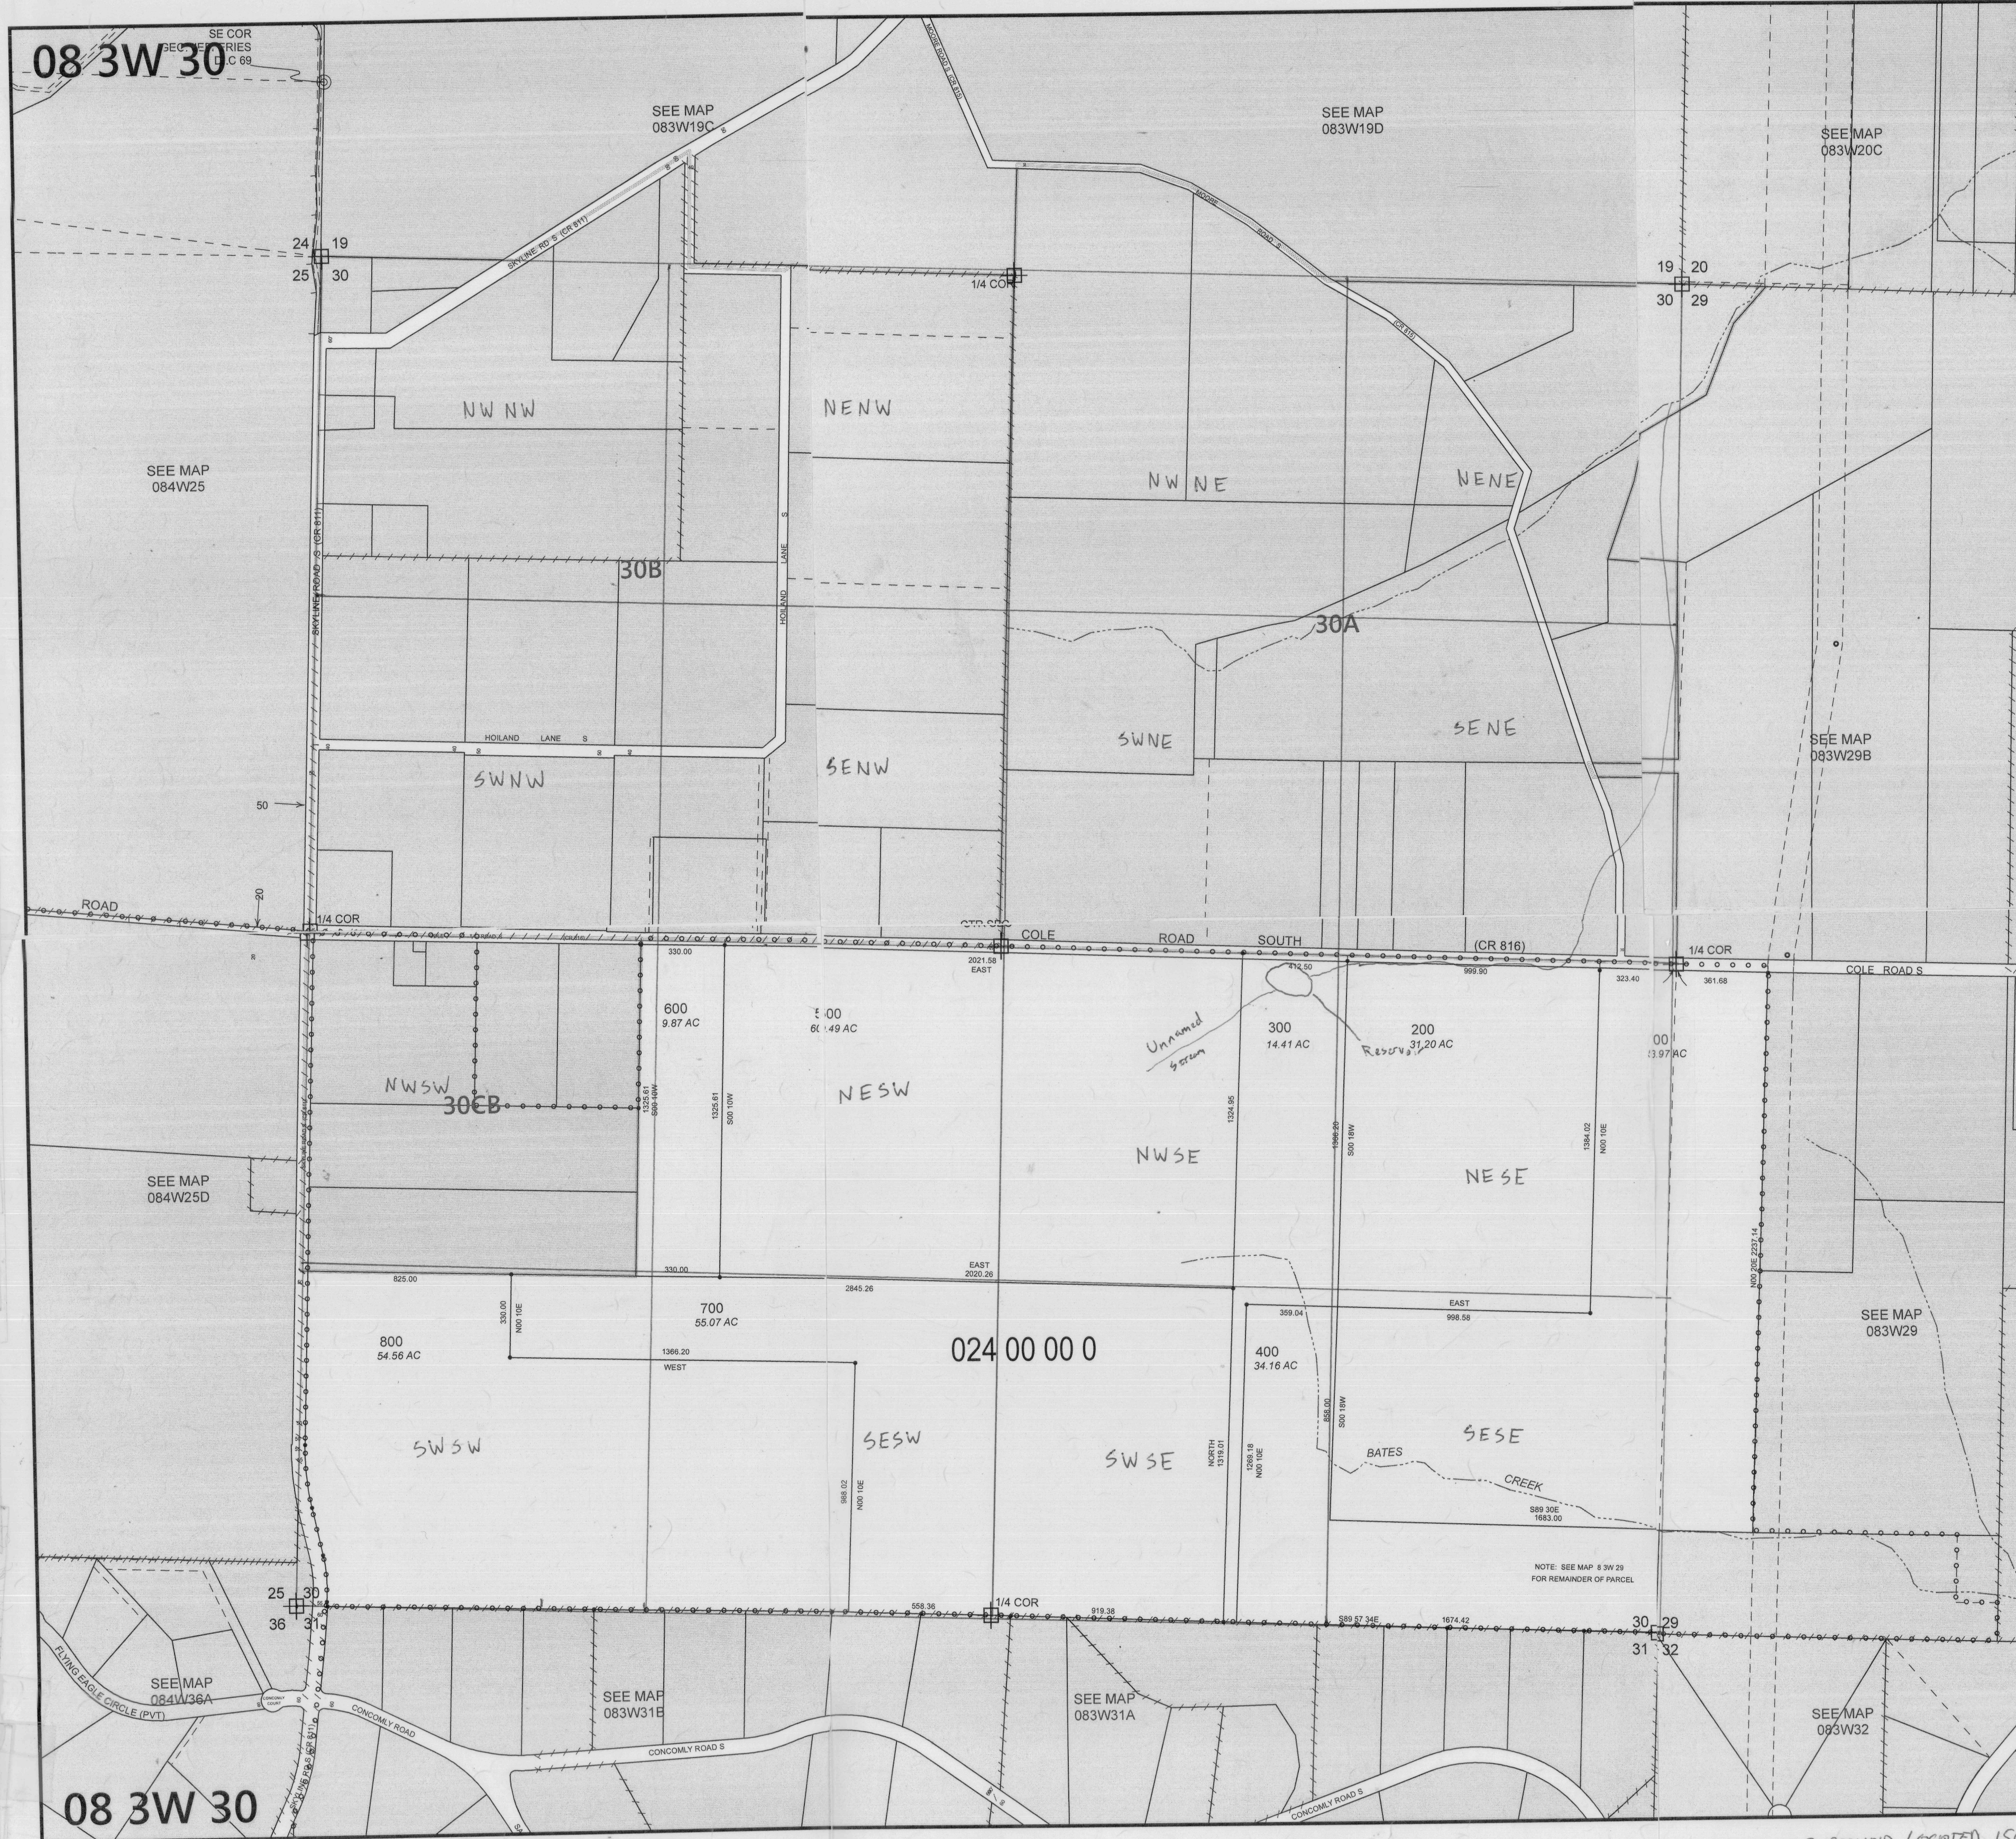

08 3W 30

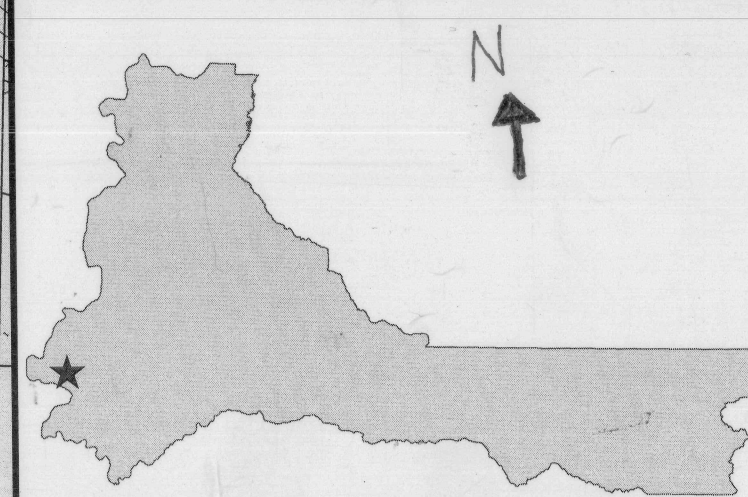

MARION COUNTY, OREGON
SEC 30 T8S R3W W.M.
SCALE 1" = 400'

LEGEND

- LINE TYPES
- | | |
|--------------------------|-----------------------|
| Taxlot Boundary | Historical Boundary |
| Road Right-of-Way | Easement |
| Railroad Right-of-Way | Railroad Centerline |
| Private Road ROW | Taxcode Line |
| Subdivision/Plat Bndry | Map Boundary |
| Waterline - Taxlot Bndry | Waterline - Non Bndry |

- SYMBOL TYPES
- | | |
|-----------------|--------------------------------|
| Survey Monument | + 1/16TH Section Cor. |
| Road Station | 1/4 Section Cor. |
| DLC Corner | 16, 15
21 22 Section Corner |


NUMBERS
Tax Code Number
000 00 00 0
Acreage 0.25 AC All acres listed are Net Acres, excluding any portions of the taxlot within public ROWs

NOTES
Tick Marks: If a tick mark is indicated on the end of a line, then the dimension goes to the tick mark. This is used when dimensions extend into public right-of-ways.

CANCELLED NUMBERS

--	--	--	--	--

DISCLAIMER: THIS MAP WAS PREPARED FOR ASSESSMENT PURPOSES ONLY

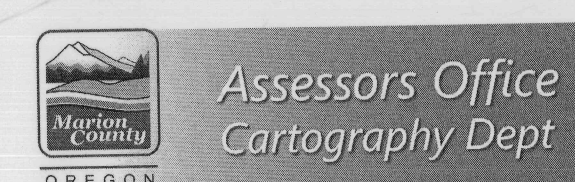

FOR ADDITIONAL MAPS VISIT OUR WEBSITE AT www.co.marion.or.us

PLOT DATE: 7/7/2016

08 3W 30

CENTER OF RESERVOIR LOCATED 1500' WEST AND 100' SOUTH OF EAST 1/4 COR. SEC 30

RECEIVED
FEB 16 2018
OWRD