


RECEIVED  
JUN 26 1978  
WATER RESOURCES DEPT.  
SALEM, OREGON

TWP 39 SOUTH  
RANGE 5 W., W. M.  
SECTION 2

JOSEPHINE COUNTY  
SCALE: 1" = 400'

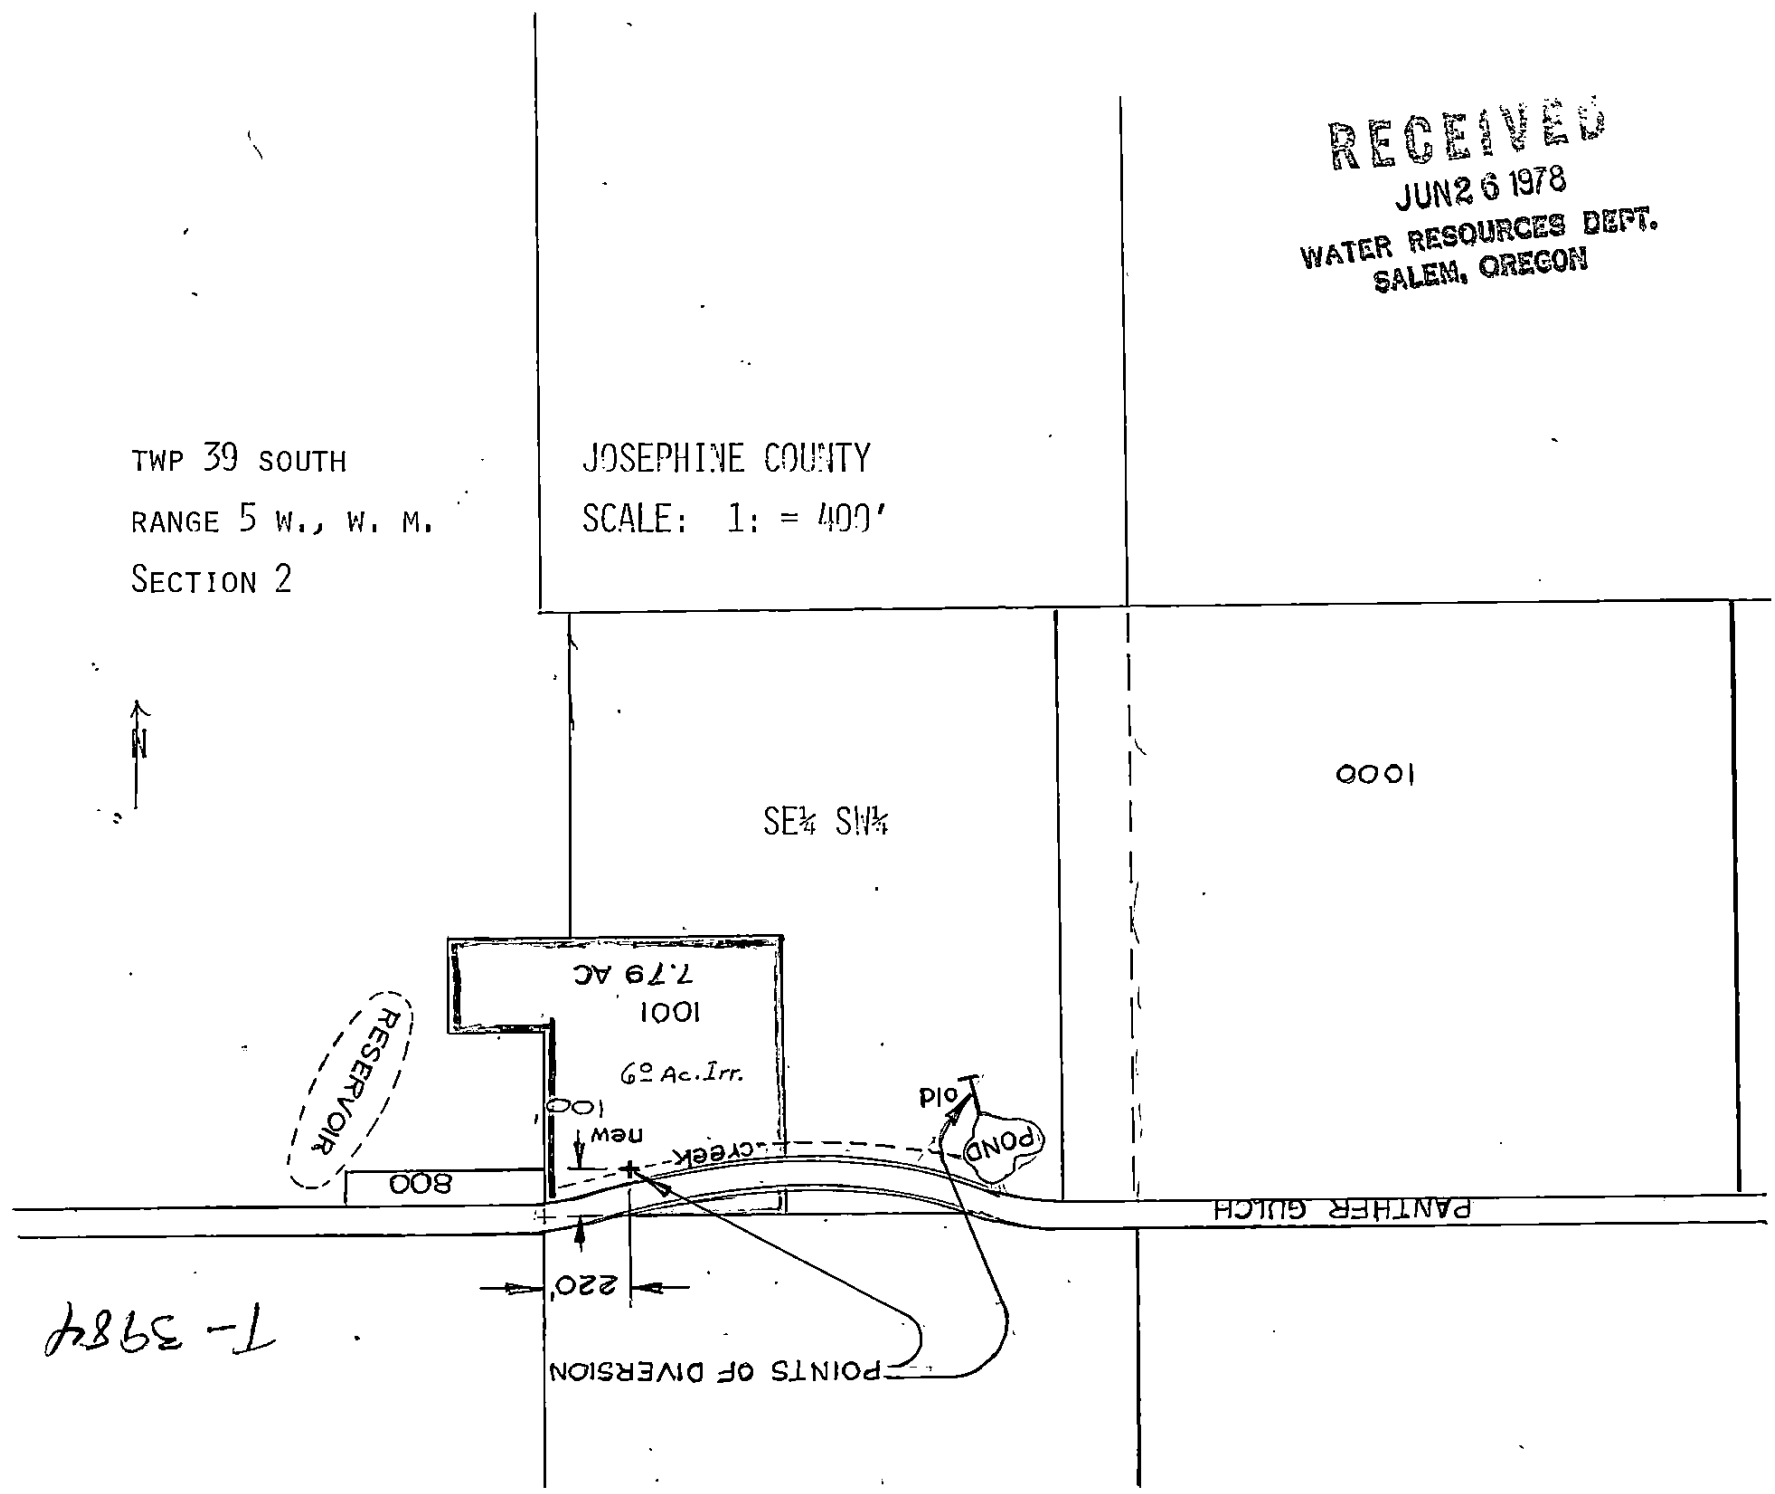

T-3984

POINTS OF DIVERSION