


# ADJUDICATION SURVEY OF RATTLESNAKE CREEK HARNEY COUNTY OREGON

MAP SHOWING STREAMS AND IRRIGATED LANDS PREPARED  
IN ACCORDANCE WITH SECTION 47-611 OREGON CODE 1930  
FOR USE IN THE DETERMINATION OF WATER RIGHTS BEFORE  
THE STATE ENGINEER  
OF THE

STATE OF OREGON

OFFICE OF THE STATE ENGINEER 1936  
CHAS. E. STRICKLIN STATE ENGINEER

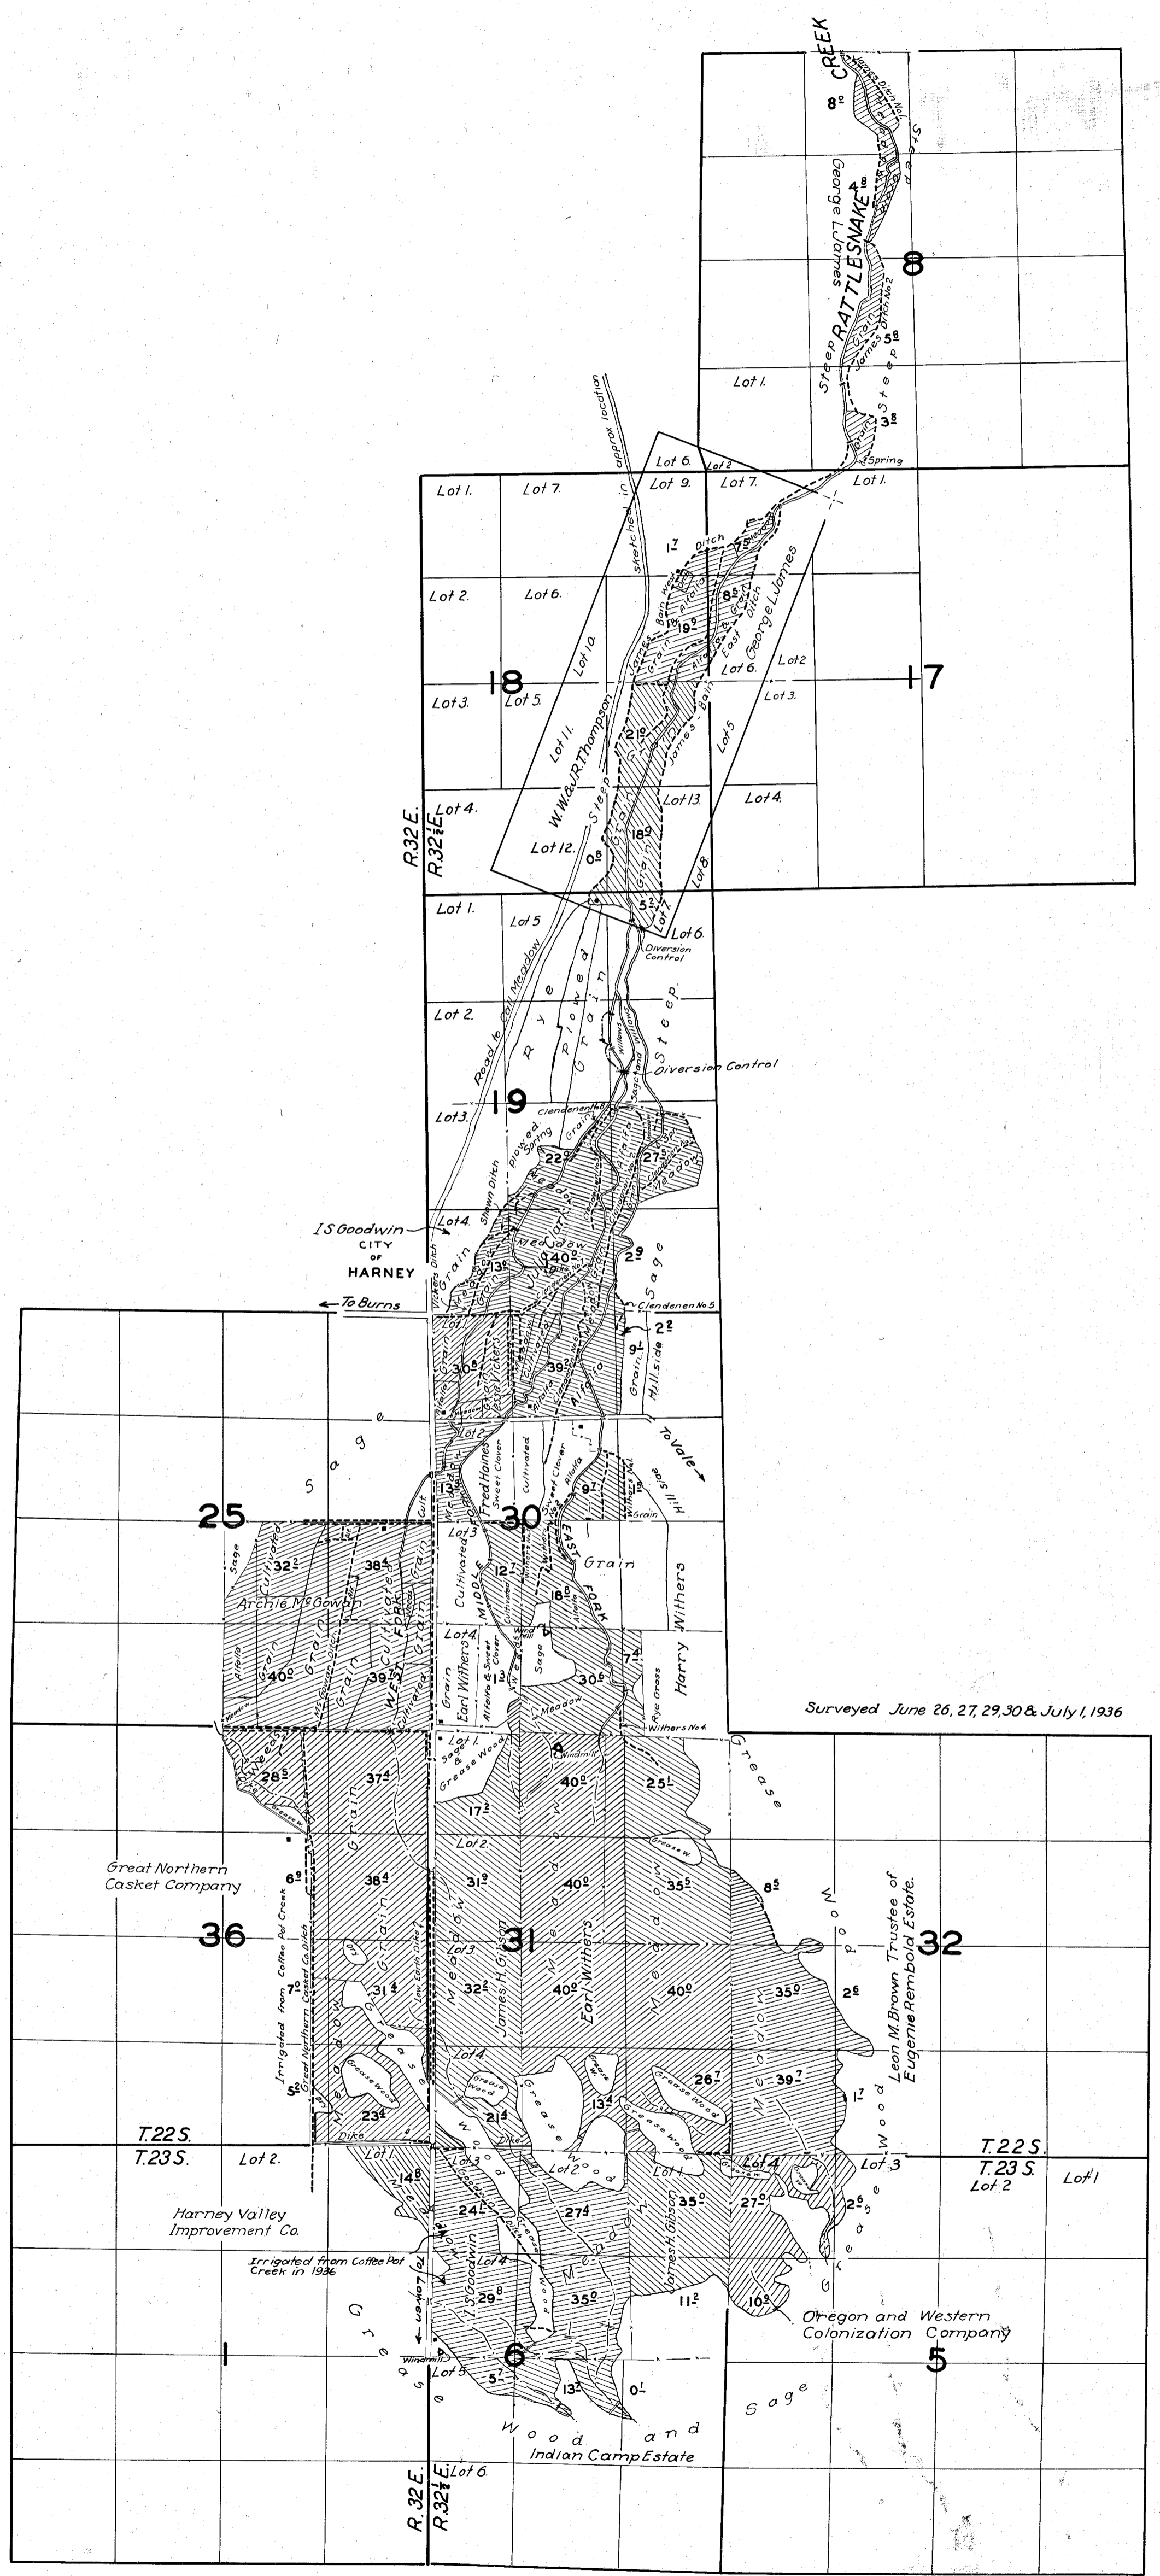

### LEGEND

- DITCHES AND DIVERSION POINTS
- NATURAL DEPRESSIONS
- IRRIGATED LANDS
- LOCATED CORNERS
- BUILDINGS AND FENCES
- CREEKS, DAMS AND BRIDGES

