
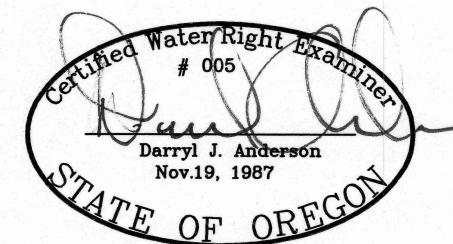


CLAIM OF BENEFICIAL USE MAP
FOR
MARVIN AND EDIE CASEY


SECTIONS 19 & 20, TOWNSHIP 40 SOUTH RANGE 36 EAST,
HARNEY COUNTY, OREGON

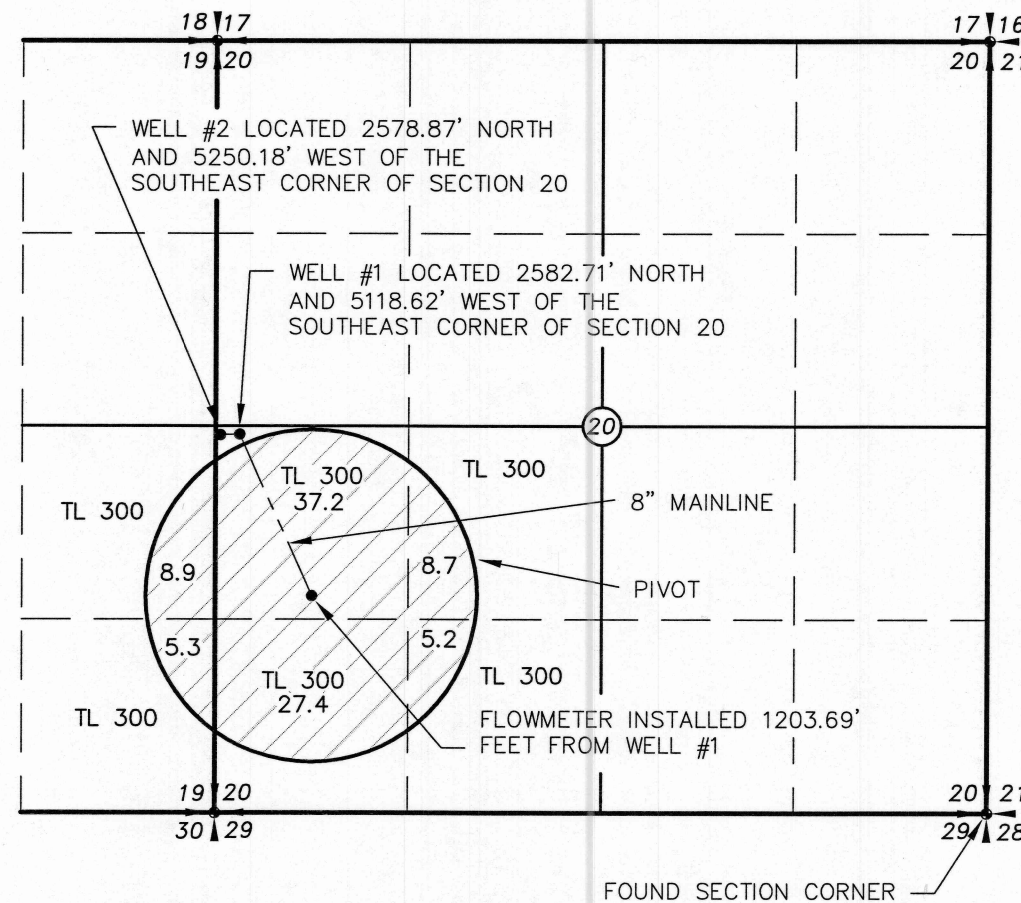


RENEWAL 12/31/09

LEGEND

- SECTION LINE
- 1/4 SECTION LINE
- 1/16 SECTION LINE
- IRRIGATION MAIN LINE

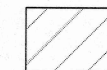

IRRIGATED AREA

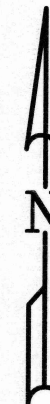

SCALE: 1"=1320'

APPLICATION NO. G-16585

PERMIT NO. G-16096

NOTE:
PREPARATION OF THIS MAP IS FOR IDENTIFYING PROPOSED
WATER RIGHTS ONLY. IT HAS NO INTENT TO PROVIDE
LOCATIONS OR DIMENSIONS OF PROPERTY BOUNDARIES.

RECEIVED

JUN 23 2008

WATER RESOURCES DEPT
SALEM, OREGON

REVISION	BY

ANDERSON ENGINEERING
AND SURVEYING, INC.

P.O. BOX 28
LAKEVIEW, OREGON 97630
(541) 947-4407
FAX 947-2321

FOR:
MARVIN & EDIE CASEY
BOX 115
DENIO, NV 89404

CLAIM OF BENEFICIAL USE
APPLICATION NO. G-16585
PERMIT NO. G-16096

DATE:	JUN. 2008
SCALE:	1"=1320'
DWG. BY:	R.C.
JOB:	2008-071
FILE:	2008-071
SHEET:	1 OF 1