


FOR ASSESSMENT AND TAXATION ONLY

SECTION 34 T.16S. R.4W. W.M.
Lane County
1" = 400'

16043400
EUGENE

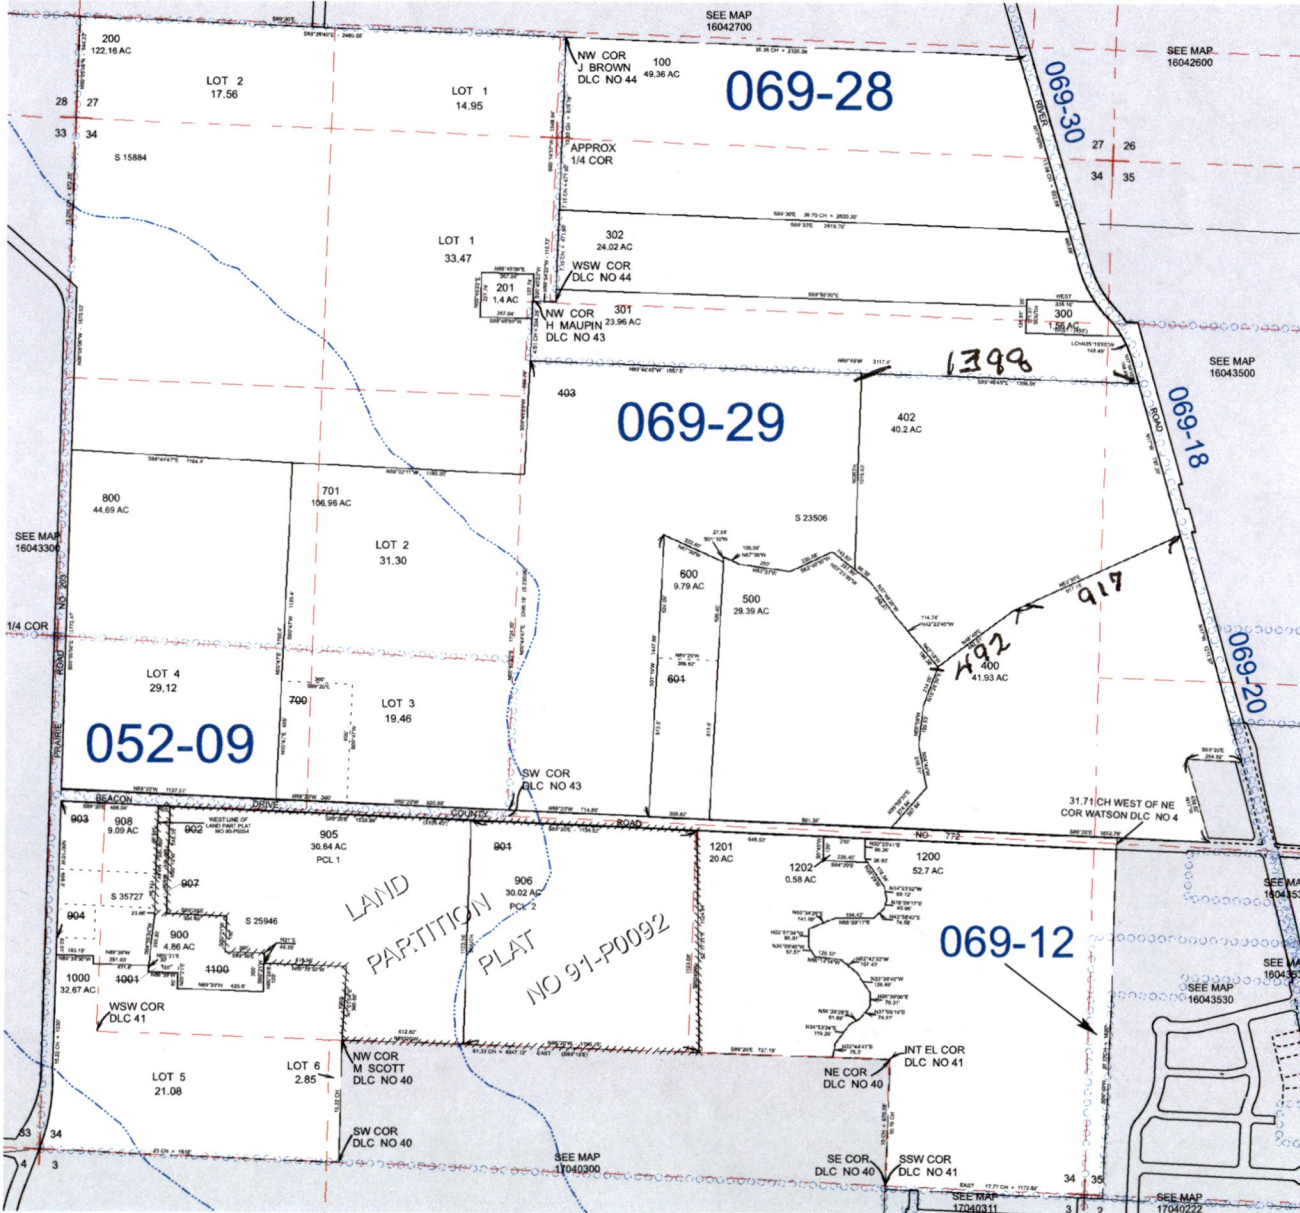

GIS DATA
3/10/2008 12:14:53 PM : kaqg

- CANCELLED:
- 1001
 - 1100
 - 401
 - 403
 - 901
 - 700
 - 901
 - 902
 - 903
 - 904
 - 907

RECEIVED
MAR 07 2018
OWRD

REVISIONS
3/10/2008 - LCAT168 - CONVERT MAP TO GIS

EUGENE
16043400

1981-9

Elizabeth and Joe Thompson
 T. 16 S. R. 4 W. Sections 34 and 35
 Tax Lot 402

1" = 500'

Well LANE8306: 1515 FEET SOUTH AND 186 FEET EAST OF
 THE NW CORNER OF SECTION 34

IRRIGATION OF 35 ACRES TOTAL

