


# Application for a Permit to Use Groundwater, Gerig Farms LLC

RECEIVED

MAR 15 2018  
OWRD

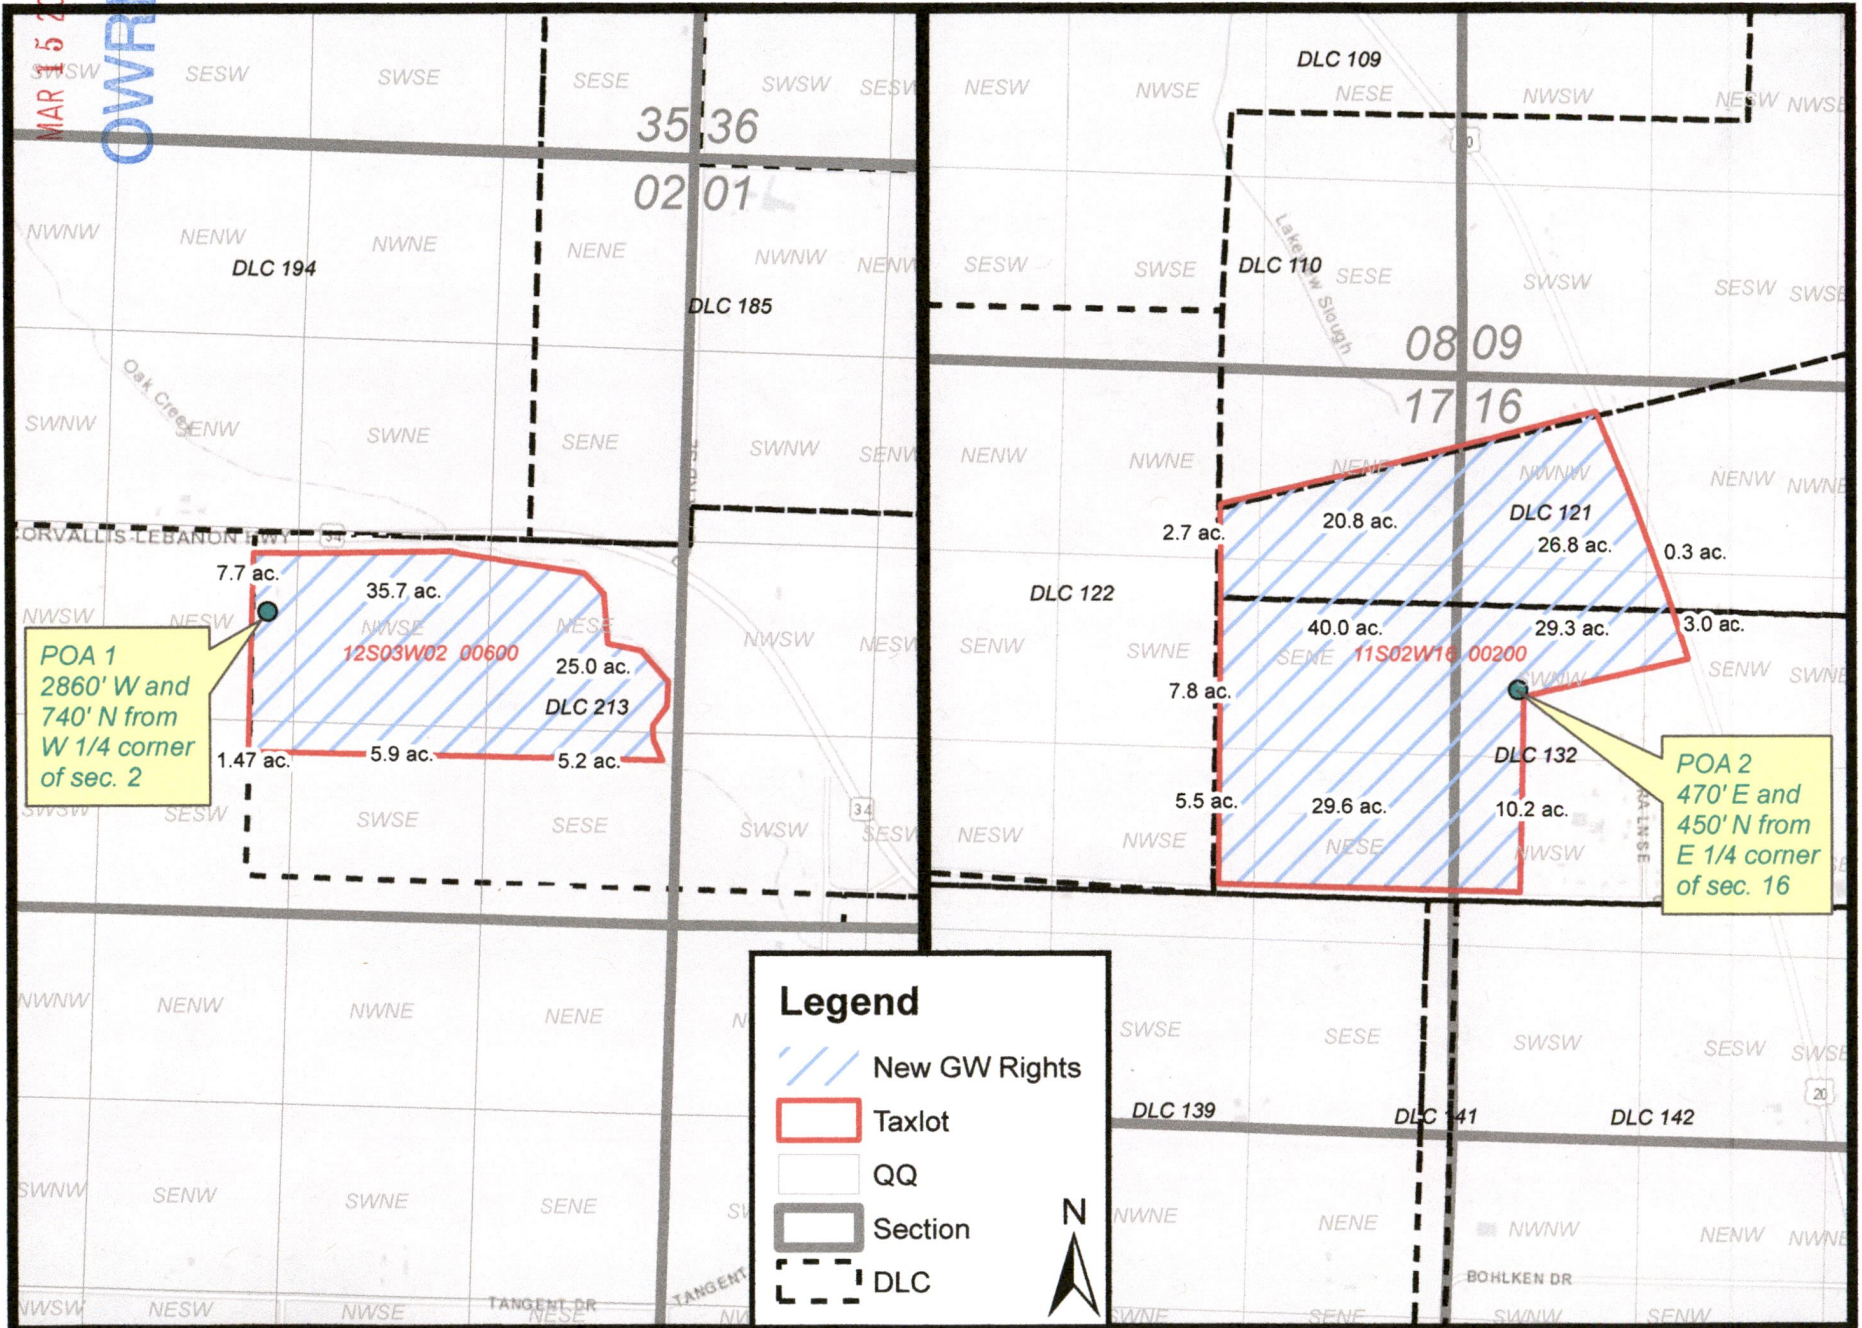

POA 1  
2860' W and  
740' N from  
W 1/4 corner  
of sec. 2

POA 2  
470' E and  
450' N from  
E 1/4 corner  
of sec. 16

**Legend**

- New GW Rights
- Taxlot
- QQ
- Section
- DLC




0 660 1,320 2,640  
Feet

Map prepared by McGill

12981-29

# Application for a Permit to Use Groundwater, Gerig Farms LLC

Revised 10-9-18

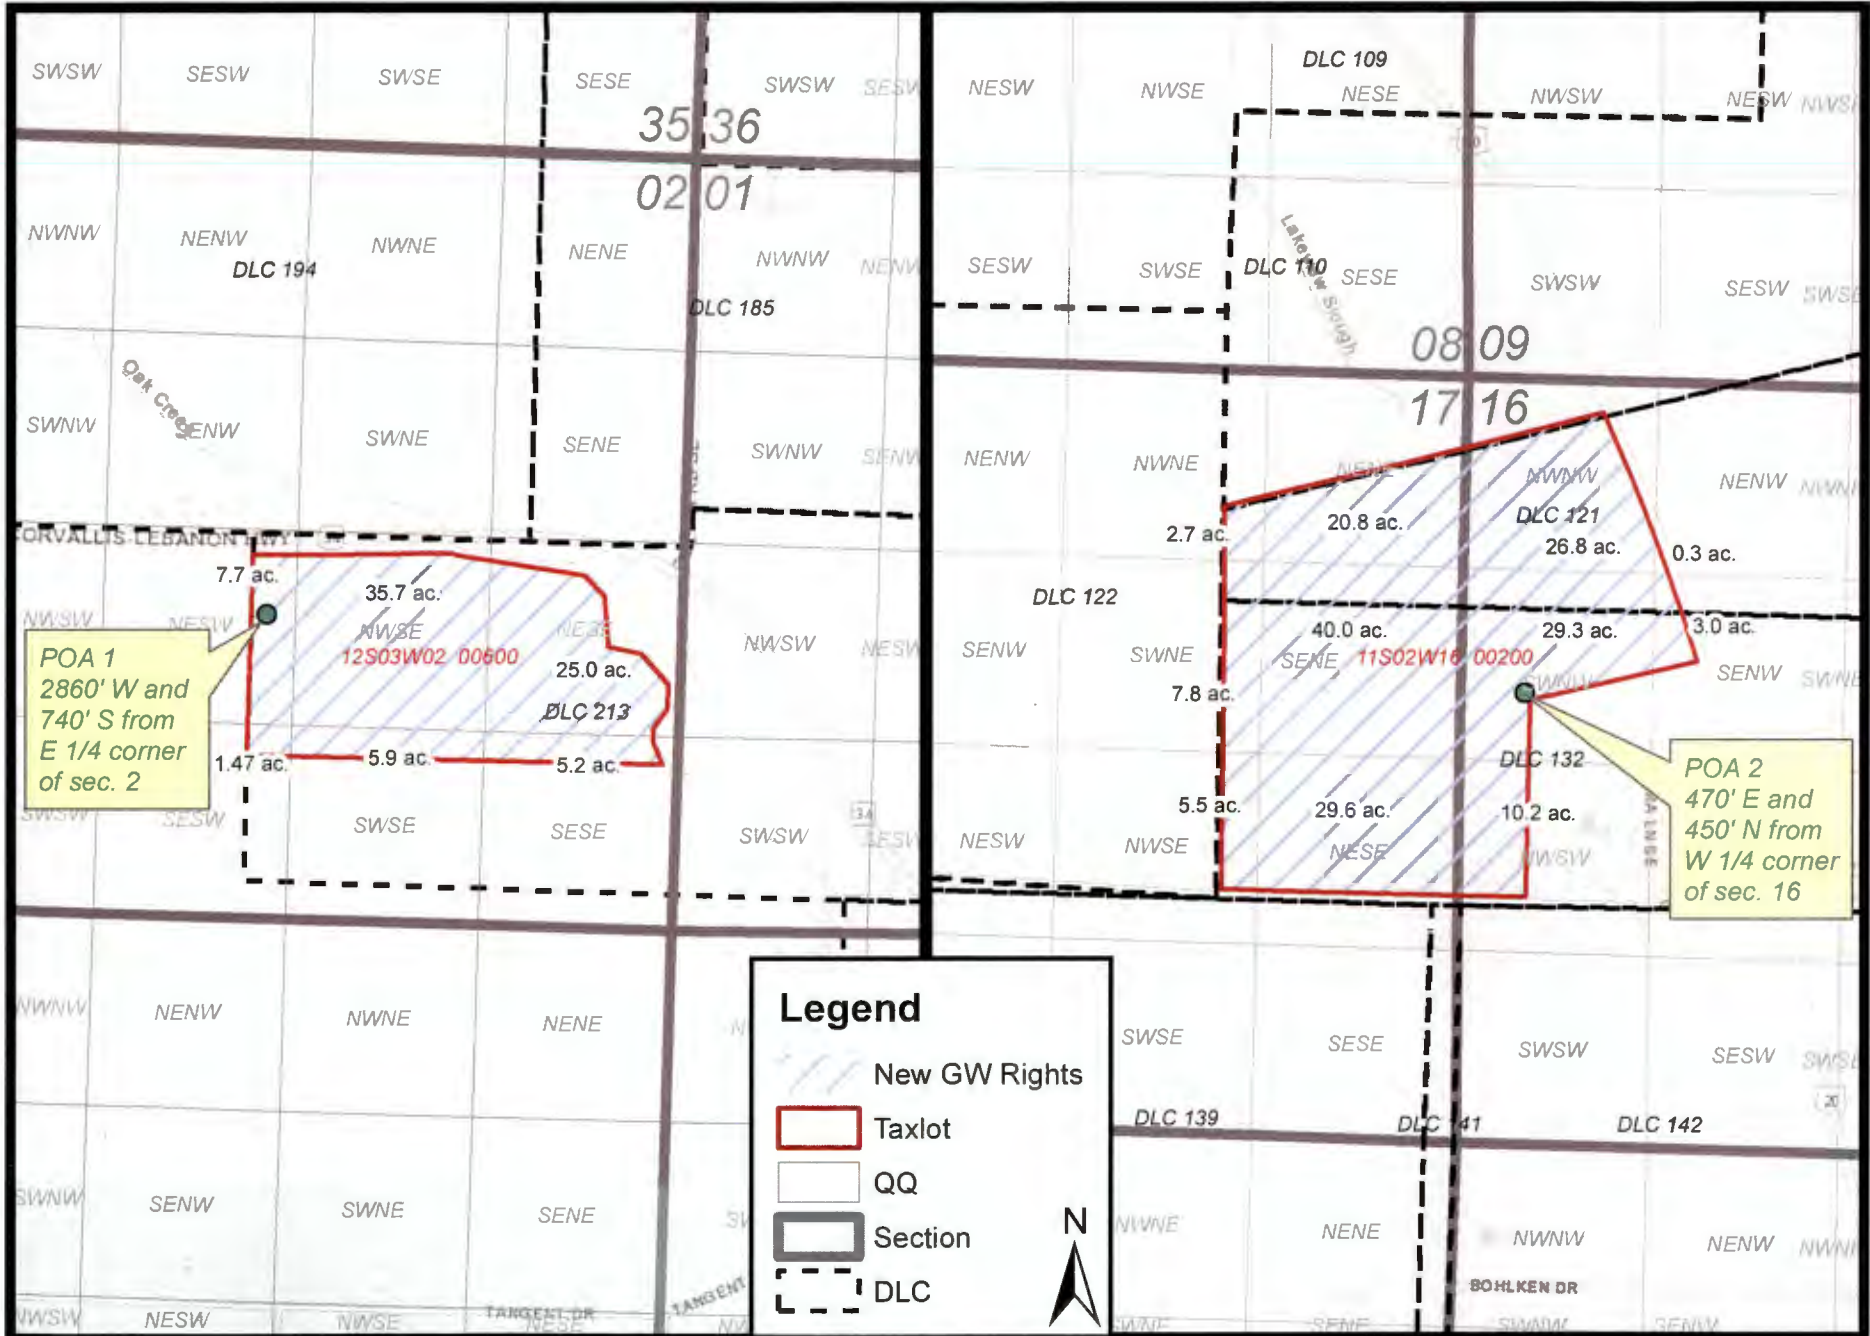

POA 1  
2860' W and  
740' S from  
E 1/4 corner  
of sec. 2

POA 2  
470' E and  
450' N from  
W 1/4 corner  
of sec. 16

**Legend**

- New GW Rights
- Taxlot
- QQ
- Section
- DLC



0 660 1,320 2,640 Feet

Rec'd 10/9/2018

Map prepared by McGill

G-19621