


**Water Right Application Map
Connie Pawley
T.26S R.6W Section 23
Douglas County
Scale: 1" = 400'**

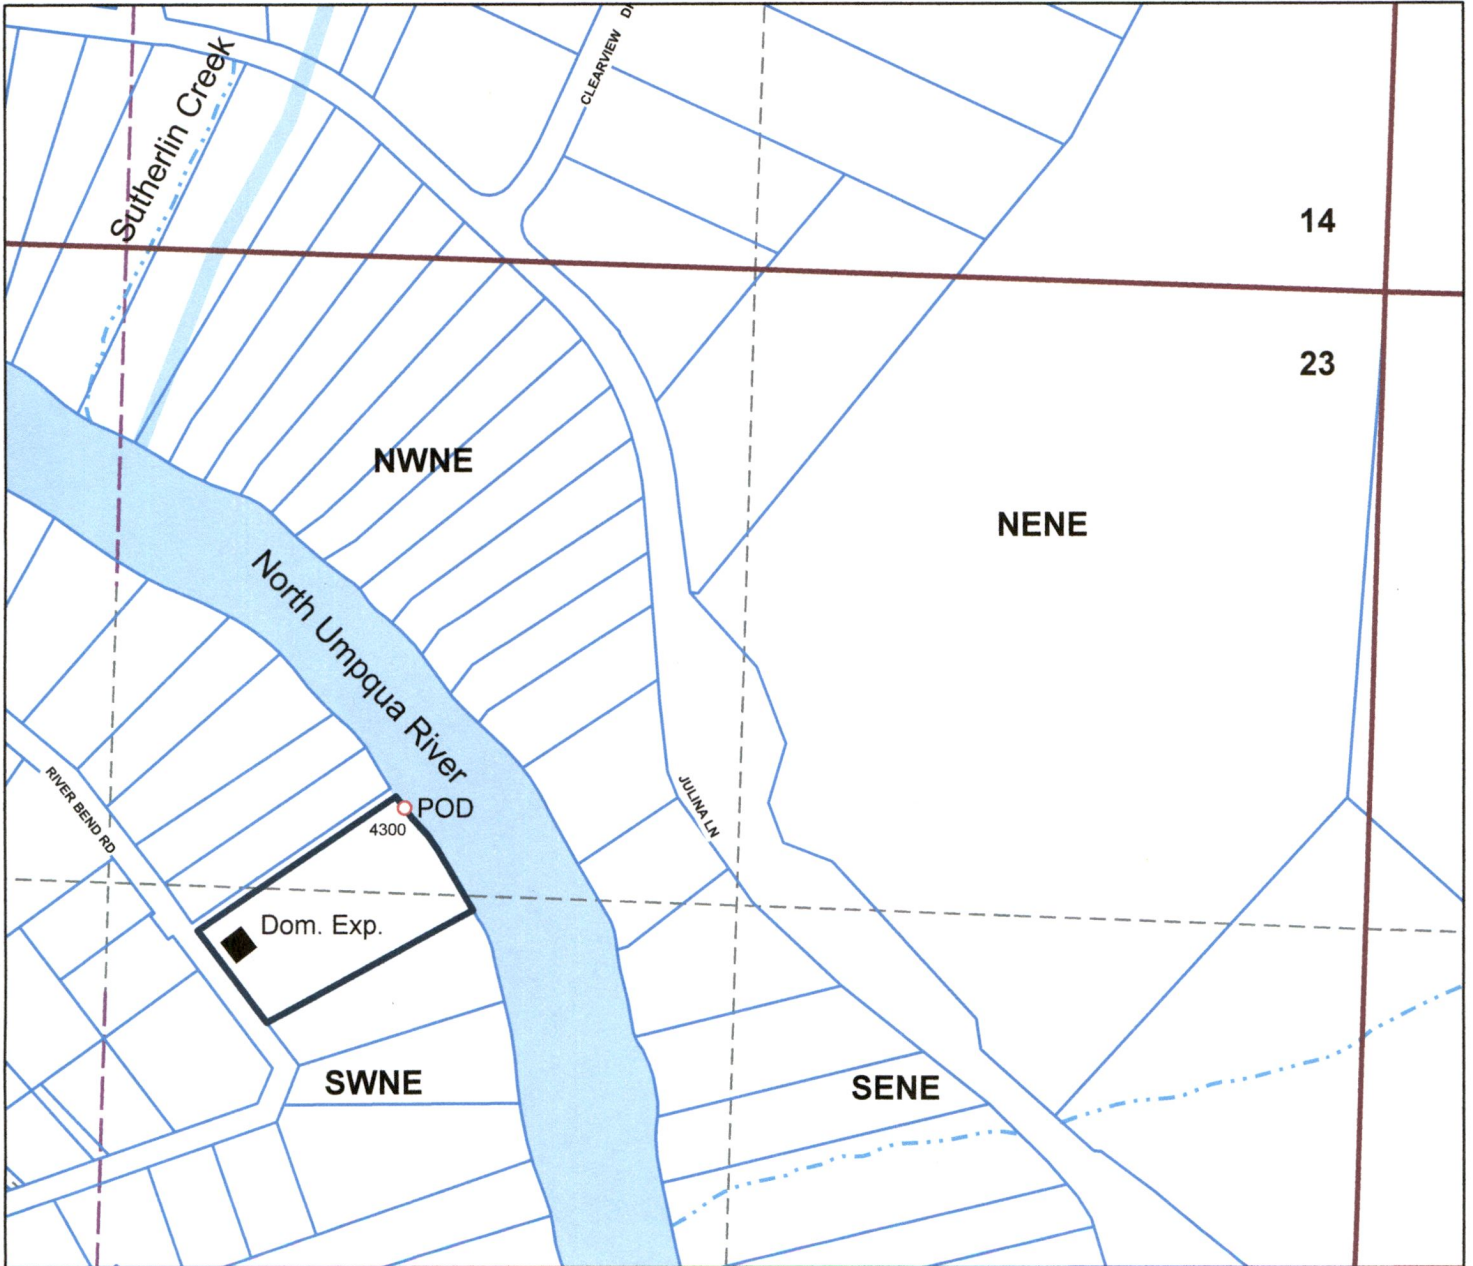

Point of Diversion is located 1160 ft. South and 623 ft. East from the North Quarter Corner of Section 23. RECEIVED

MAR 16 2018

OWRD