


Clackamas County

1

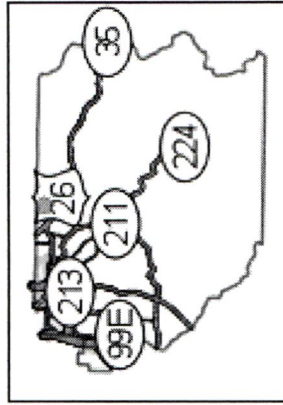


Clackamas County

Geographic Information Systems
168 Warner Milne Road
Oregon City, OR 97045

This map and all other information have been compiled for preliminary and/or general purposes only. This information is not intended to be complete for purposes of determining land use restrictions, zoning, title, parcel size, or suitability of any property for a specific use. Users are cautioned to field verify all information before

Mon, 19 Mar 2018 14:00:56

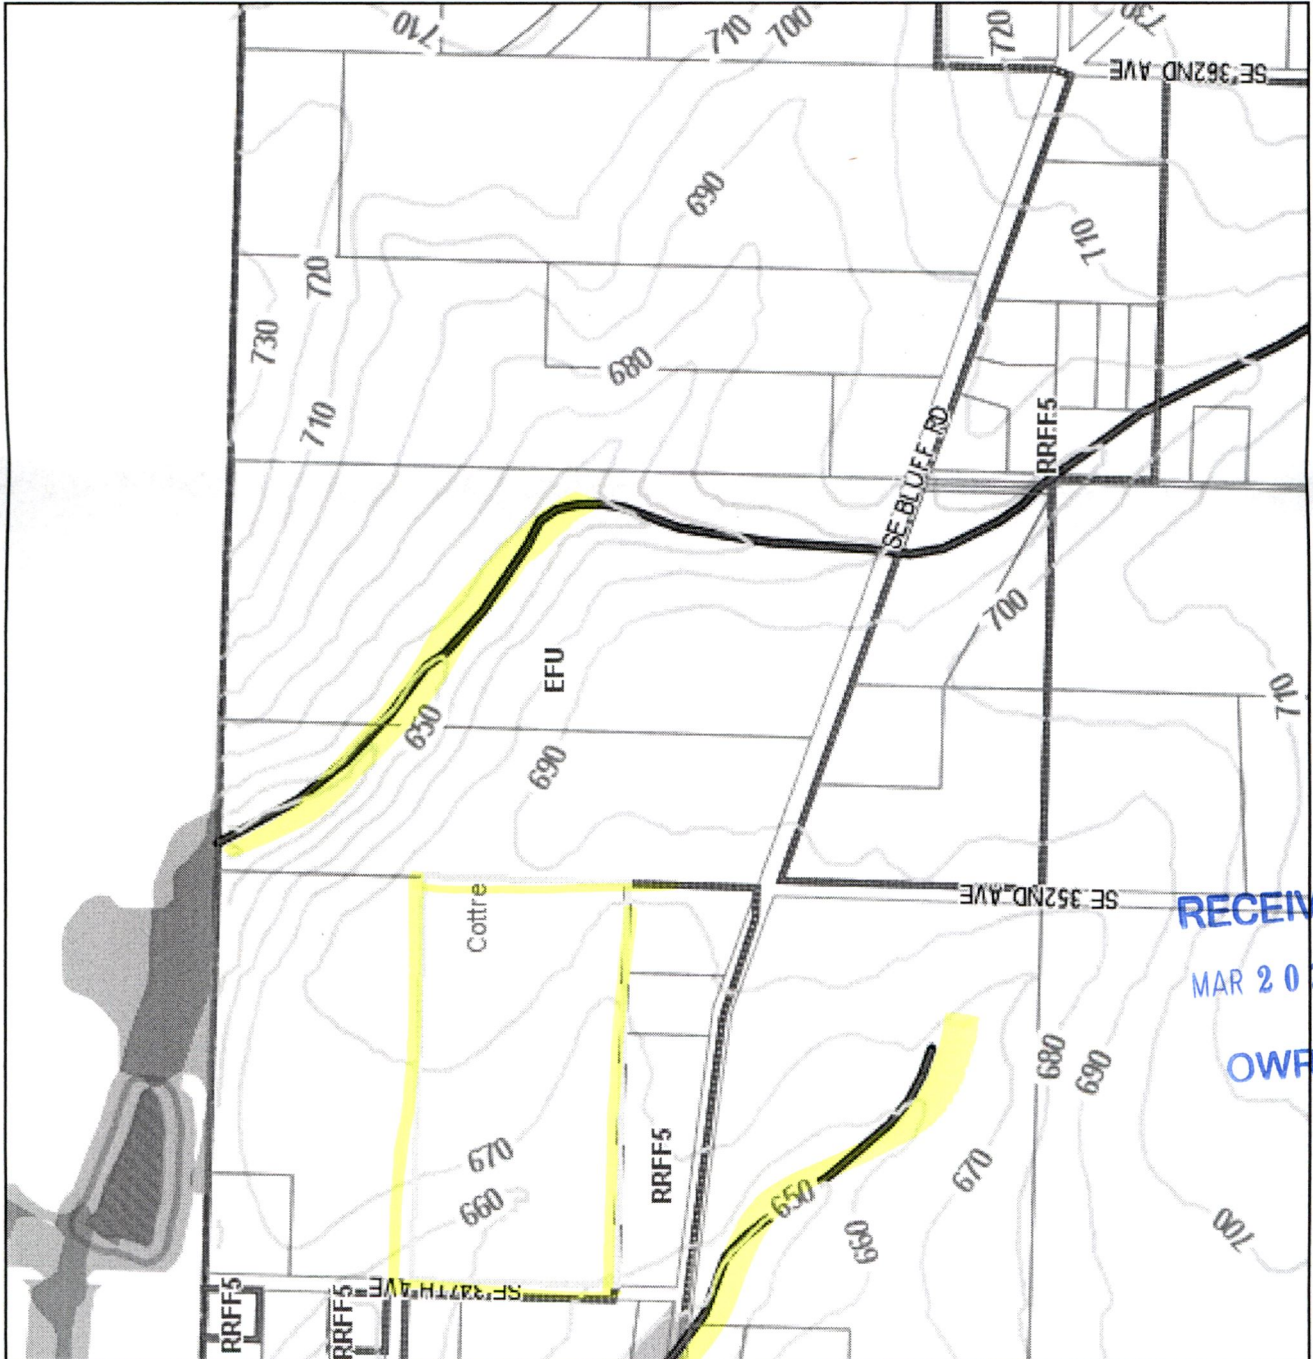

RECEIVED
MAR 20 2018
OWRD


G-10626

RECEIVED

MAR 05 2013

OWRD

NE 1/4 OF NW 1/4 OF SECTION 27
T1S, R4E of the WM
CLACKAMAS COUNTY, OREGON

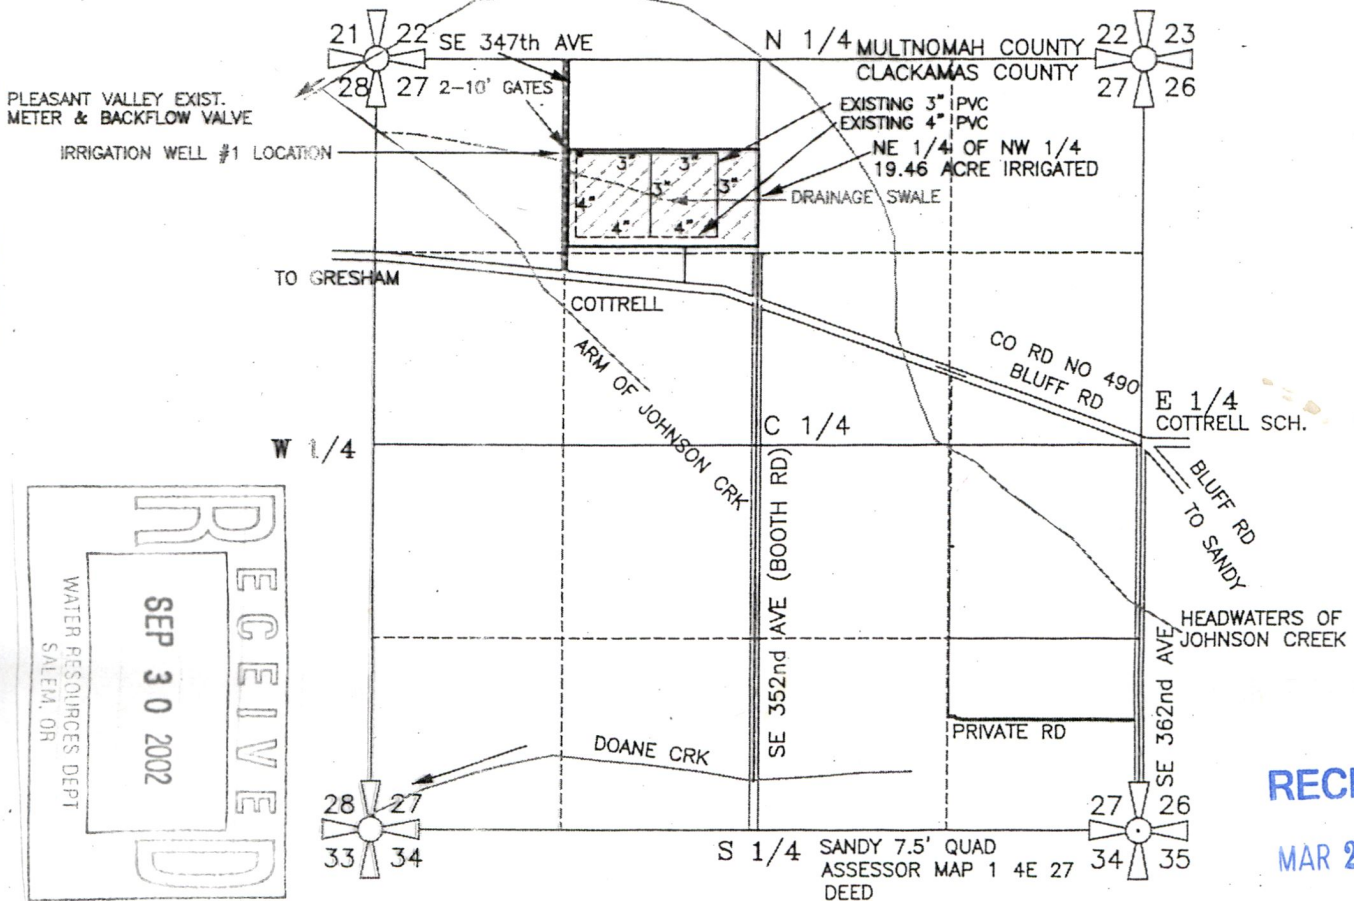

RECEIVED

MAR 20 2013

OWRD


PERMIT = 0.243CFS (109GPM)
ON 19.46 ACRES: NE1/4 OF NW1/4

WELL IS LOCATED 640' SOUTH & 1220' WEST OF
THE NORTH 1/4 CORNER OF SECTION 27, TOWNSHIP
1 SOUTH, RANGE 4 EAST OF WILLAMETTE MERIDIAN
IN THE COUNTY OF CLACKAMAS, STATE OF OREGON

PREPARATION OF THIS MAP WAS FOR THE PURPOSE
OF IDENTIFYING THE LOCATION OF THE WATER RIGHTS
ONLY AND HAS NO INTENT TO PROVIDE DIMENSIONS
OR LOCATION OF PROPERTY OWNERSHIP LINES.


FINAL PROOF SURVEY
GROUNDWATER PERMIT G-

PREPARED BY EDWARD A. CRANE, CWRE

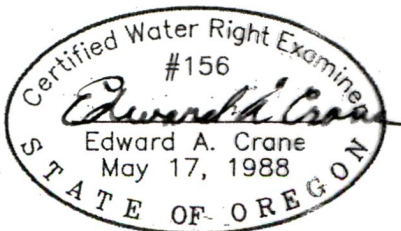

Renewal 12/31/2003
Signed *Edward A. Crane*

SURVEYED SEPT. 27, 2002
BY EDWARD A. CRANE, CWRE

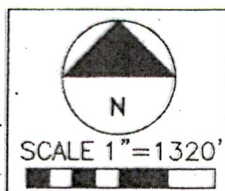

DATE
SEPT. 2002

PROJECT NO.
436-001



CRANE & MERSETH
Engineering/Surveying
SUITE "D"
6566 SE LAKE ROAD
MILWAUKIE, OREGON 97222
BUS: (503) 654-2005
FAX: (503) 654-2575

APPLICATION FOR PERMIT NUMBER G-13318
PERMIT NUMBER G-11983 IN THE NAME OF:

MORRIS VAN METER dba (TEL: 668-5000)
VAN METER & SON NURSERY INC. (FAX: 668-6600)
9720 SE 362ND AVE., BORING OR 97009

SHEET

1/2