


Township 24 S, Range 31 E.

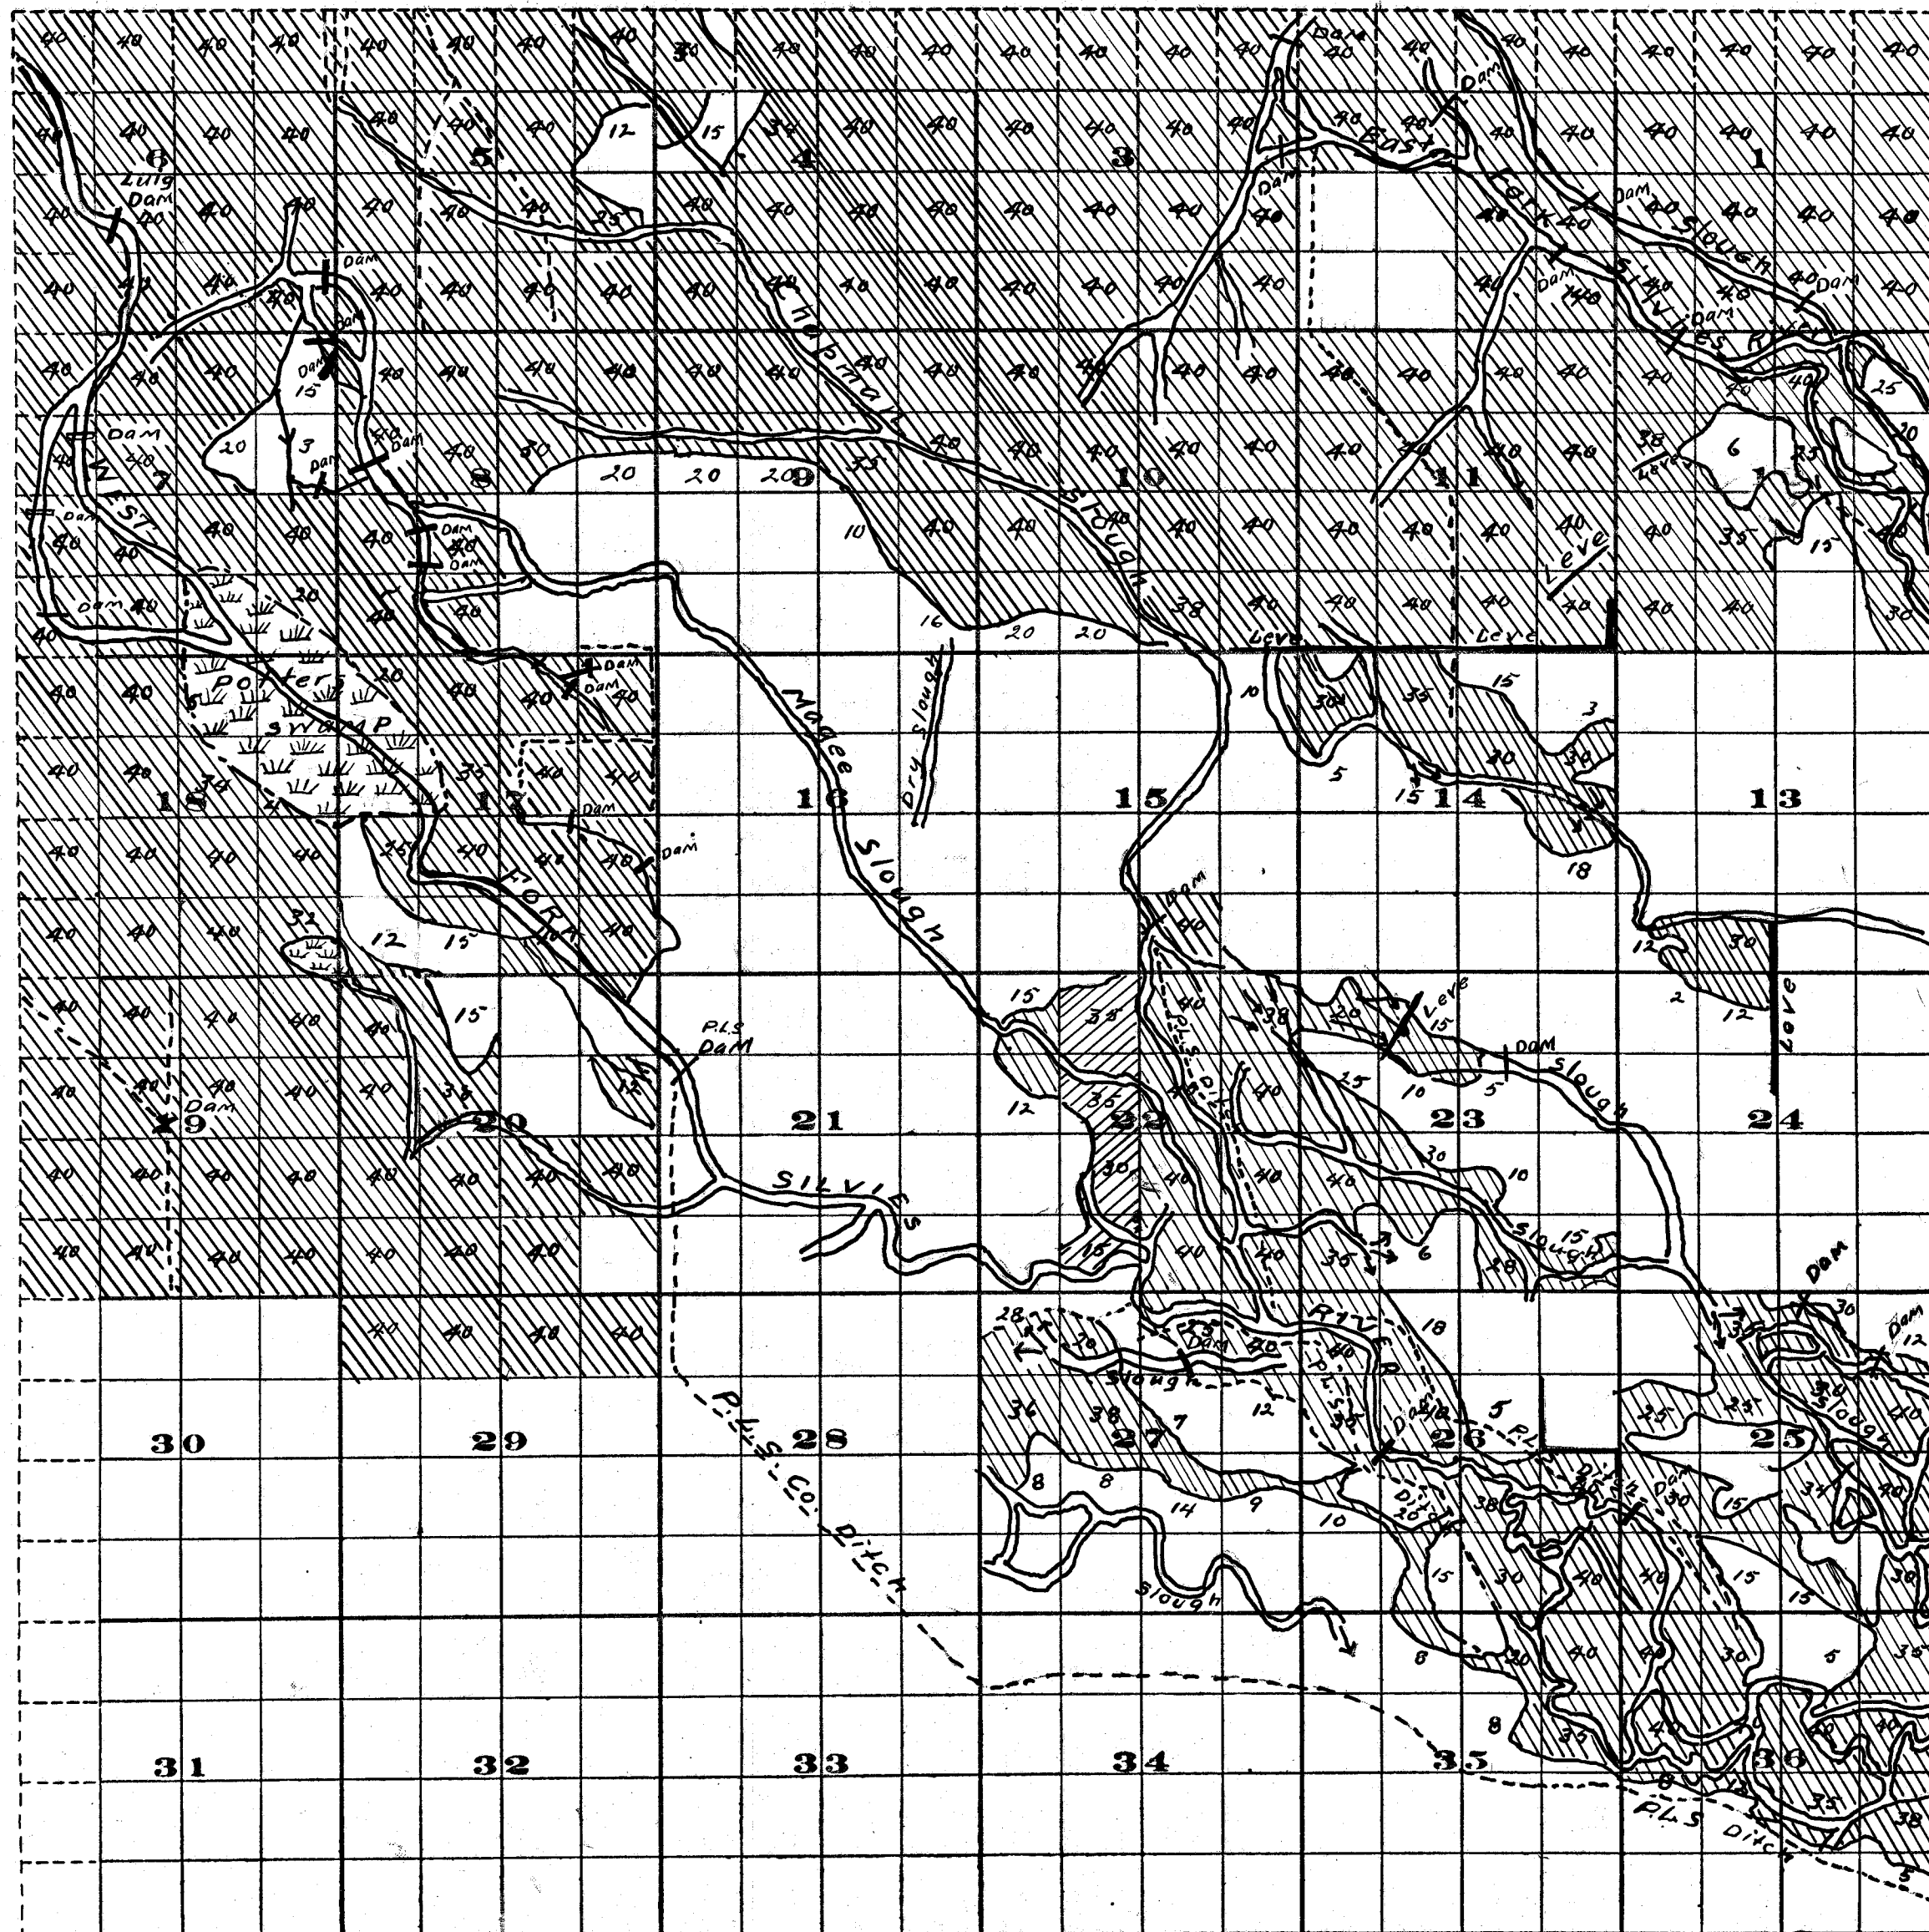

Survey by H.K. Donnelly Aug 1912

FROM OFFICE OF THE STATE ENGINEER, SALEM, OREGON

Scale of Feet.

ADJUDICATION OF SILVIES RIVER & TRIBUTARIES

John H. Lewis State Engineer

Examined Aug 1912

21