

Well Registration Map


Sect 23 | Sect 24.

T15 R10W

1S 10W 23
SE 1/4 NE 1/4
TAX LOT 500
10.8 ACRES

OWNED BY
GEORGE & RUTH
MARIE ALLEN

NOT INCLUDED IN
TILLAMOOK COUNTY'S
AFFIDAVIT FOR THE
PARTIAL
ABANDONMENT OF A
GROUND WATER
CERTIFICATE OF
REGISTRATION
#GR-2771

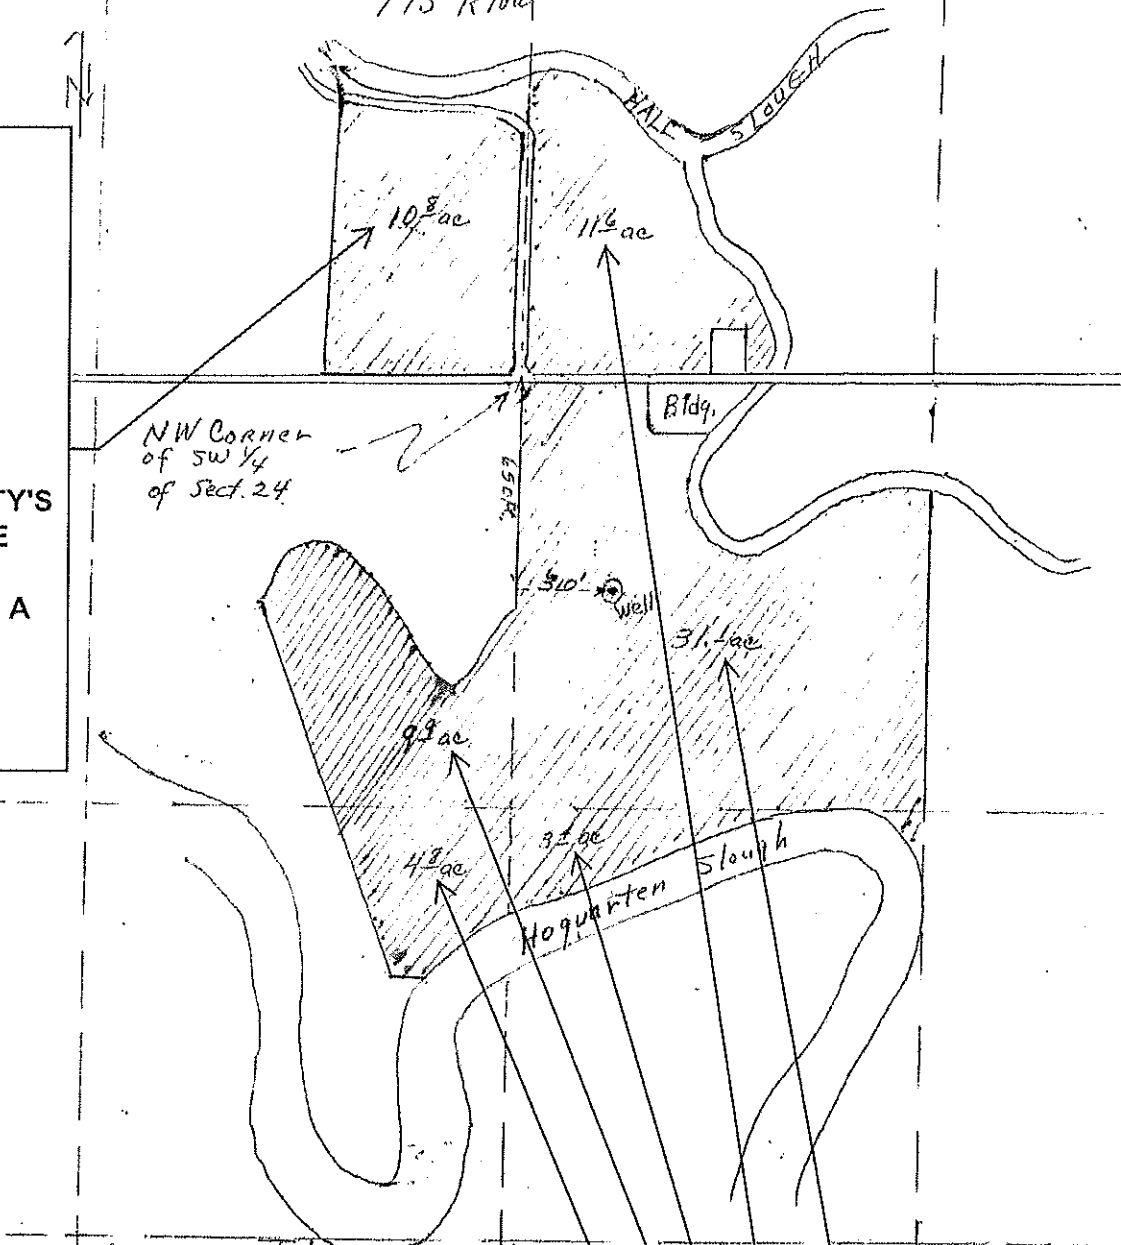

Antone + Johanna Beeler.
Rt. 1 Bay City, BRE
Scale 1"=400'
Land Tr. dated 1/1/11

REMAINING 60.8 ACRES
OWNED BY
TILLAMOOK COUNTY
INCLUDED IN TILLAMOOK
COUNTY'S AFFIDAVIT FOR
THE PARTIAL
ABANDONMENT OF A
GROUND WATER
CERTIFICATE OF
REGISTRATION #GR-2771

RECEIVED

APR 02 2018

OWRD