


Well Registration Map

Sect 23 Sect 24.

T15 R10W

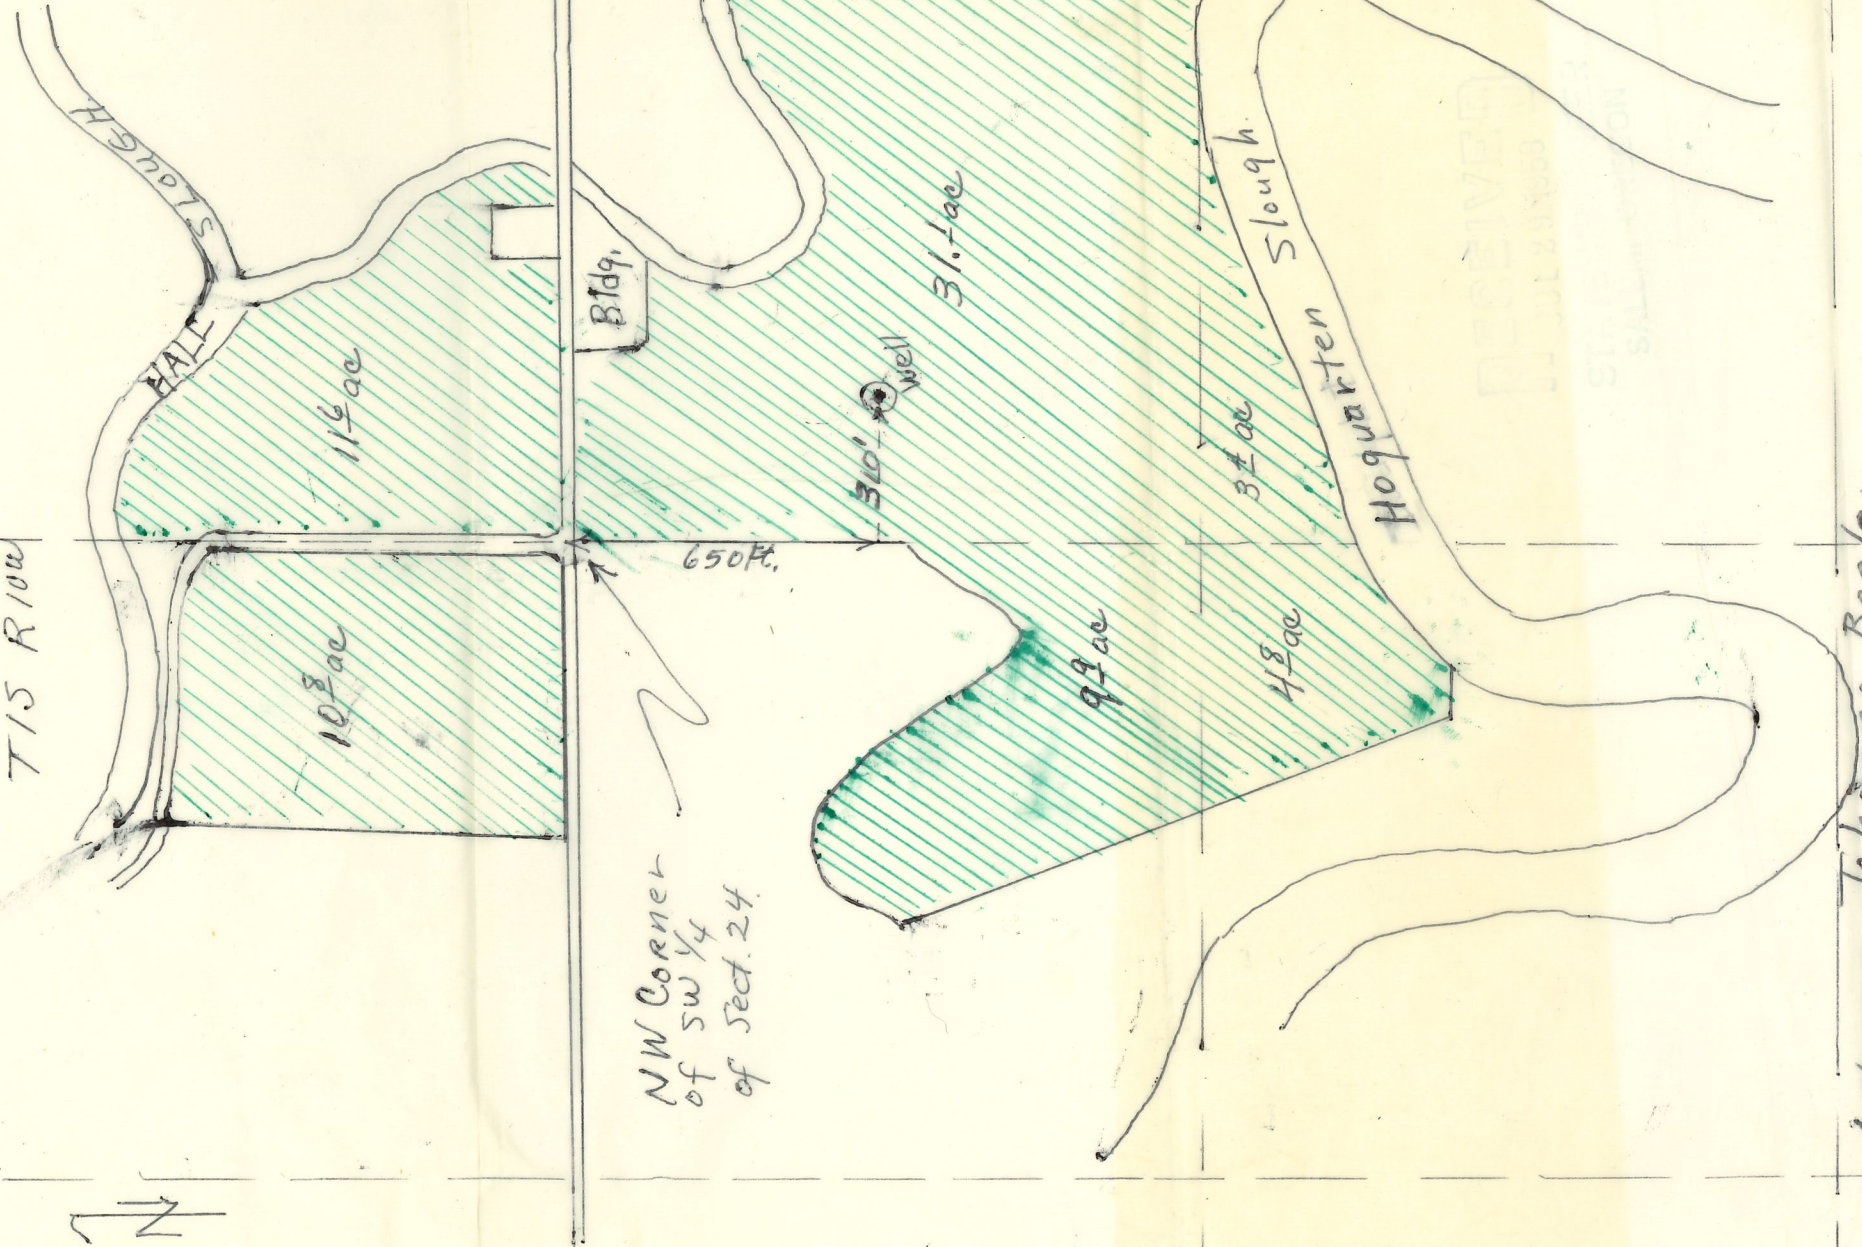

NW Corner of SW 1/4 of Sect. 24.

Antone + Johanna Beecher.  
Rt. 1 Bay City, ORE  
Scale 1" = 400'  
Land Irrigated - [hatched box]

RECEIVED  
STATE OF OREGON  
