


Jeff Stiling

1" = 1320'

Tax Lot:

Township 5 South, Range 4 West, Section 25, Tax Lot 300

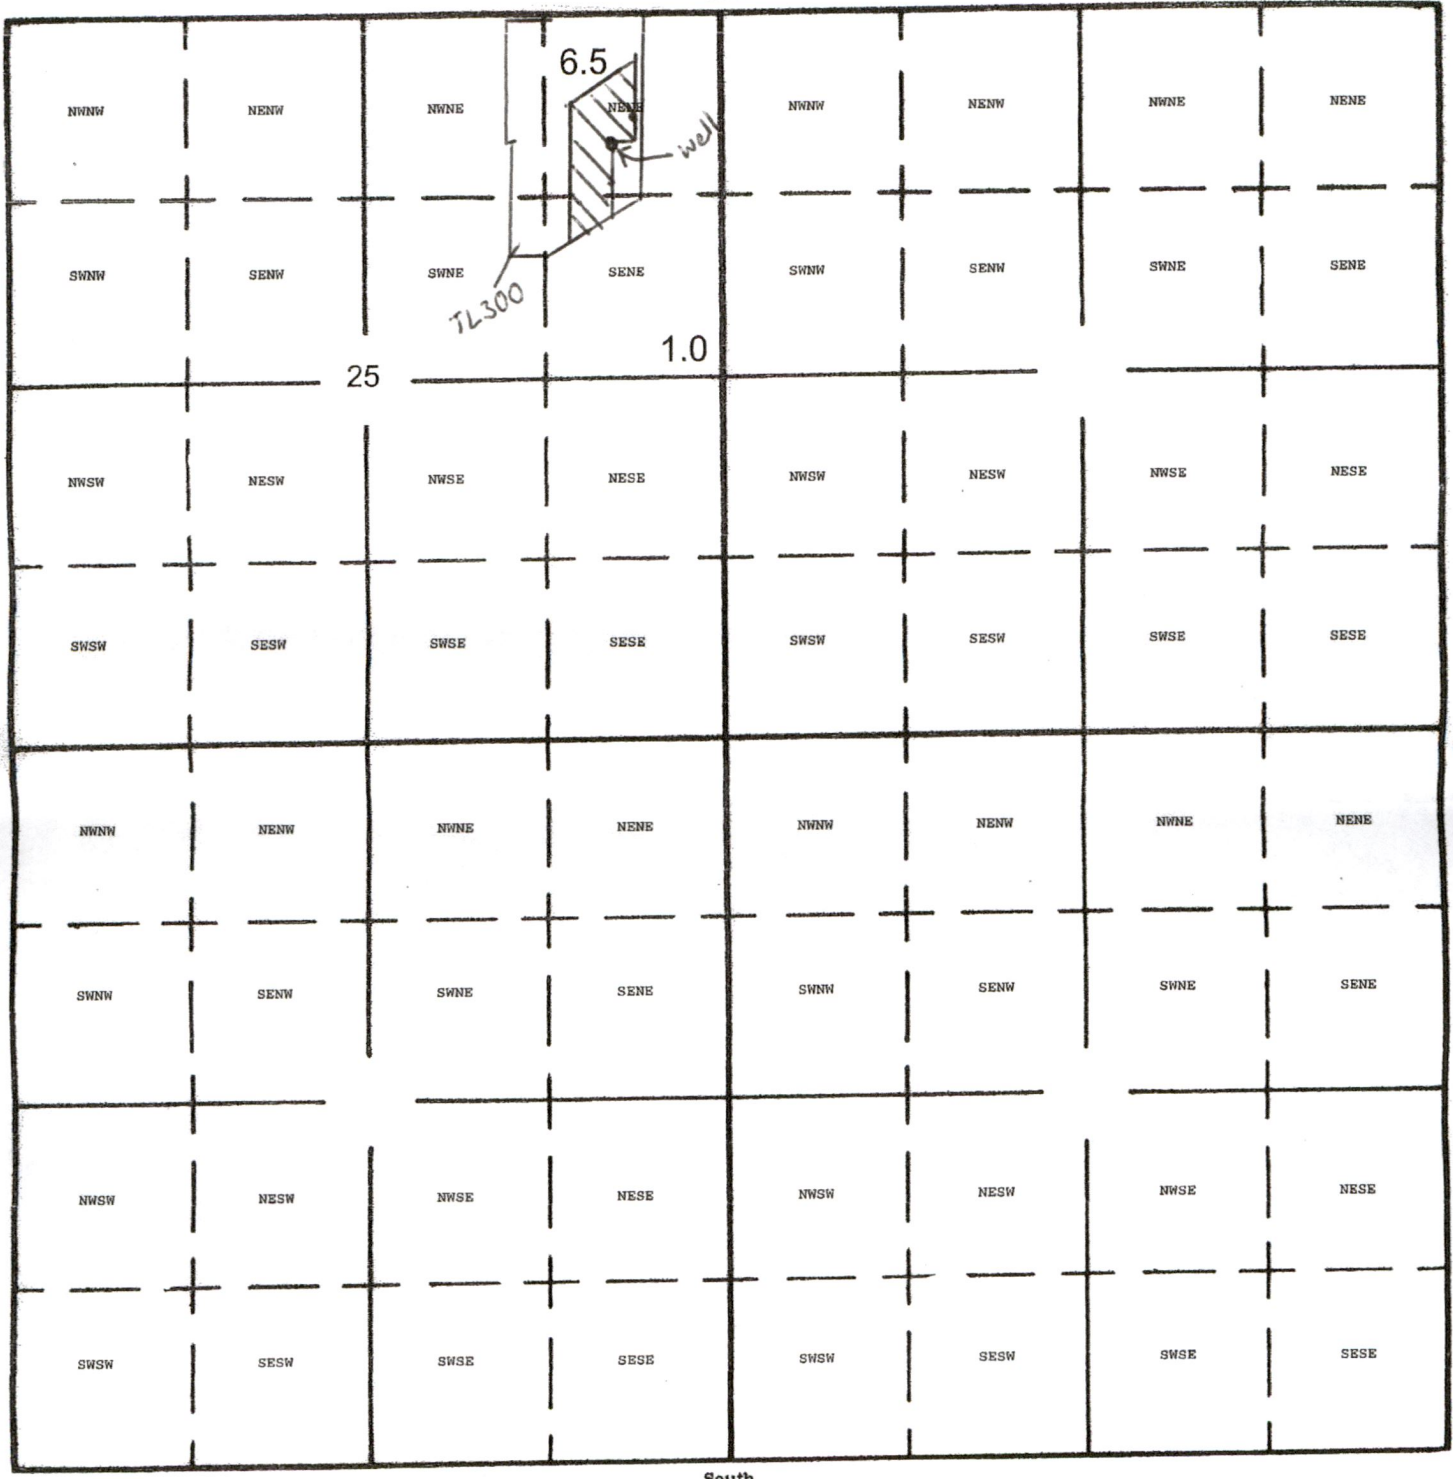

Well YAMH 57781: 950 South and 825 West from NE Corner Section 25

RECEIVED

MAR 30 2018

OWRD

AGREED:

Jeff Stiling 3/26/18
JEFF STILING

LL-1744

4441-77

Stiling Vineyards

Site map for limited water use license application.




Approximately 7.5 acres located at 11751 SE Hood View Road, Amity, OR 97101.

Water source will be the well located 40 feet west of barn, well log # YAMH 57781.

Planned start date of limited license period is 10/1/18.

RECEIVED
MAY 31 2018
OWRD

Legend

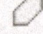-  Mystic Wine
-  Phase I Vineyard
-  Well - Farm House

Irrigation Area - 7.5 Acres

Well Location 40 feet west of barn

Address: 11751 Hood View Road, Amity 97101

Hood View Road

Eola Hills Road

Google Earth

© 2018 Google



500 ft

