
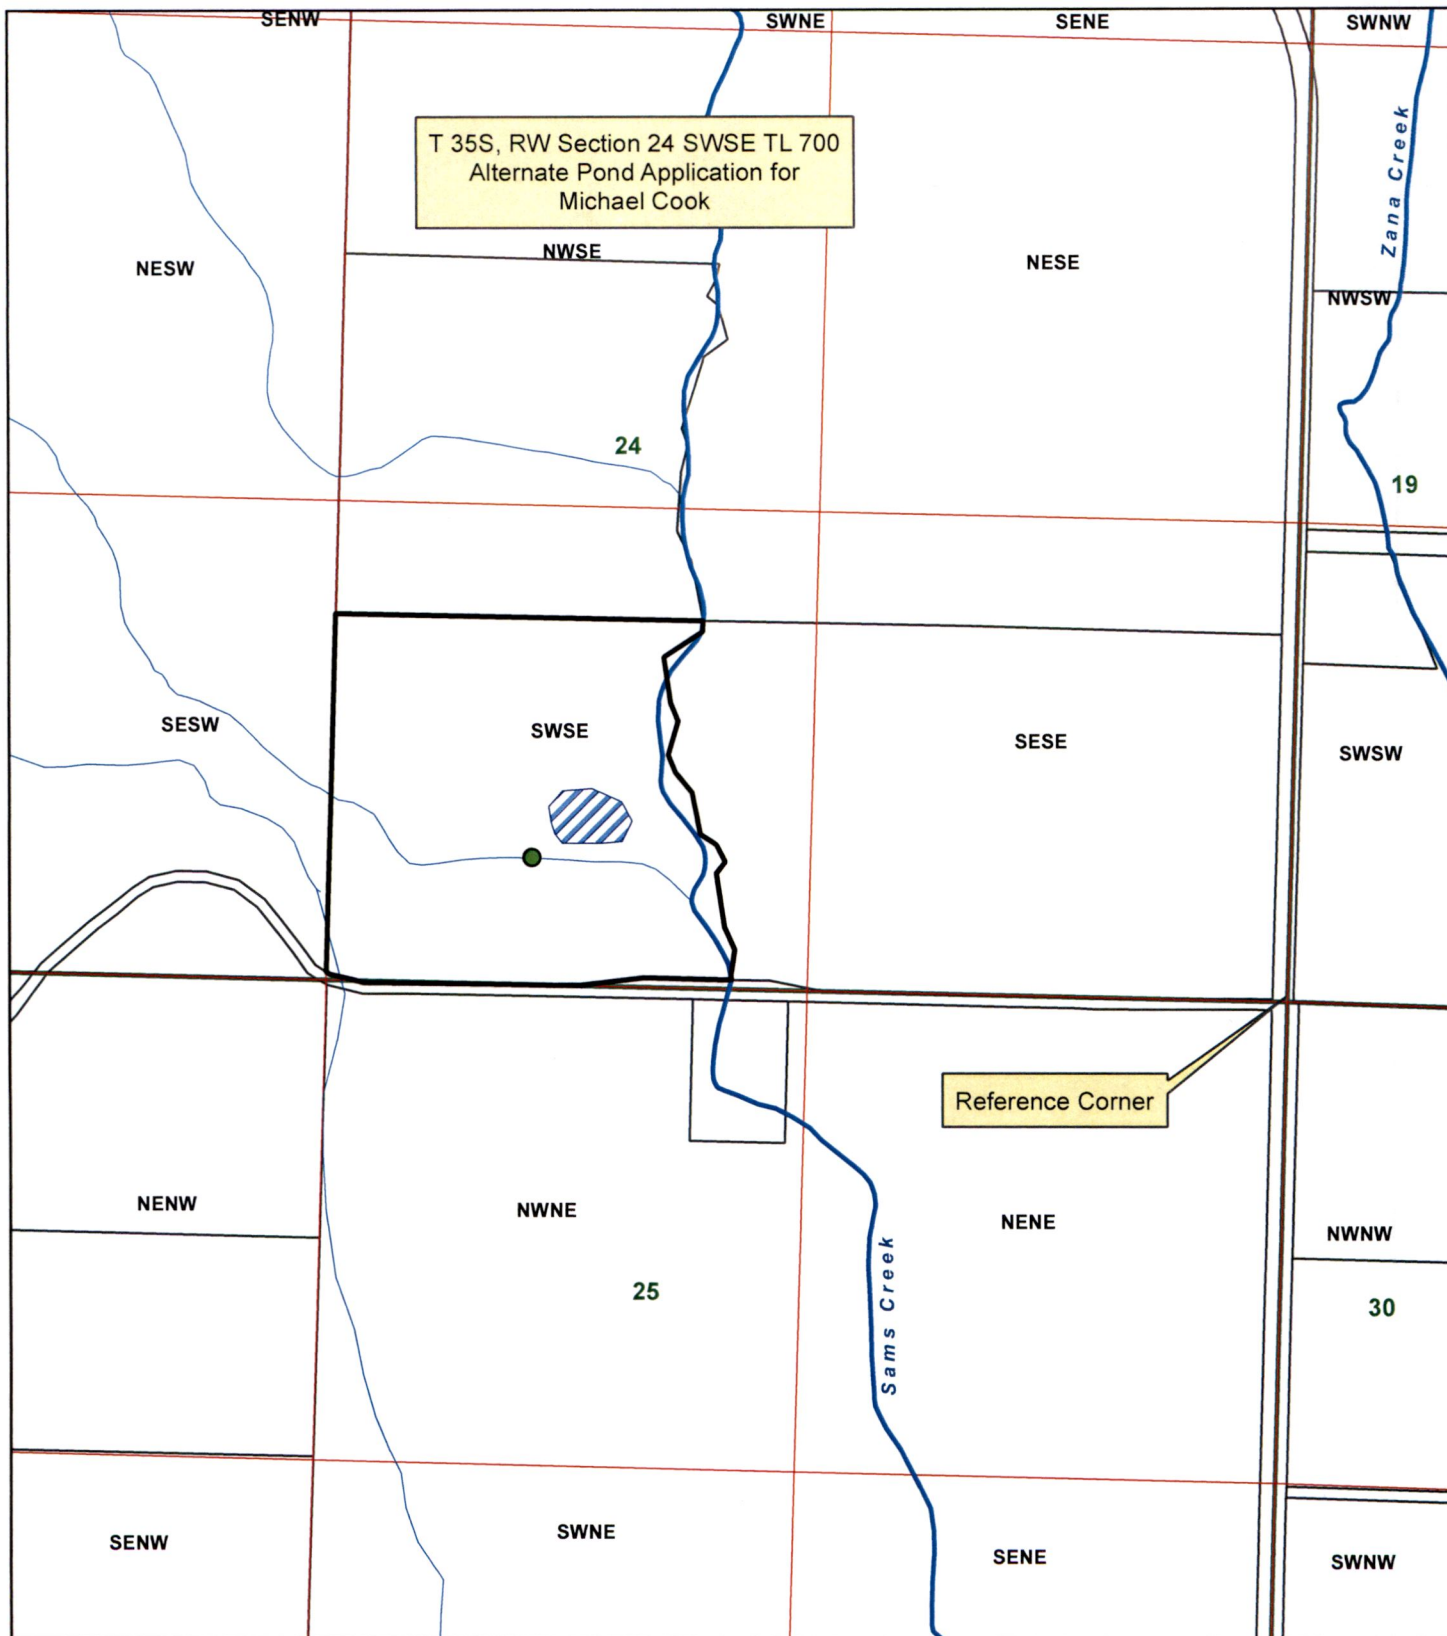


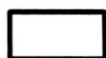

Legend

-  TL 700
-  POD 1
-  Cook Pond

Dam:
2130 West and
343 N from SE Corner
Section 24

POD 1:
1823 West and
413 N from SE Corner
Section 24



1 inch = 500 feet

RECEIVED

MAR 23 2018




JACKSON COUNTY
SHAVON HAYNES

This map is based on a digital database compiled by Jackson County from a variety of sources. Jackson County cannot accept responsibility for errors, omissions, or positional accuracy. There are no warranties, expressed or implied.


Date: 09/25/2017 35-3W-24 SWSE TL 700 M Cook.mxd haynes

R-88568

OWDD

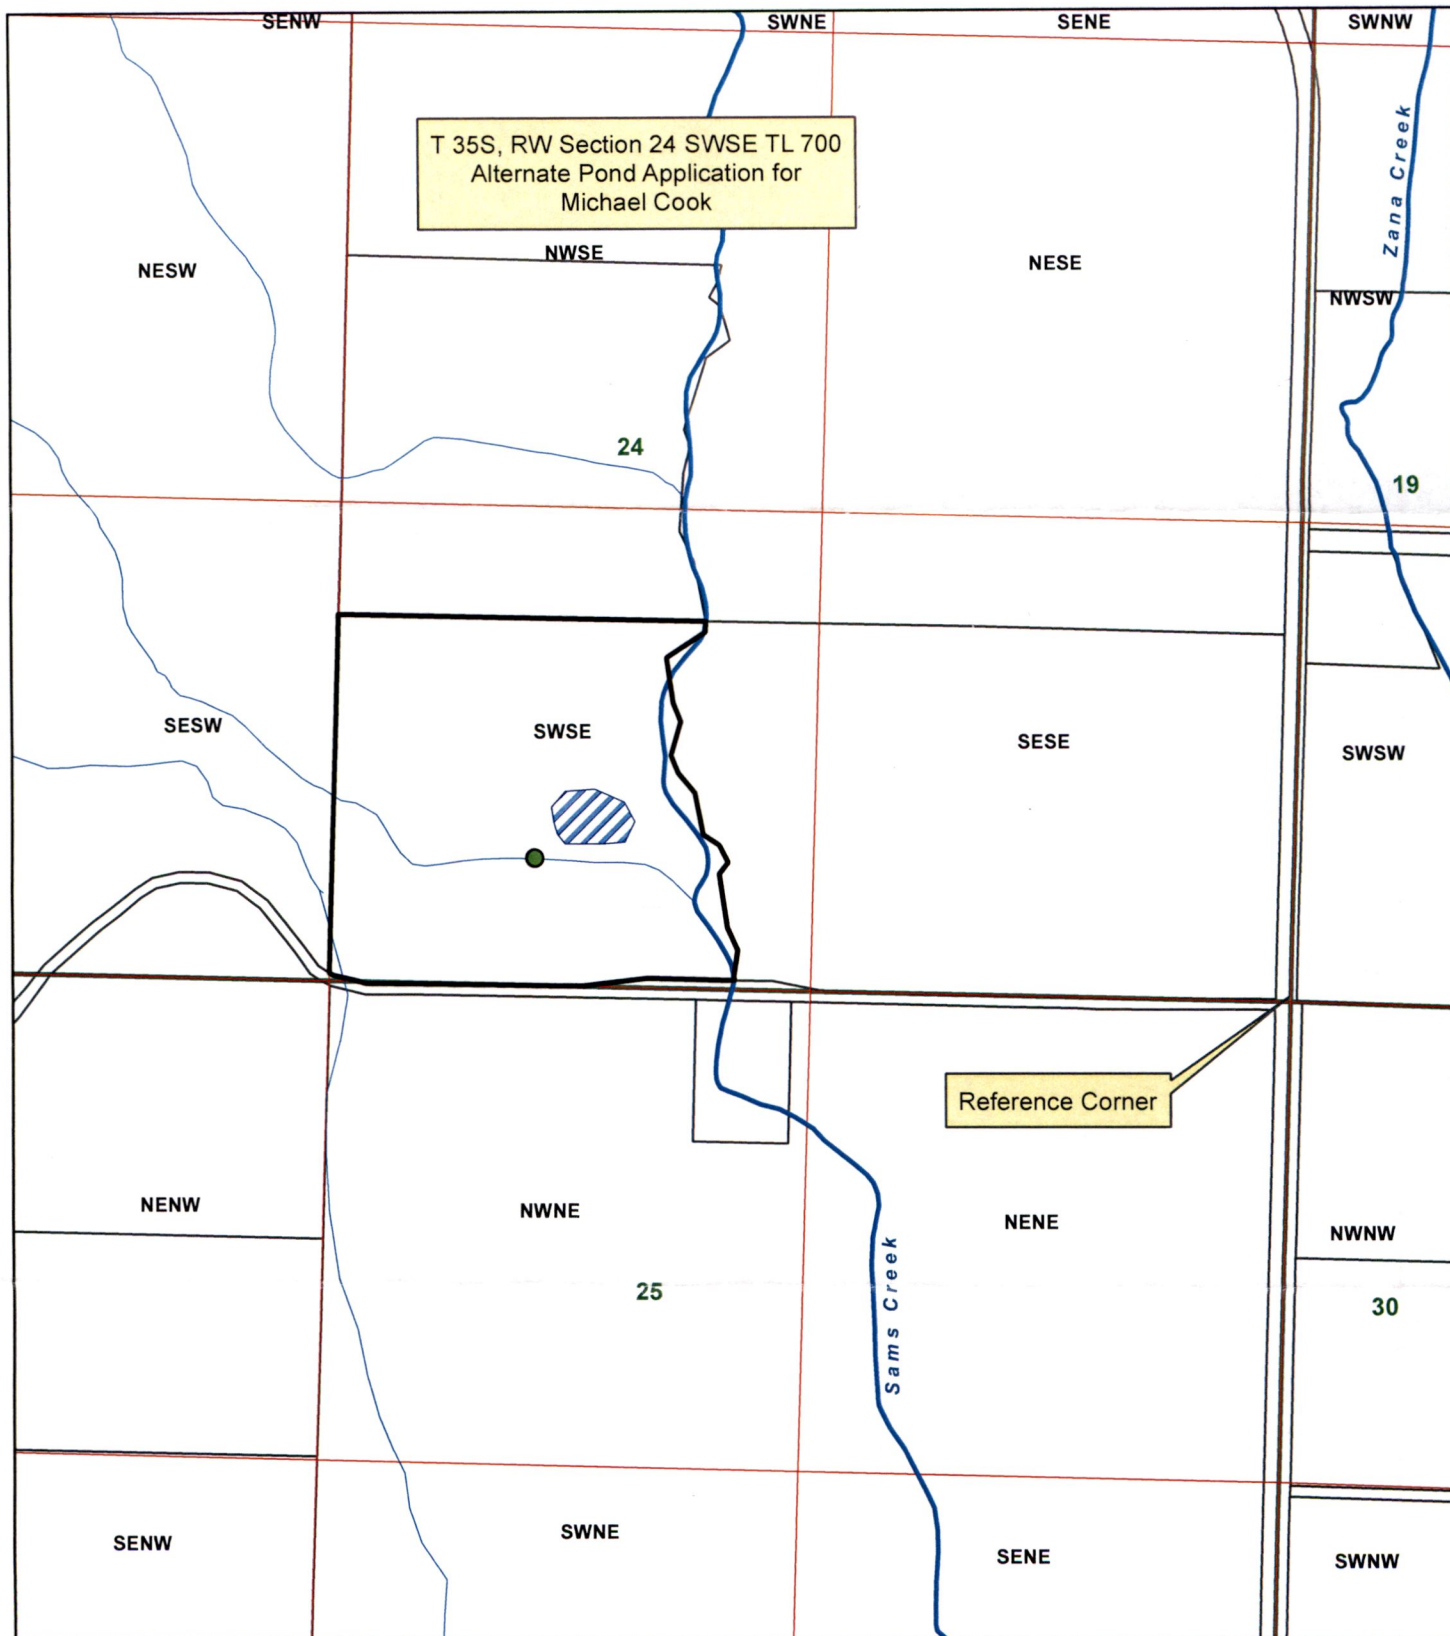

Legend

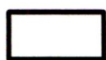-  TL 700
-  POD 1
-  Cook Pond

Dam:
2130 West and
343 N from SE Corner
Section 24

POD 1:
1823 West and
413 N from SE Corner
Section 24



1 inch = 500 feet
RECEIVED

MAR 23 2018





JACKSON COUNTY
SHAVON HAYNES

This map is based on a digital database compiled by Jackson County from a variety of sources. Jackson County cannot accept responsibility for errors, omissions, or positional accuracy. There are no warranties, expressed or implied.

Date: 09/25/2017: 35-3W-24 SWSE TL 700 M Cook.mxd haynes

R-88578

OWRD

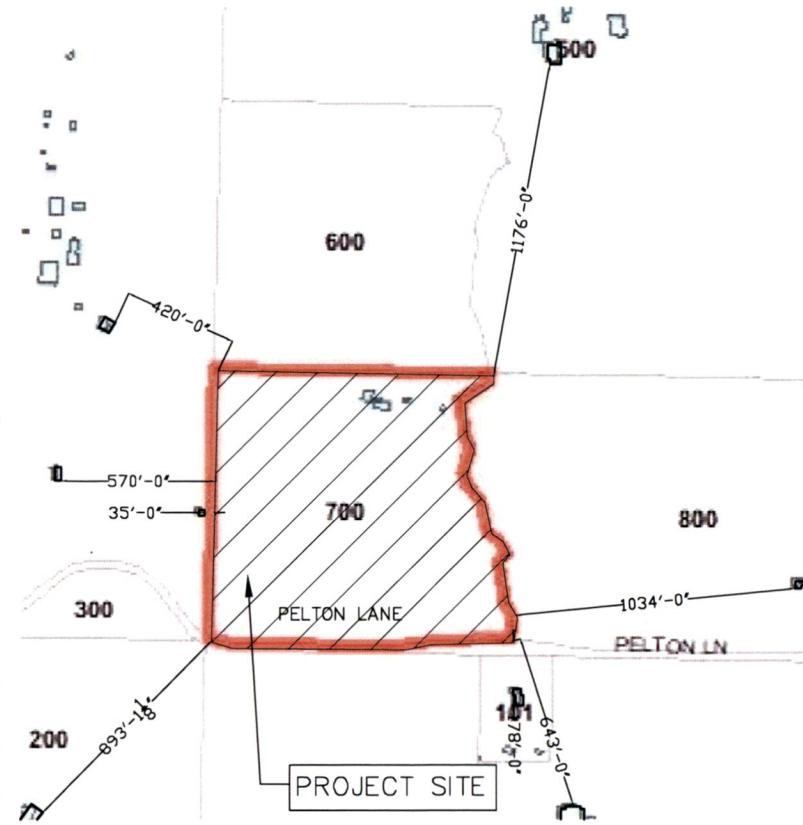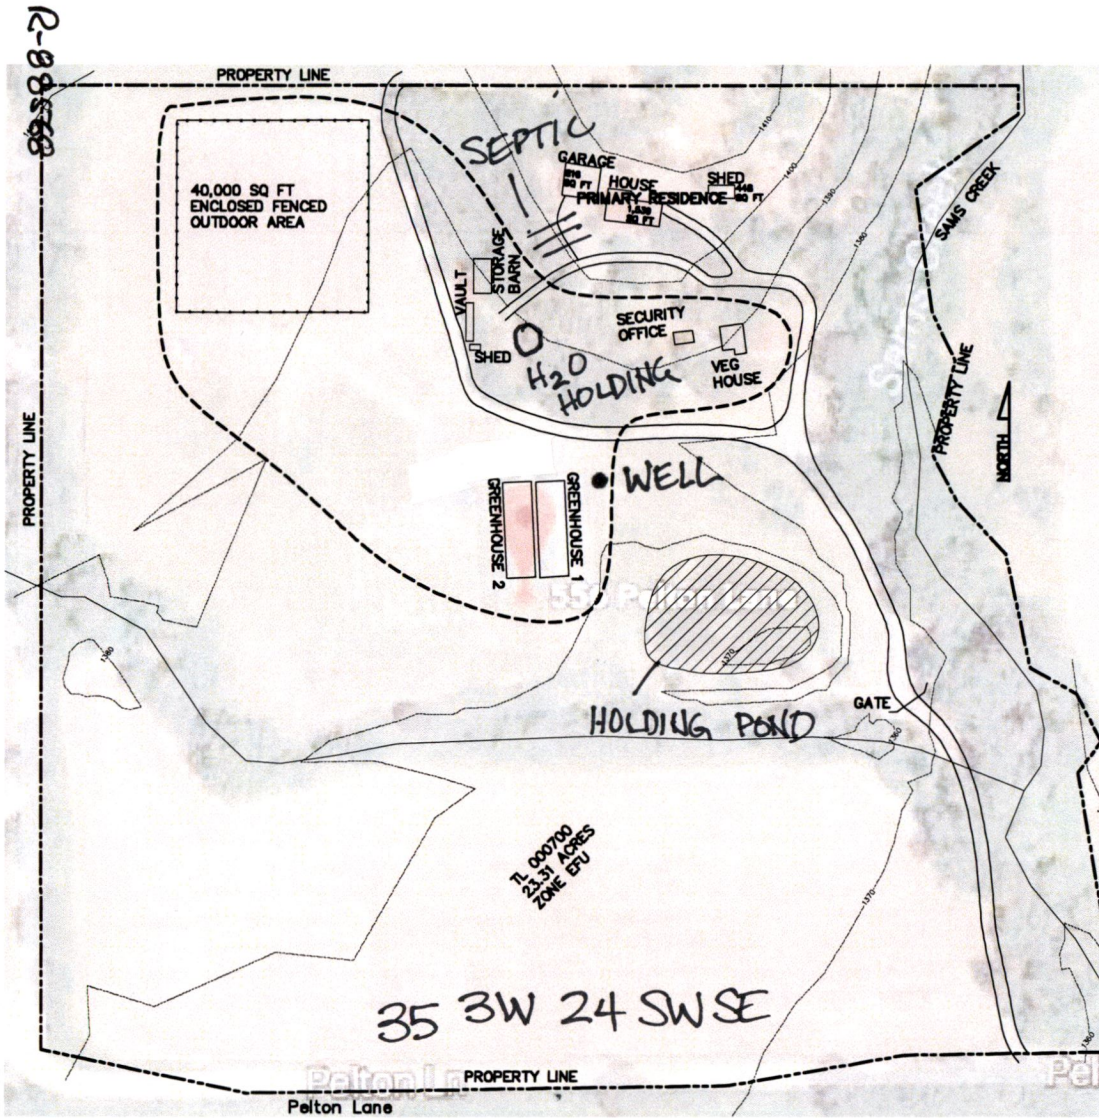

VICINITY MAP
SCALE : NTS

LEGEND	
SQ FT	SQUARE FOOTAGE
---	10' CONTOUR LINE
---	PROPERTY LINE
---	RESTRICTED AREA FENCELINE
---	CREEK
●	POND
---	LIMITED ACCESS AREA

SHEET NOTES:

1. THIS DRAWING IS INTENDED FOR JACKSON COUNTY LUCS AND OLCC APPLICATION PURPOSES
2. EXISTING OUTBUILDINGS INTENDED TO SUPPORT ARE NOT SUBJECT TO THIS APPLICATION
3. ALL AREAS WHERE CANNABIS ARE GROWN, DRIED, CURED, PROCESSED AND STORED ARE LIMITED ACCESS AREAS
4. REFER TO SEPARATE MECHANICAL PLAN FOR ADDITIONAL INFORMATION
5. REFER TO SEPARATE SECURITY PLAN FOR ADDITIONAL INFORMATION
6. ALL FENCES AND GROW AREAS ARE SETBACK A MINIMUM OF 30' FROM FRONT LOT LINE ALONG PELTON LANE AND 10' FROM SIDE LOT LINES OF NON CONTIGUOUS OWNERSHIP

OWRD

MAR 23 2018

RECEIVED