


Streams except in the vicinity of irrigated land are sketched in the approximate location

Scale of Feet.


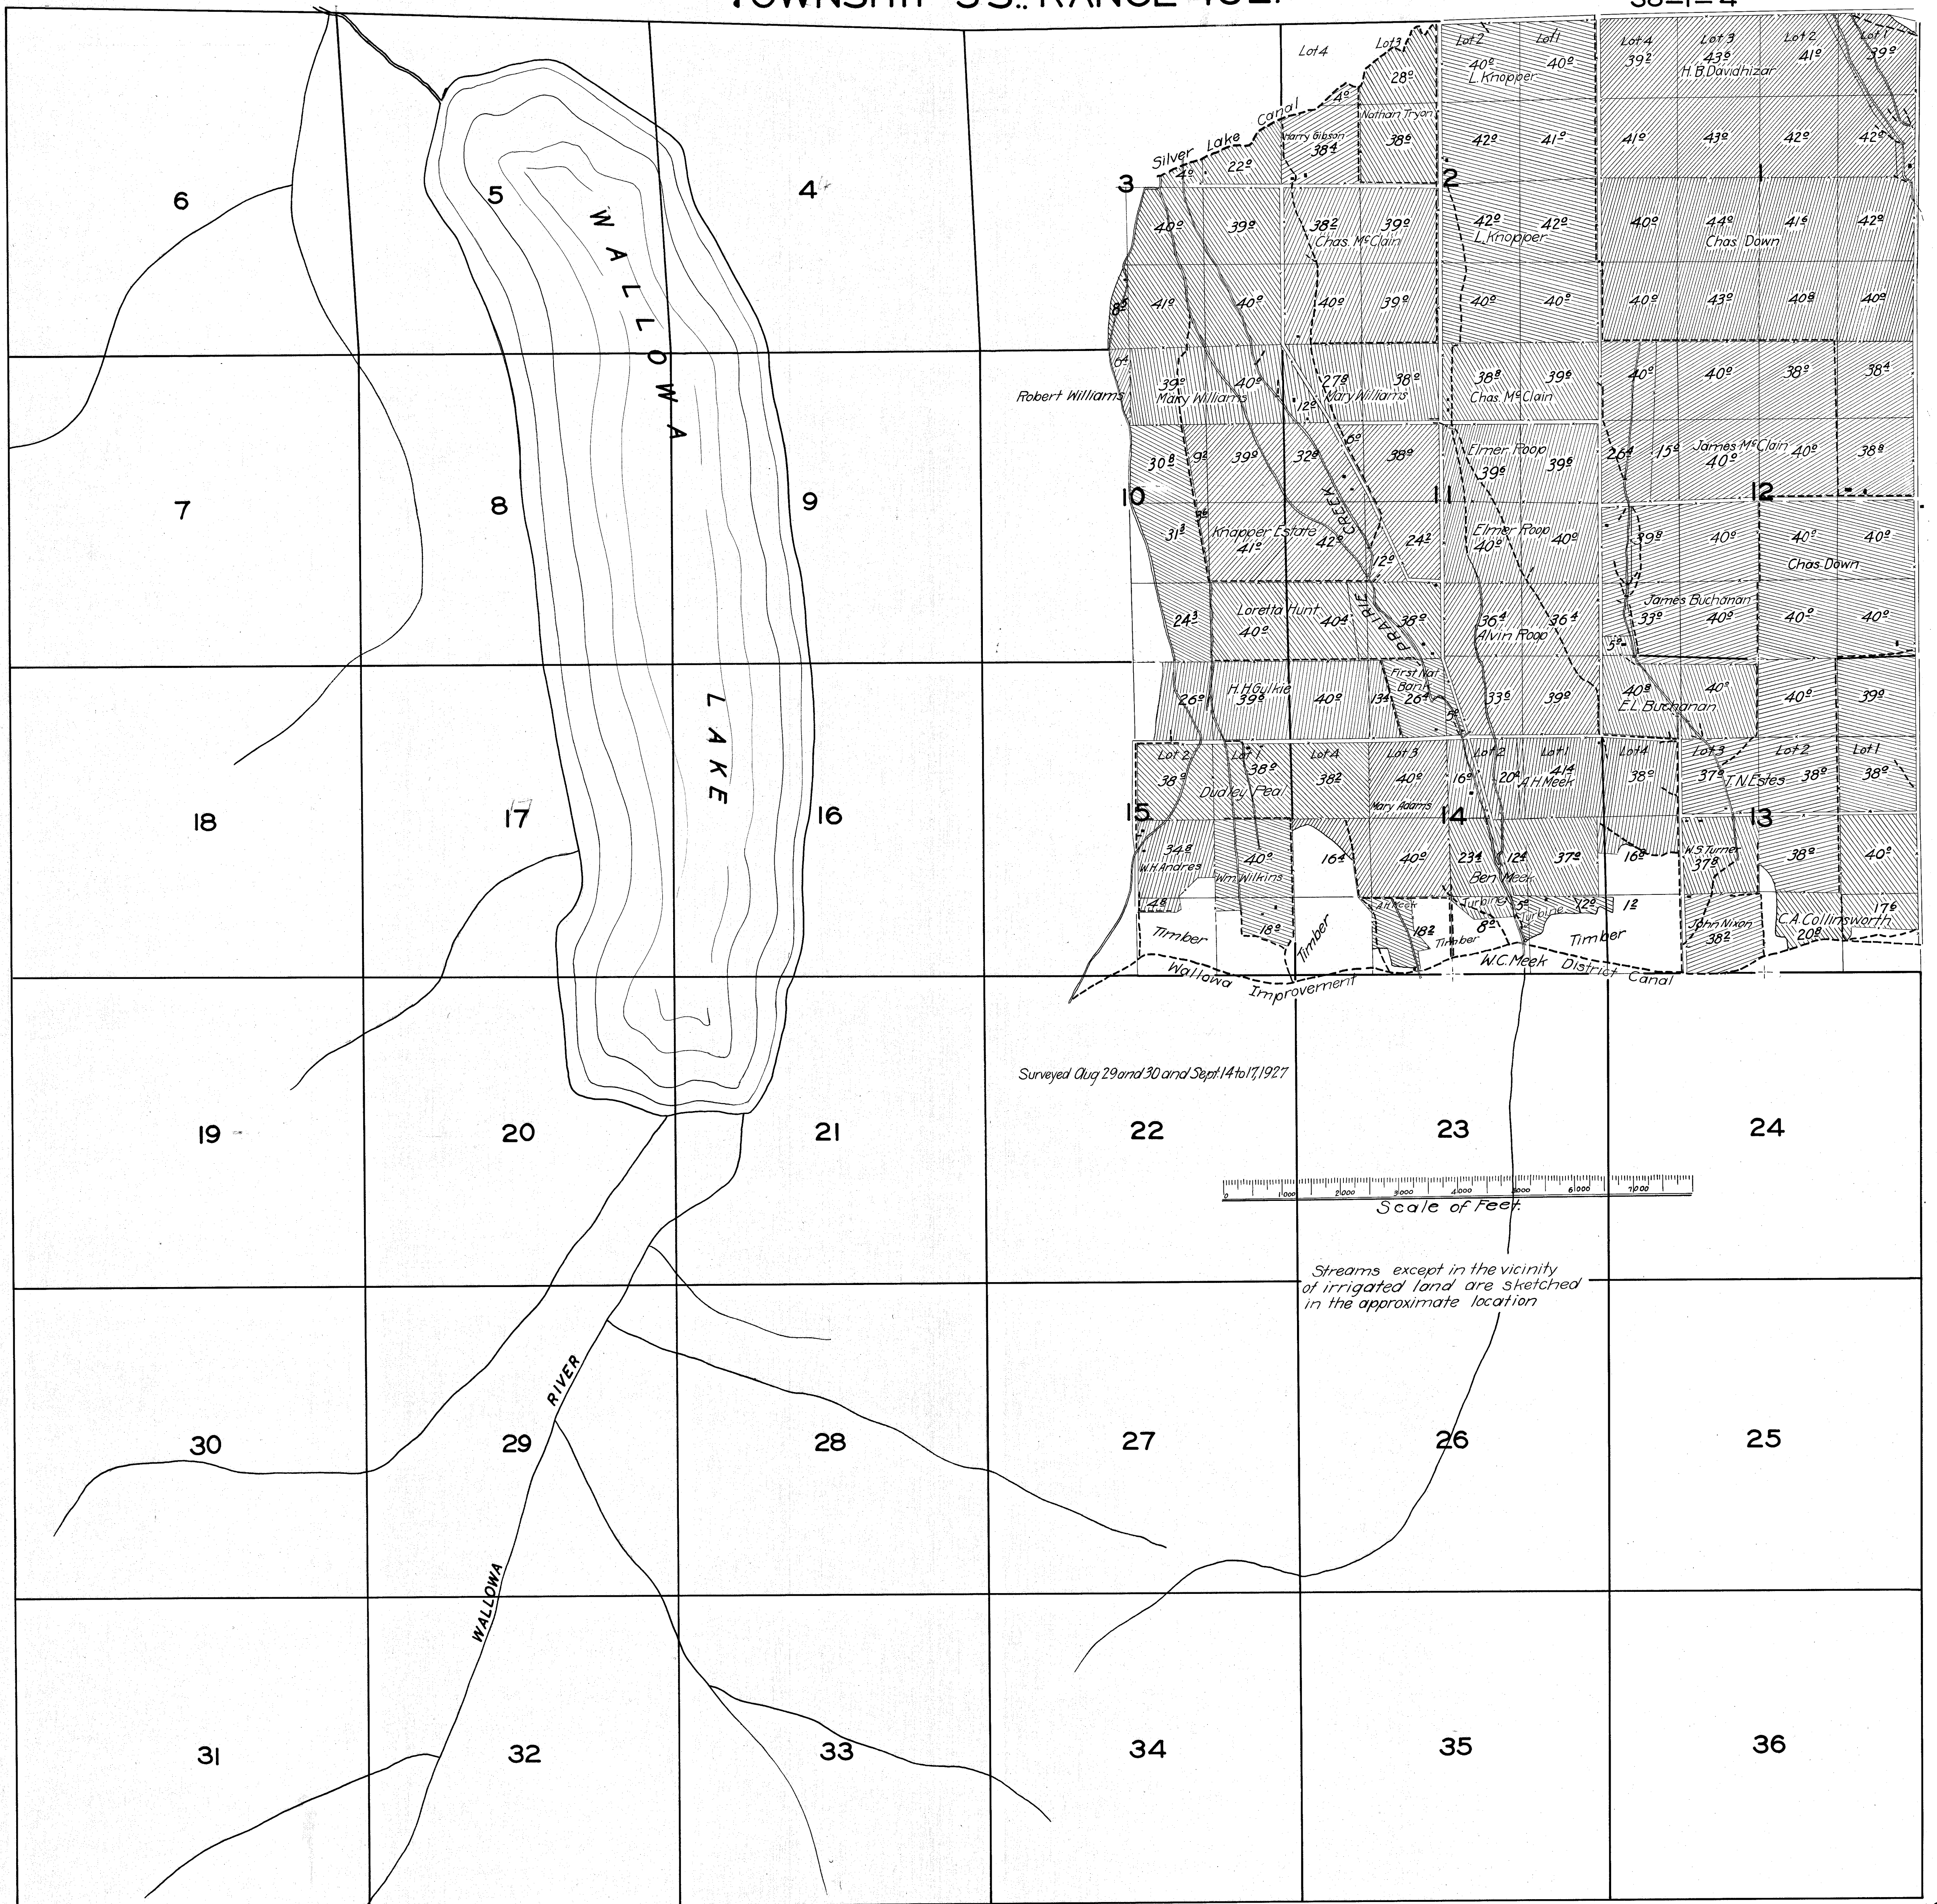

TOWNSHIP 3 S. RANGE 46 E.

39-1-4

