



Township 25 S, Range 32 E

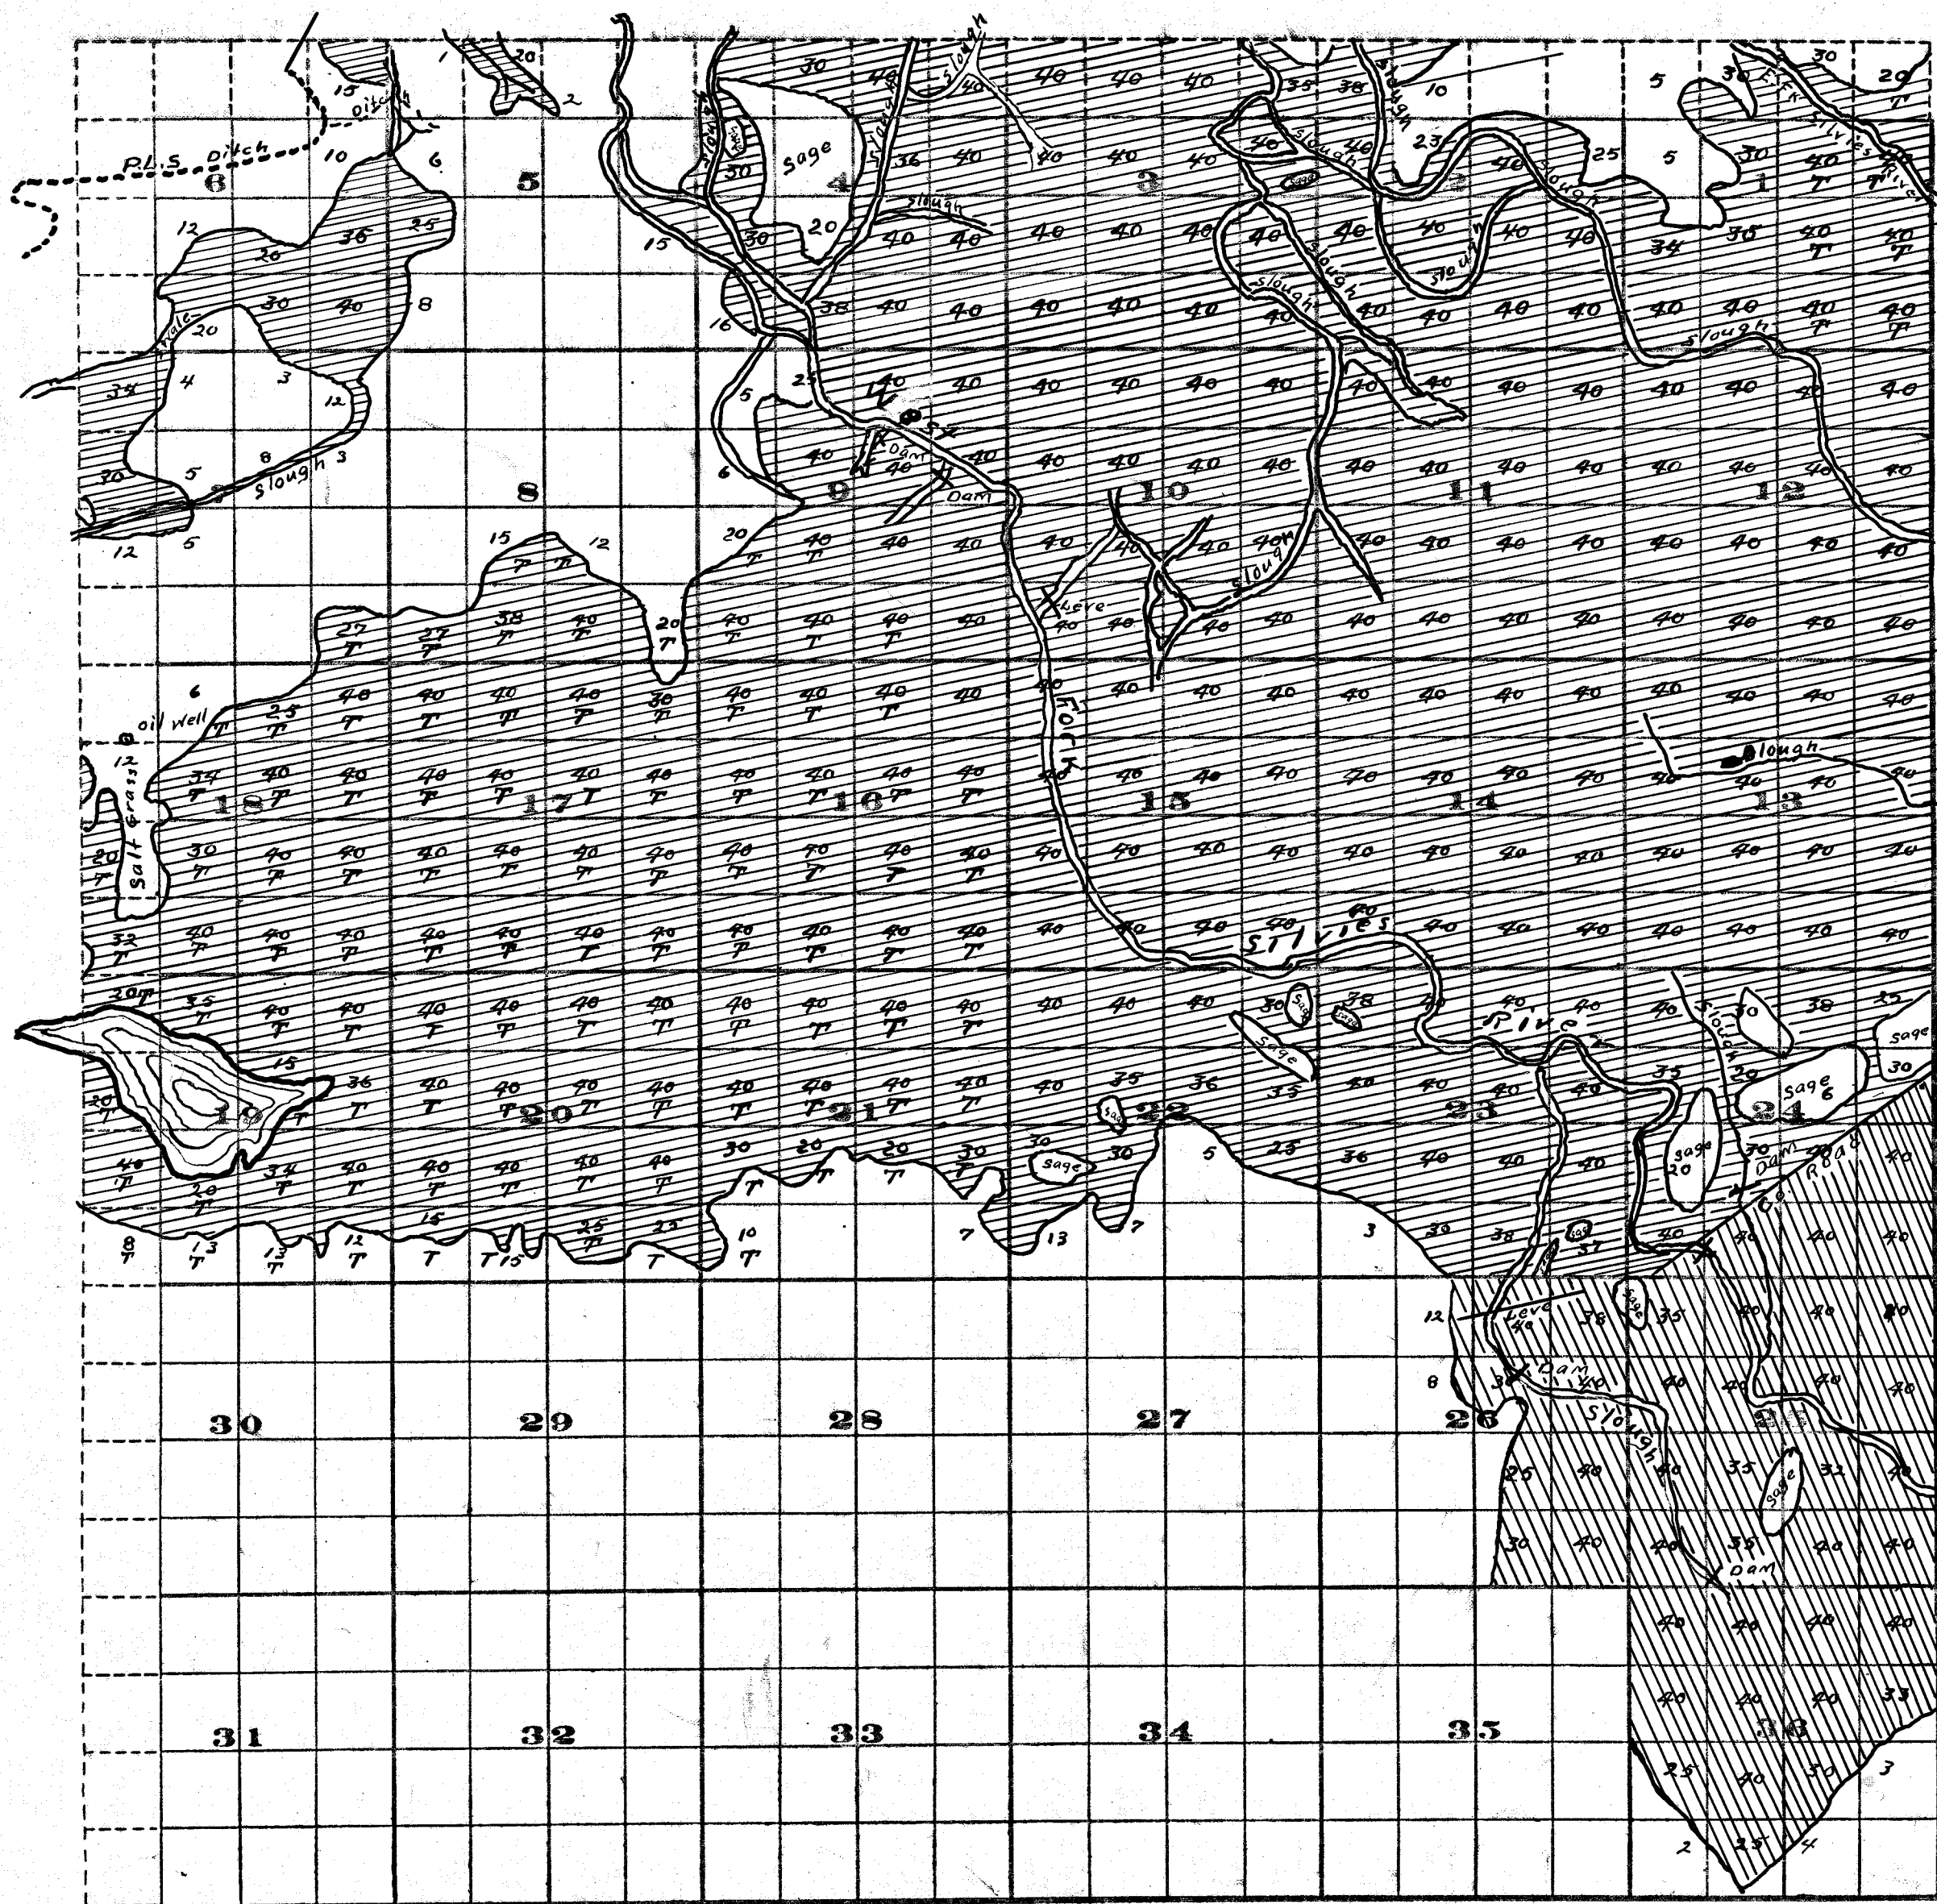

Survey By H.K. Donnelly Aug 1912

FROM OFFICE OF THE STATE ENGINEER, SALEM, OREGON

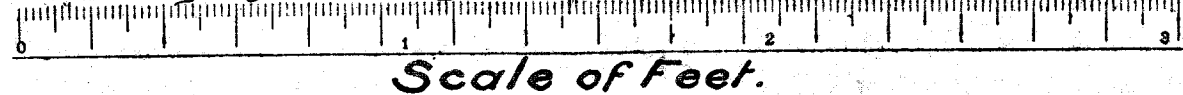

ADJUDICATION
OF
SILVIE RIVER & TRIBUTARIES

John H Lewis State Engineer

Examined Aug 22 1912