


OWYHEE IRRIGATION DISTRICT

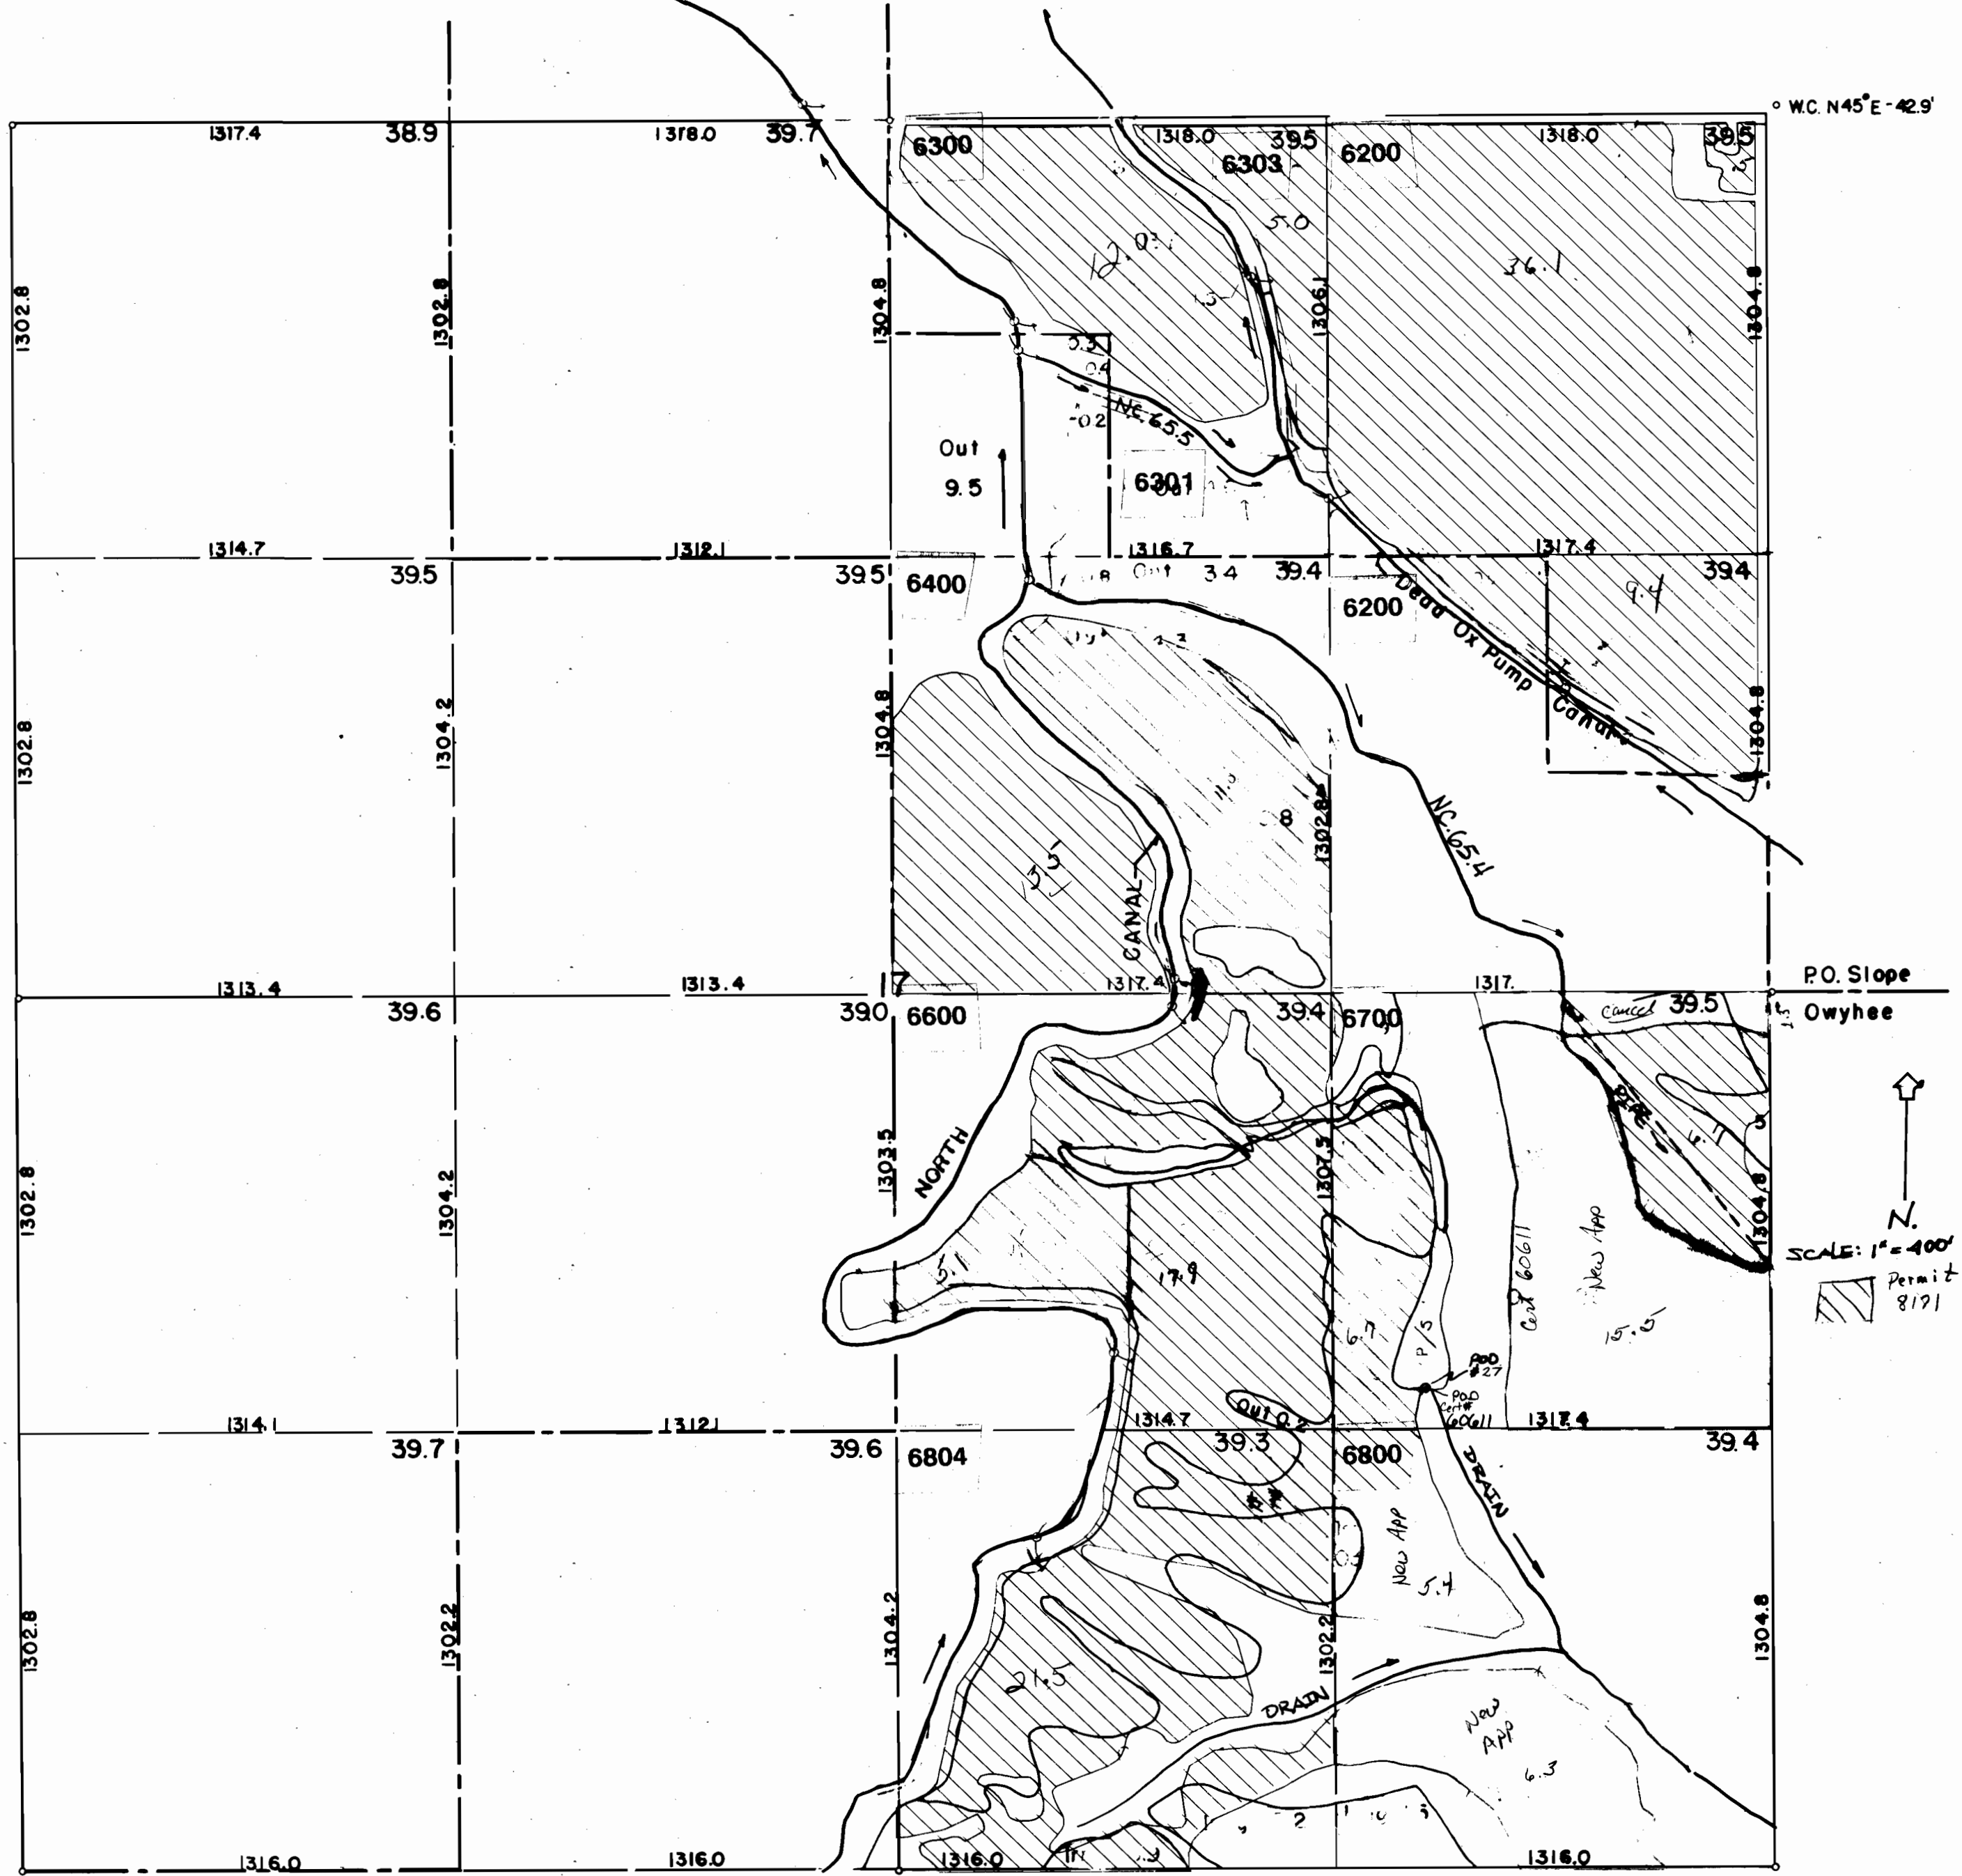

° WC N45° E - 42.9'

P.O. Slope
Owyhee

N
SCALE: 1" = 400'
Permit # 8191

SEC. 17 - T. 16 S. - R. 47 E
48-102-1347