OWYHEE IRRIGATION DISTRICT

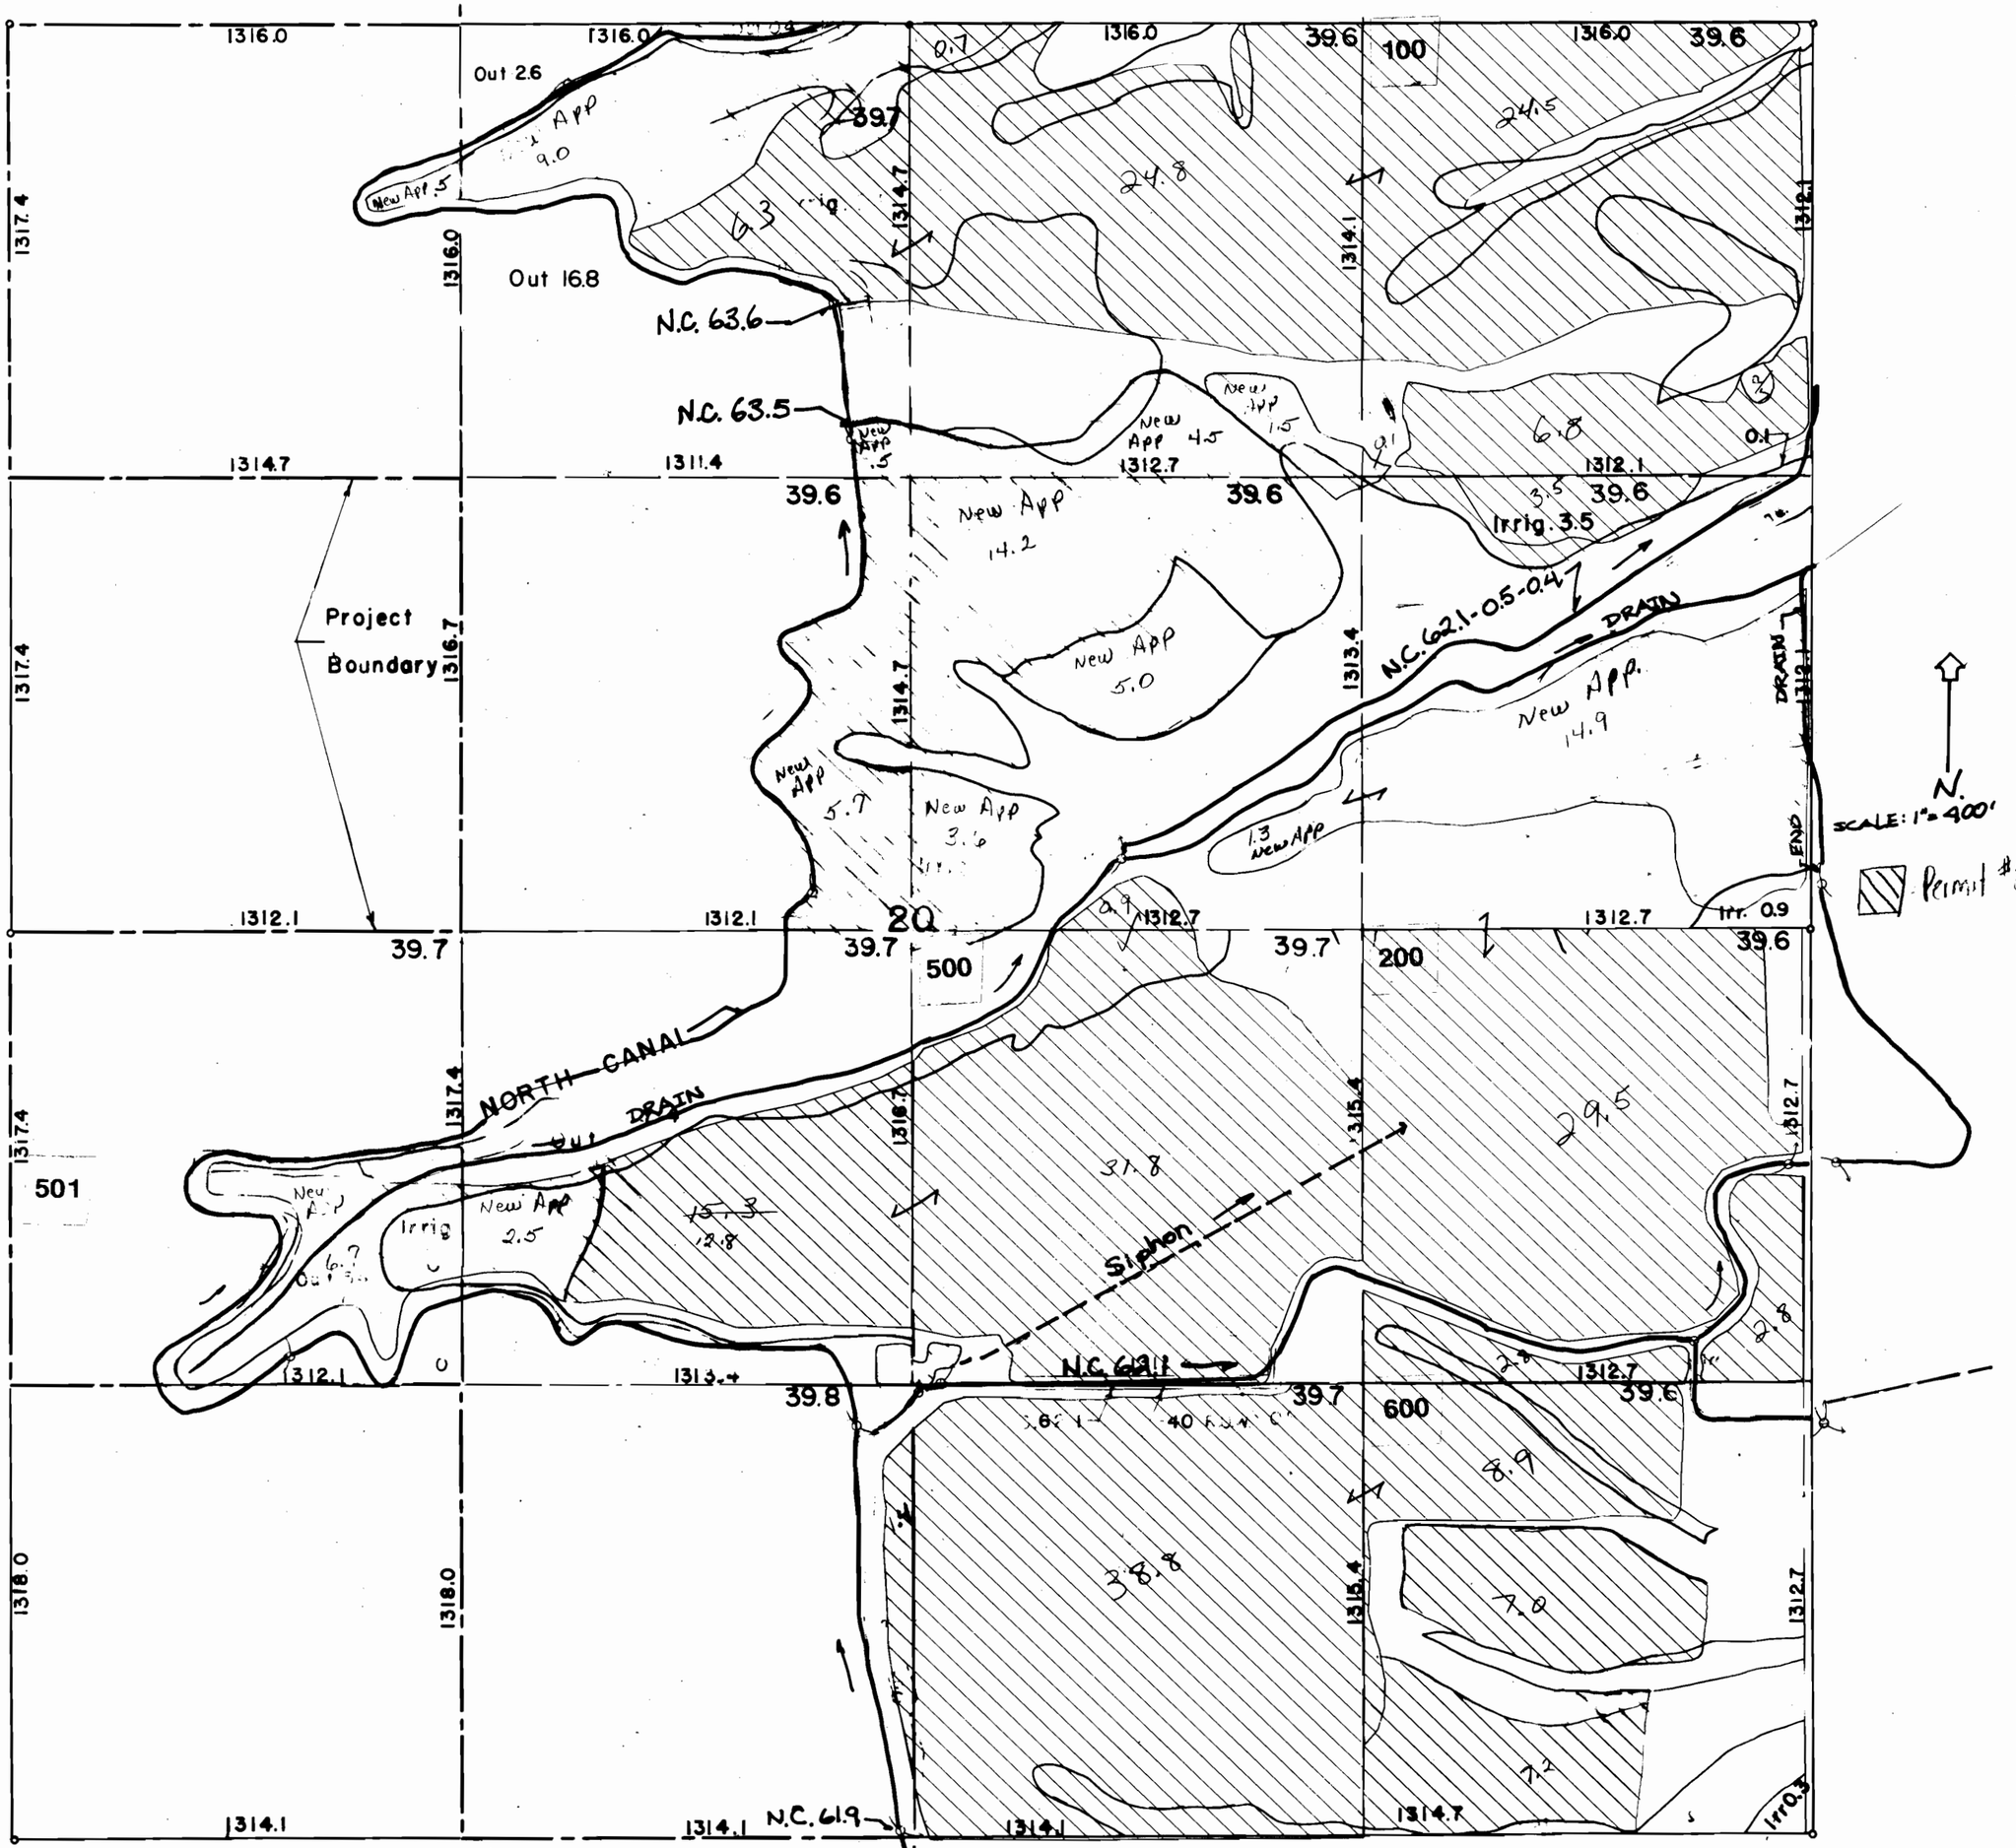

REVISED 12-96