OWYHEE IRRIGATION DISTRICT

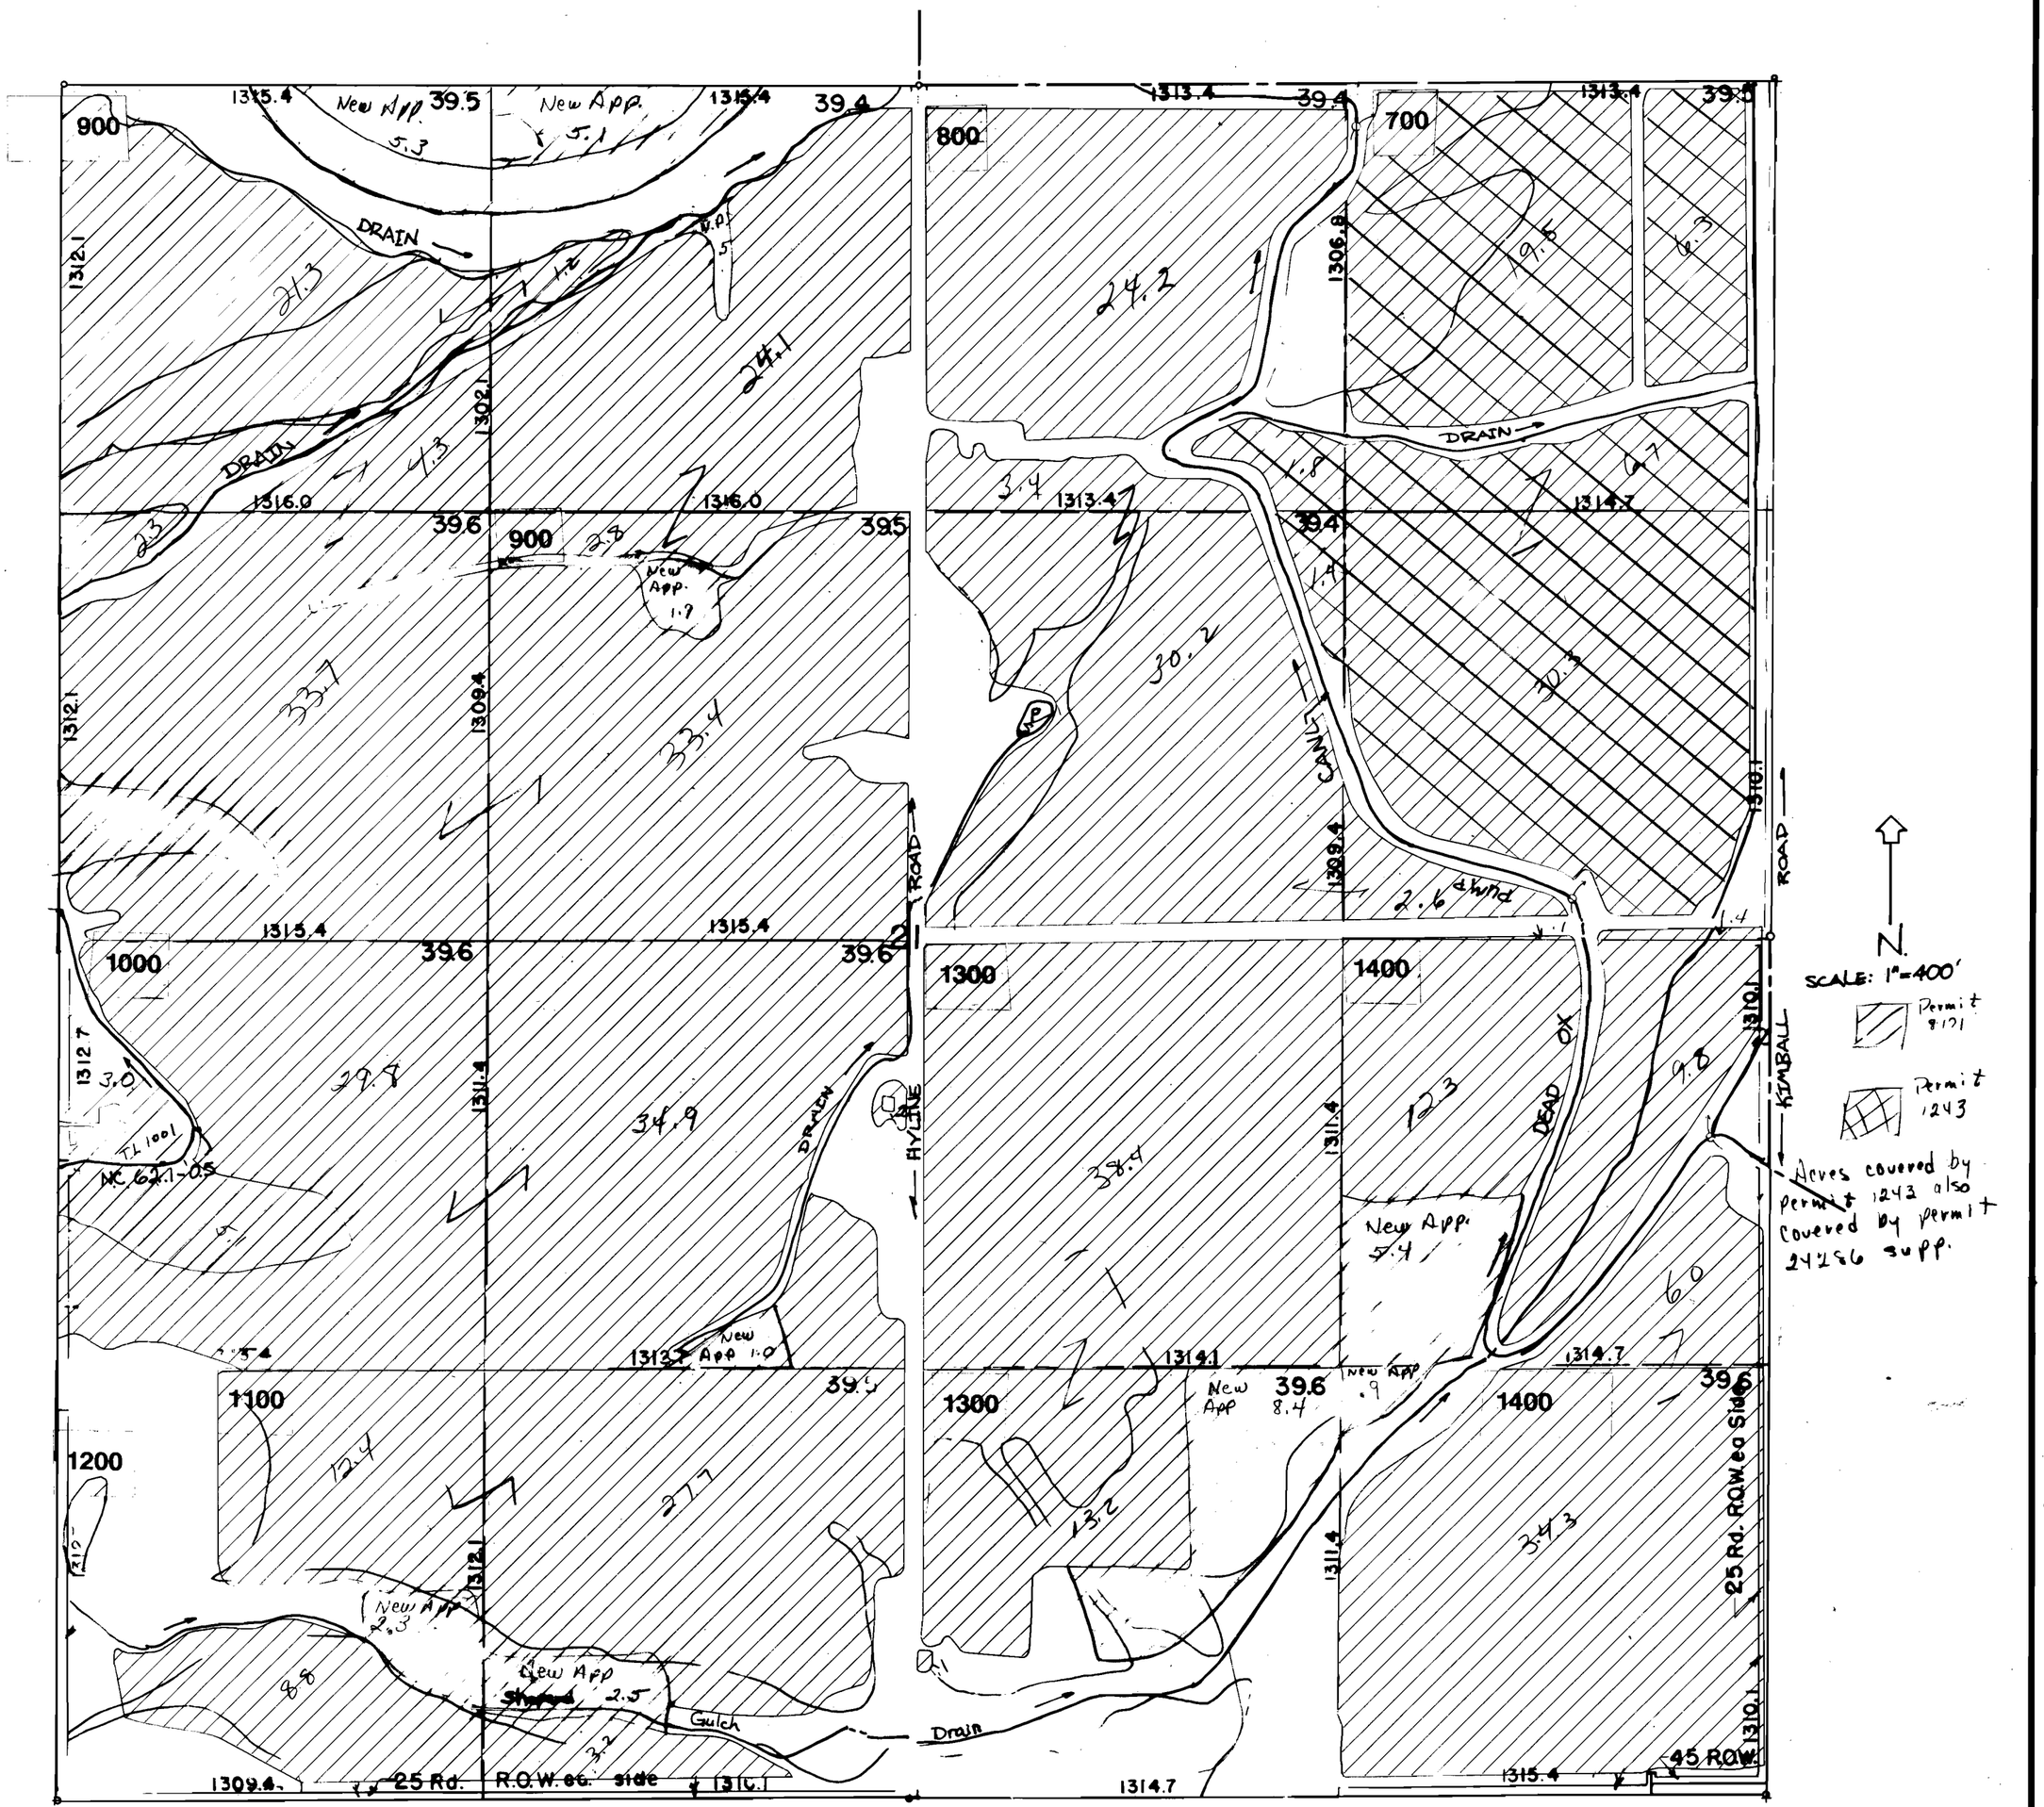

SEC. 21 - T. 16 S. - R. 47 E

48-102-1350

REVISED 12-96