


OWYHEE IRRIGATION DISTRICT

WC. N45°W 436'

WC. N45°E 462'

WC. S45°W 409'

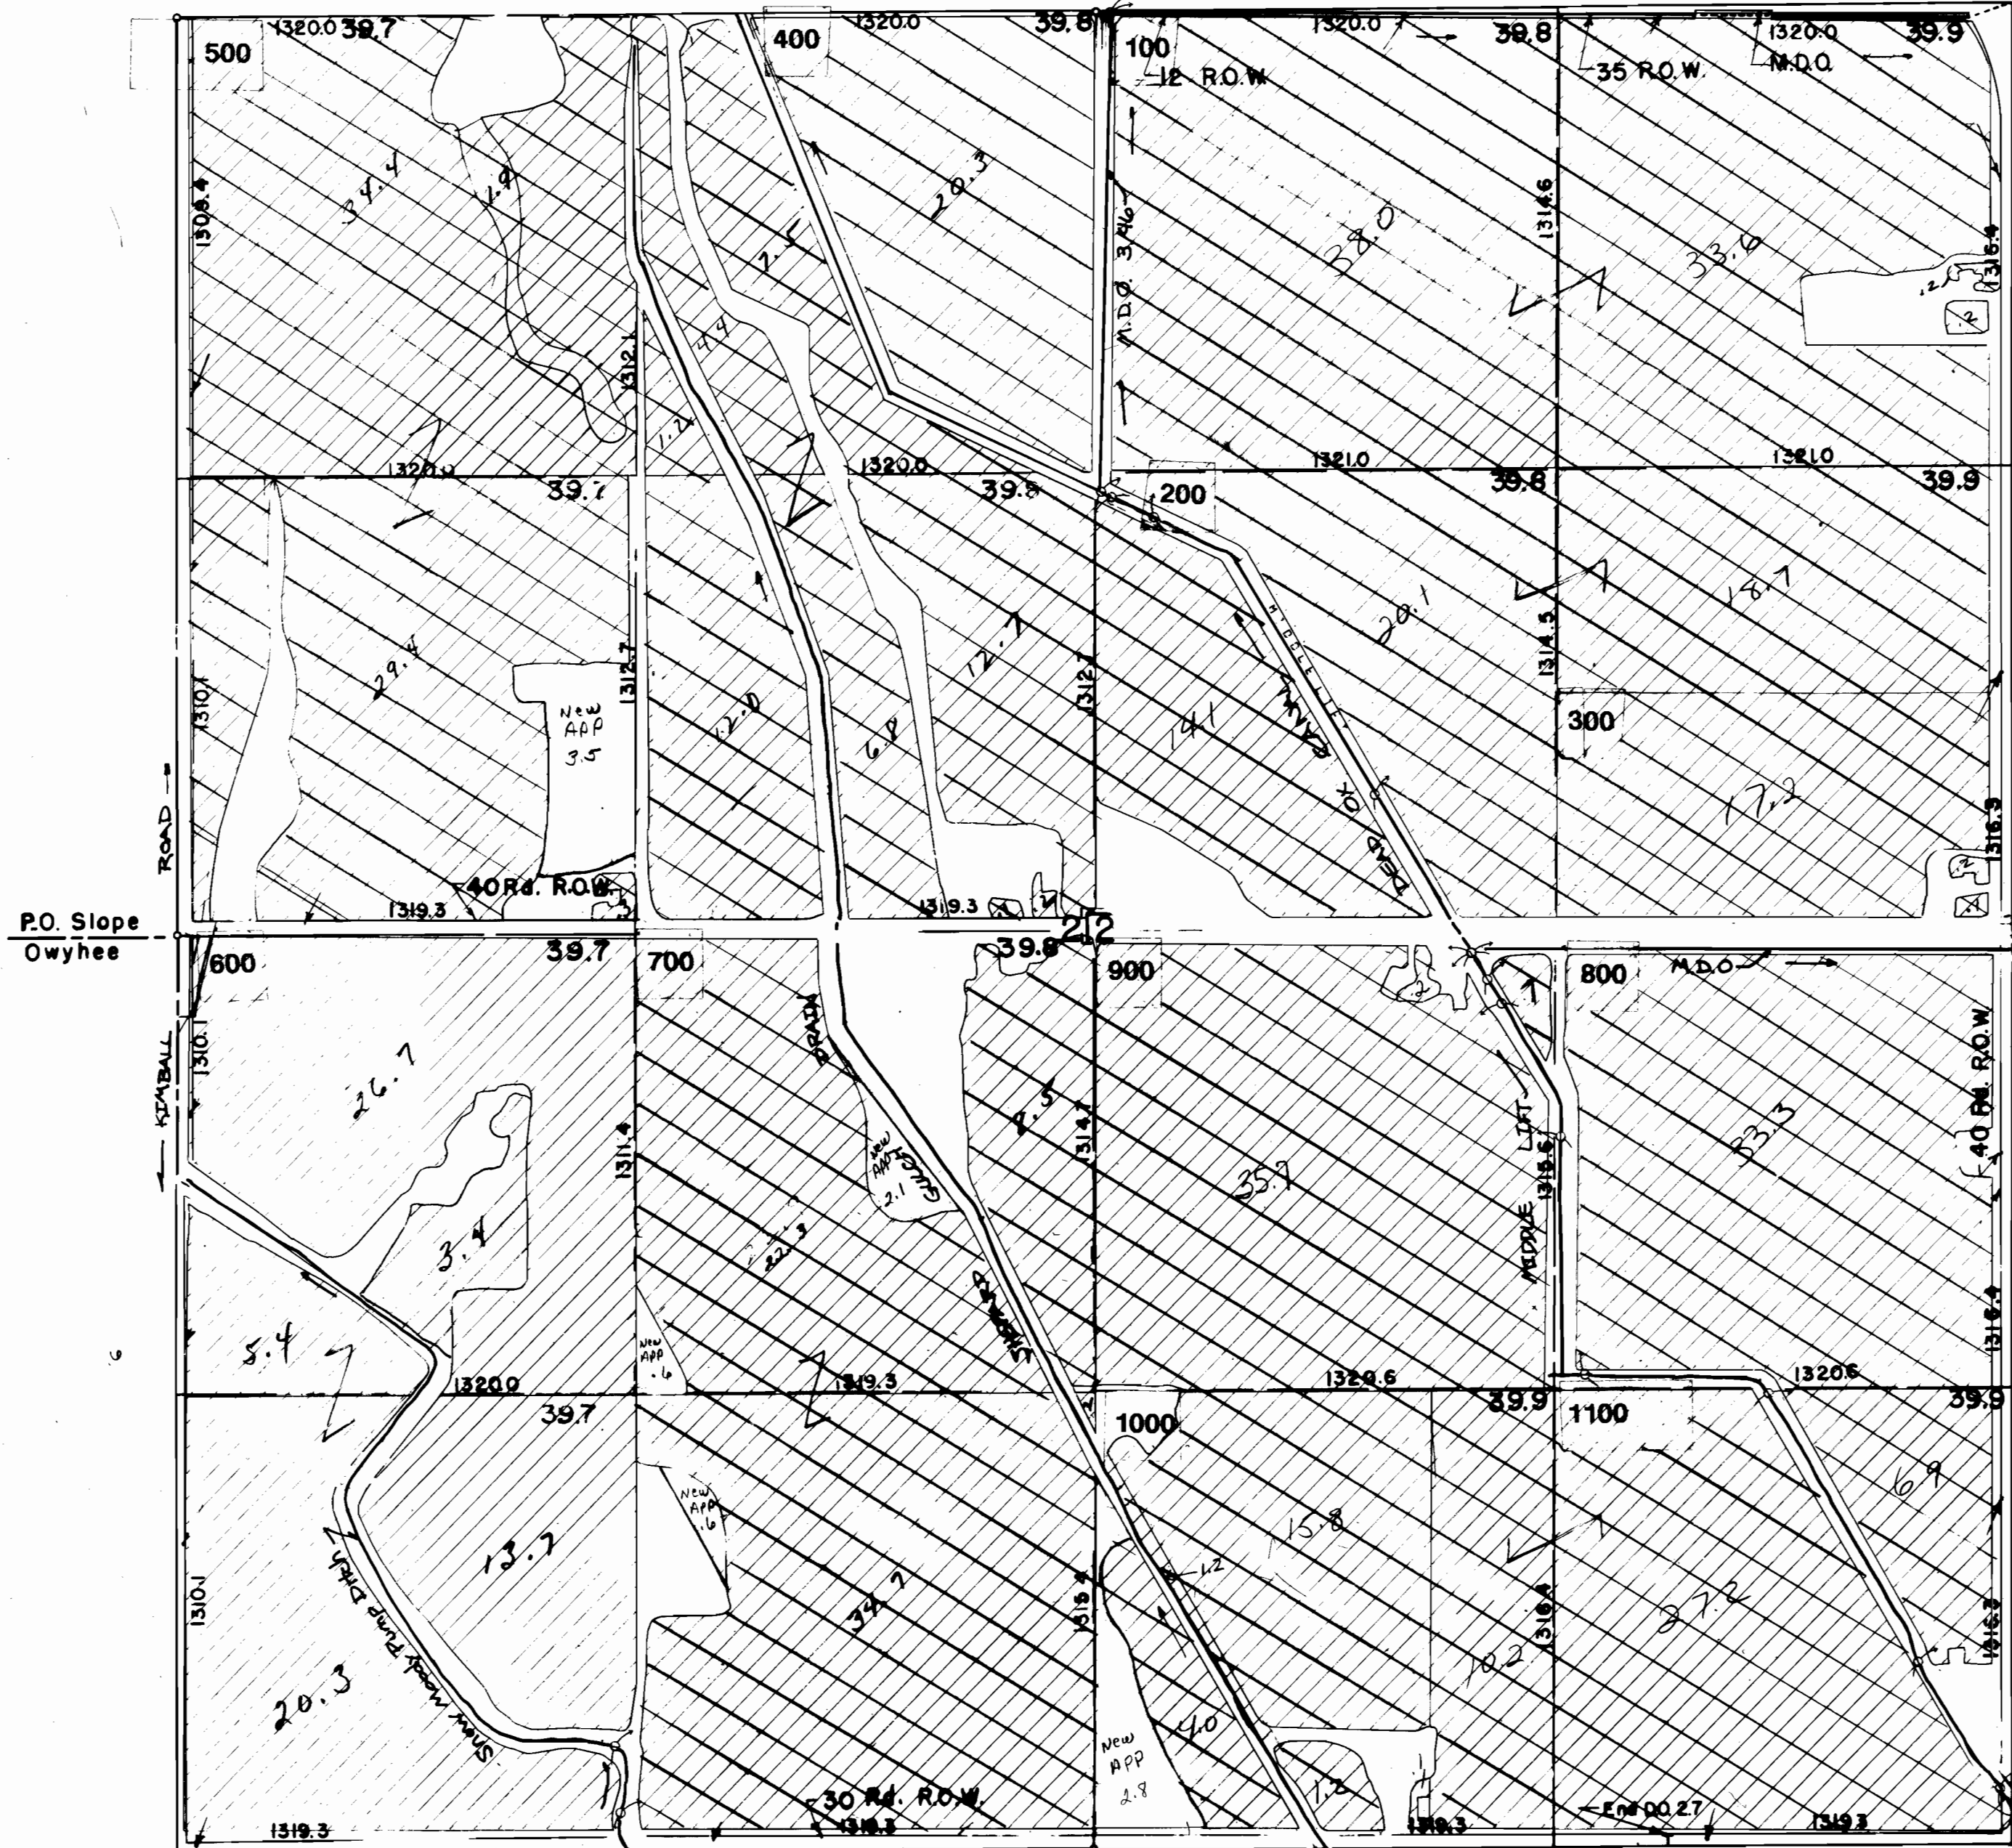

P.O. Slope Owyhee

P.O. Slope Owyhee

↑
N

SCALE: 1" = 400'

Permit 8121
 Permit 1243
 Acres covered by Permit 1243 also covered by Permit 24286 suppl.

SEC. 22 - T. 16S. - R. 47E.

48-102-1351