


Township 24 S, Range 32 E.

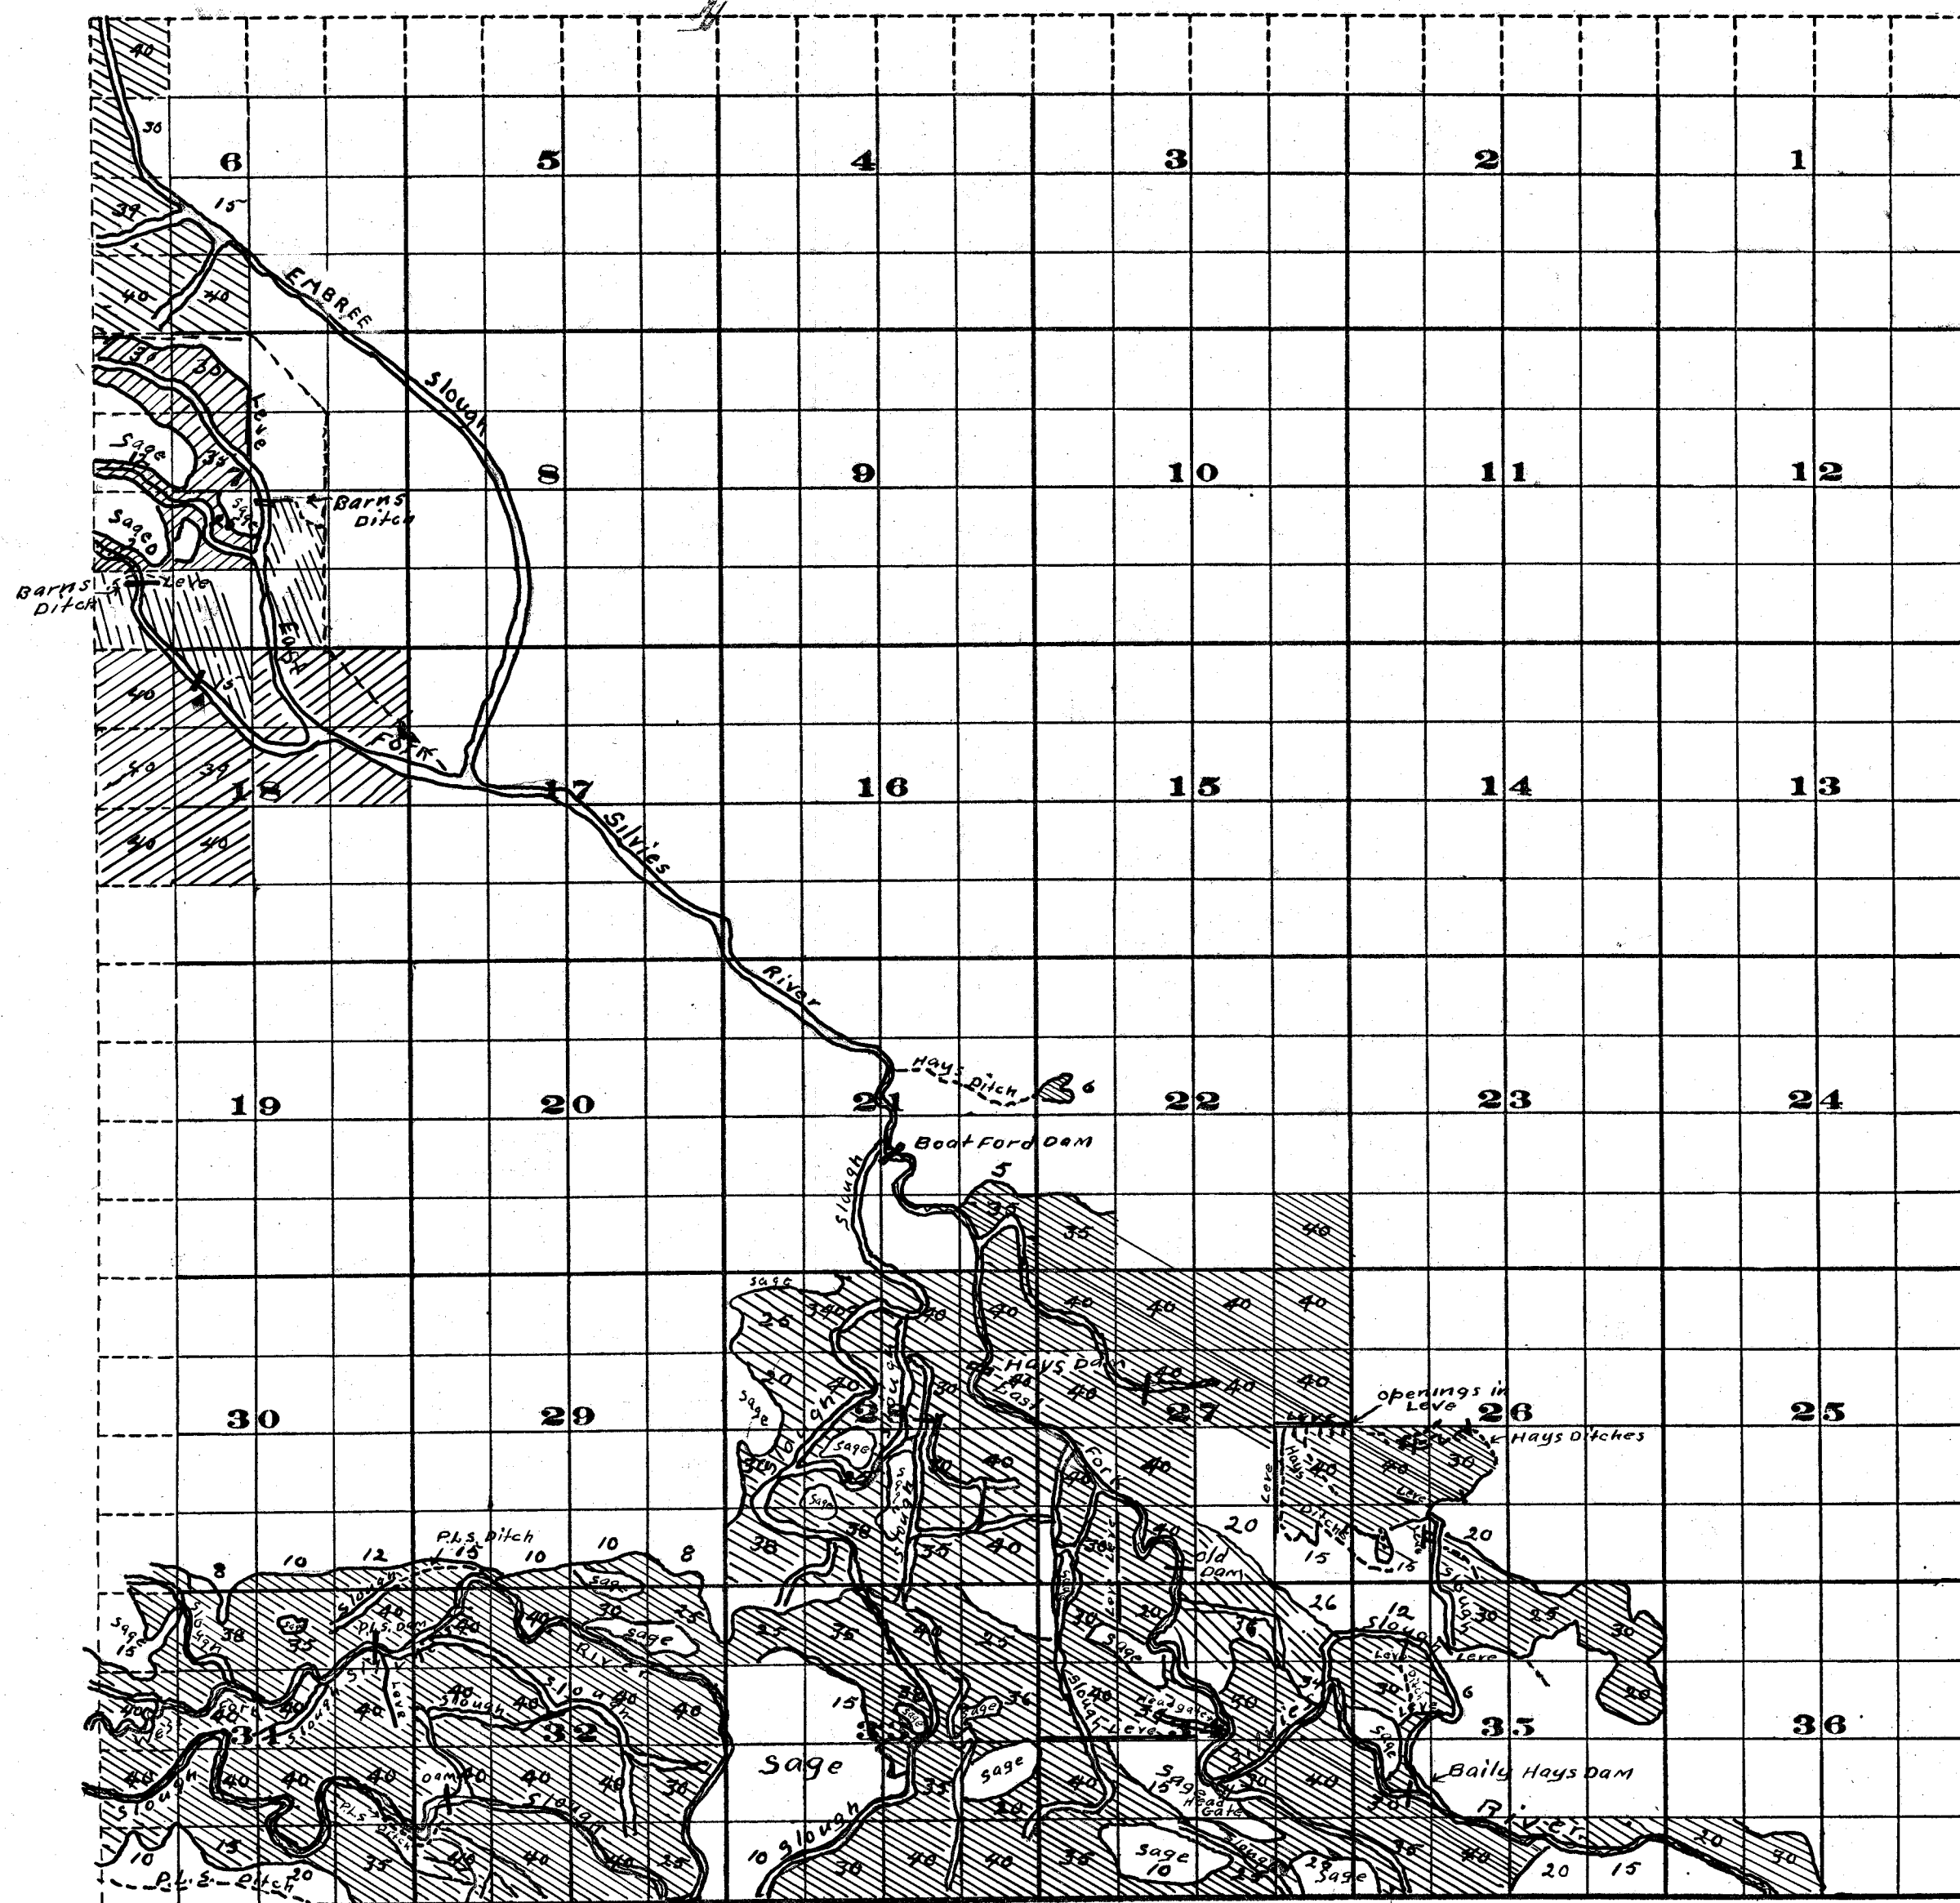

Survey By H.H. Donnelly Aug. 1912 & R.D. Cooper Aug. 1912

FROM OFFICE OF THE STATE ENGINEER, SALEM, OREGON

Scale of Feet.

ADJUDICATION
OF
SILVIES RIVER & TRIBUTARIES

John H Lewis State Engineer

Examined Aug 22 1912