

RECEIVED

APR 11 2018

OWRD

New Water Right Applications require a map, meeting certain standards, accompany the application. The map standards are governed by Oregon Administrative Rule 690-310-0050. Below is an example of each requirement on a sample map. (NOTE: Maps may vary in their appearance, but must all contain the minimum required elements.)

- A) Township, Range and Section
- B) North Directional Symbol
- C) Even Scale no smaller than 1" = 1320'
- D) Tax Lots Identified
- E) 1/4, 1/4 Public Land Survey subdivision identified
- F) Public Land Survey reference corner
- G) Hachures to identify place of use
- H) For irrigation or nursery uses, number of acres to be irrigated in each 1/4, 1/4 Public Land Survey subdivision
- I) Well or Diversion and conveyance line to place of use
- J) Description of the location of the well or surface water diversion, referenced to a Public Land Survey reference corner



RECEIVED

DEC 04 2017

OWRD

A → T 11 S, R 4 W, Sections 7 & 8

C → 1" = 800'

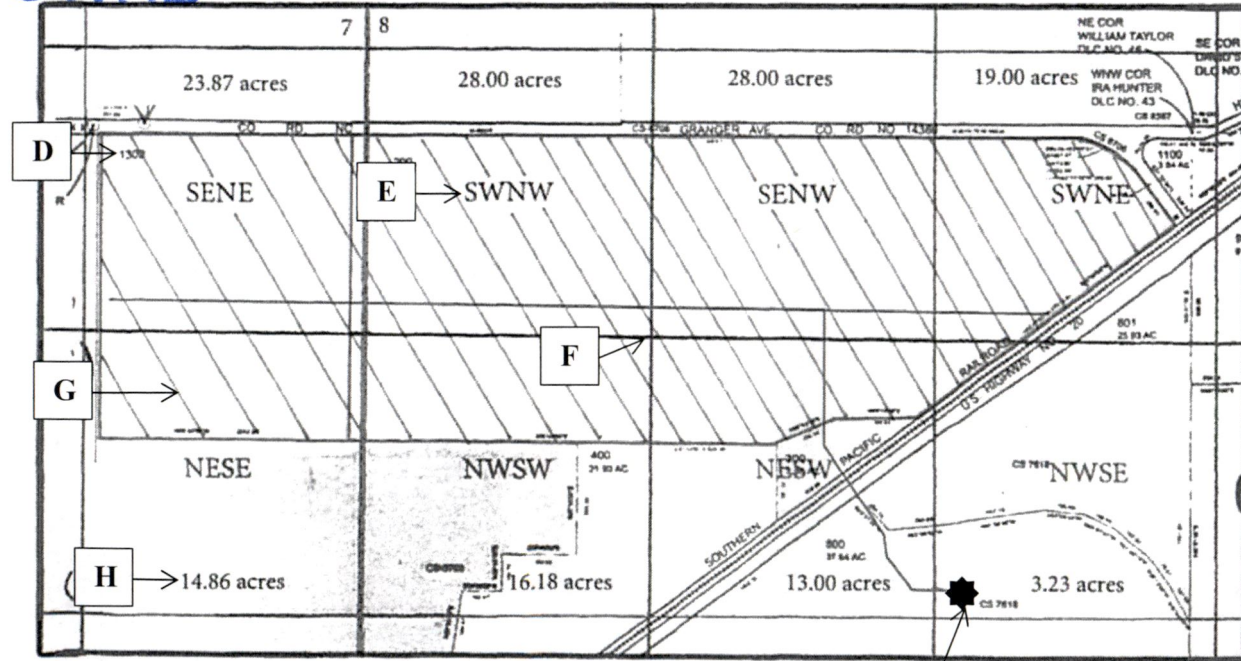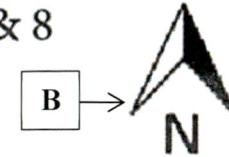

J → Proposed Well Located 1165 feet South and 161 feet East from the center of section 8

RECEIVED


APR 06 2018

OWRD

G-18649


Other Sample Maps

T.28S. R.7W. Section 1 Douglas County Scale: 1" = 1,320'

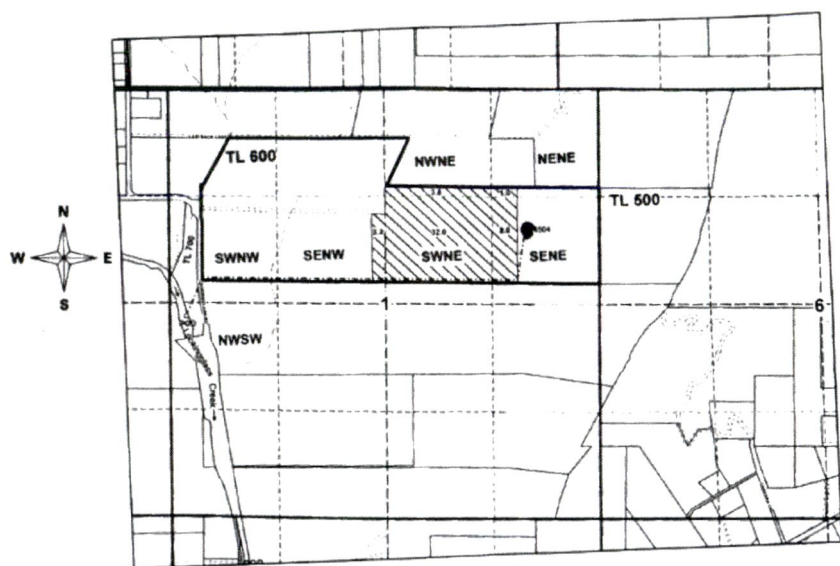

Point of Diversion is 2,720 ft. south and 180 ft. east from the northwest corner of Section 1.

T.7S. R.2W. Sec. 27 & 34, W.M.

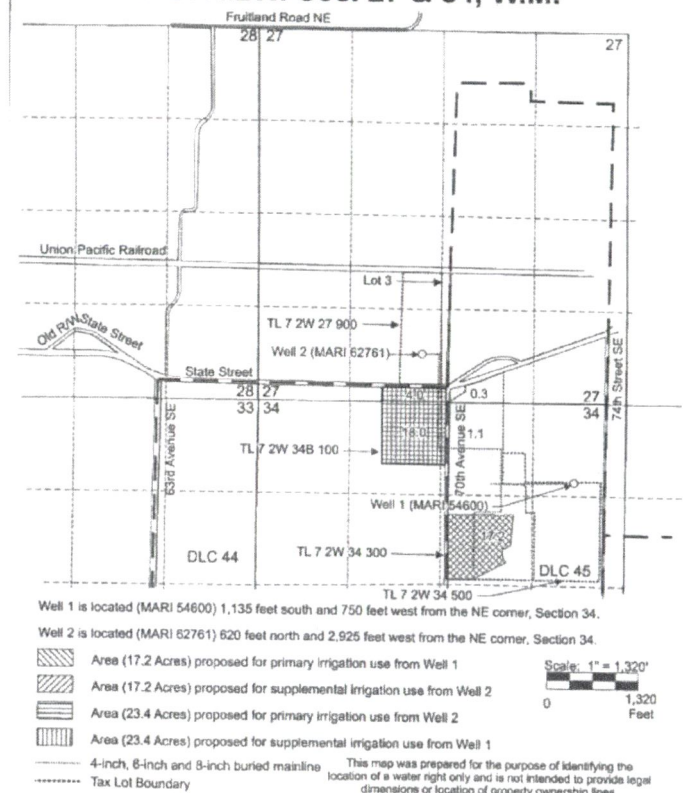



RECEIVED BY OWRD

Plan Map

Date: 3/30/2017

NOV 06 2017

SALEM, OR

Customer(s): Gurske Place

Tax Lot #: 201

District: LINN Soil & Water Conservation District

Legal Description: TWN: 12S, R: 3W Section: 9

33010 SEVEN MILE LN
TANGENT OR 97389

Field Office: TANGENT SERVICE CENTER


Agency: USDA - NRCS

Assisted By: WALLACE JENNINGS

APR 11 2018

Approximate Acres: 75

Land Units: Farm: 3009, Tract: 13859, Field: 1

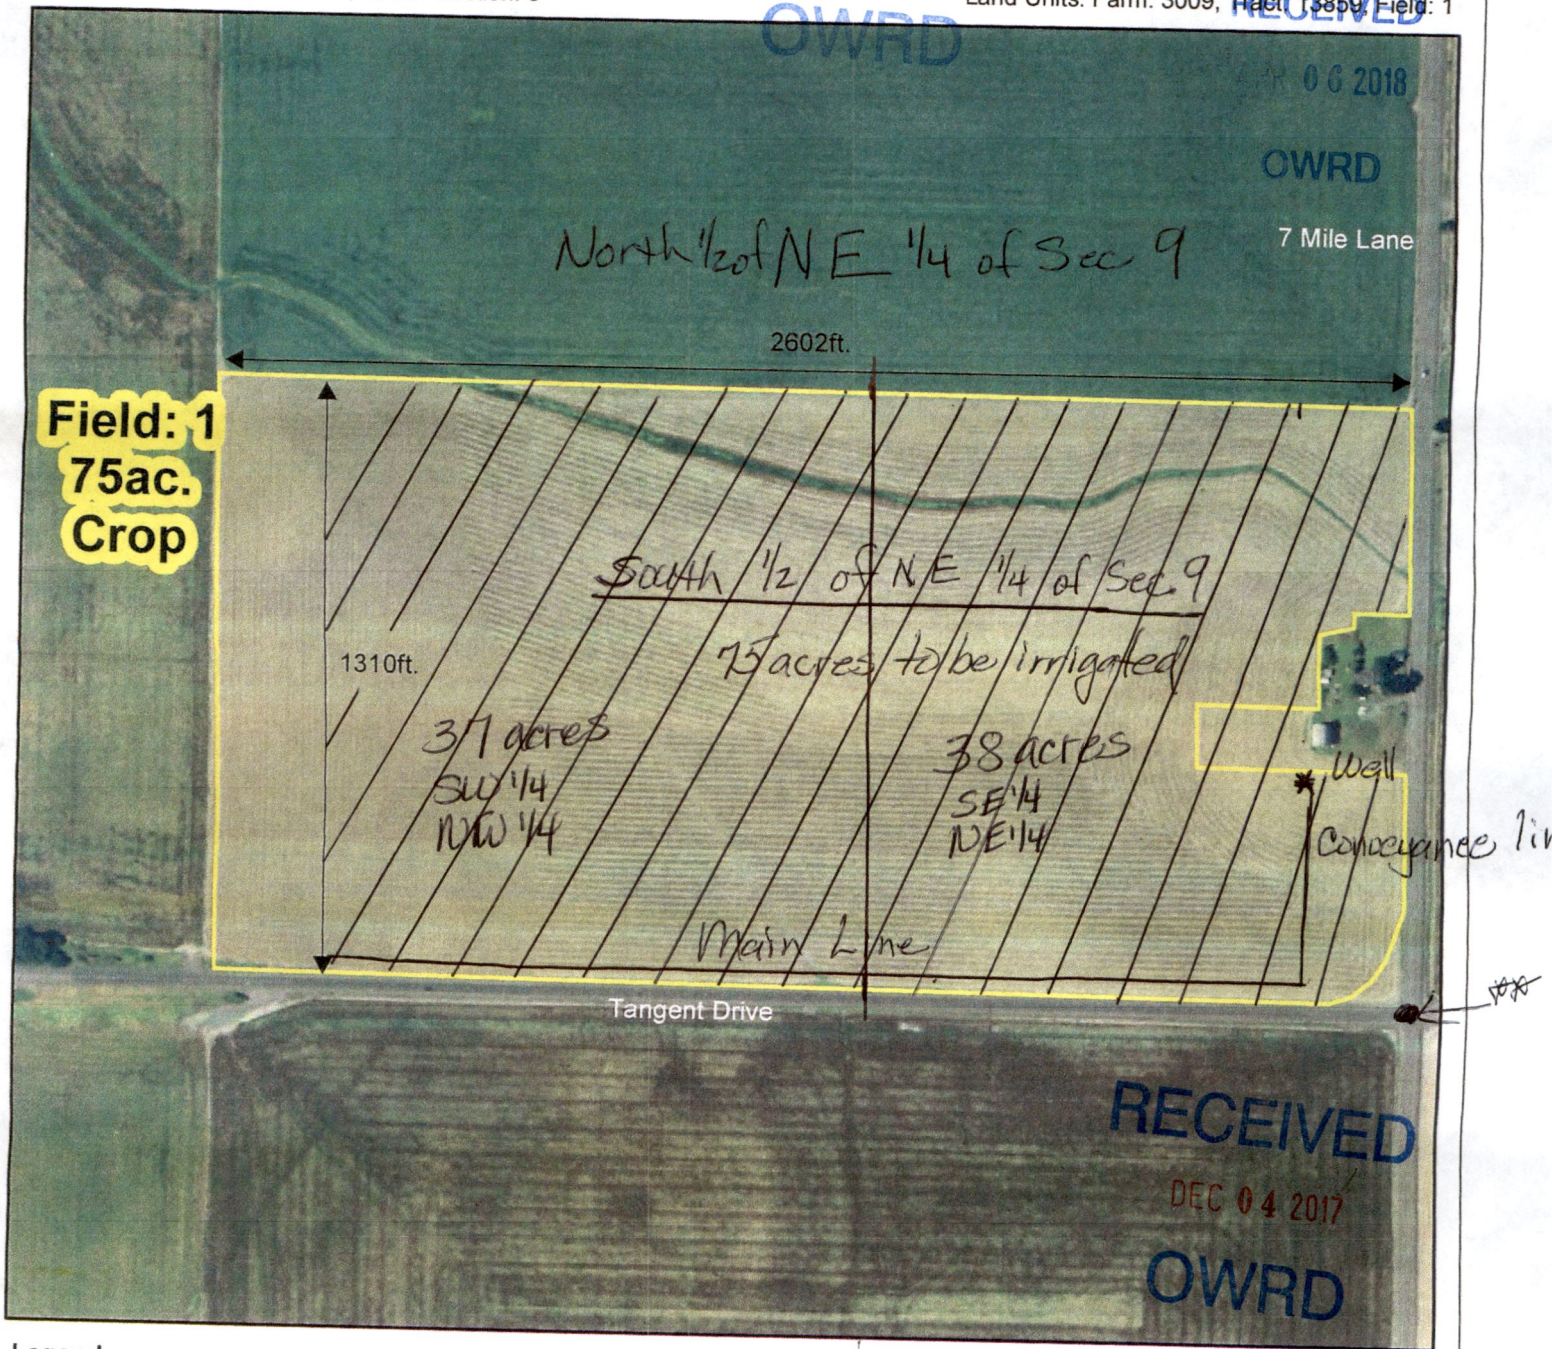

Legend

Consplan

240 0 240 480 720 960 Feet

N

- *Proposed well located 240' feet West and 780 feet North from the Public land survey reference corner.
- Number of acres to be irrigated is 75, all in same 1/4 Public land survey reference corner

G-18649