


Survey Map

T. 115 R. 4W
BENTON COUNTY

5 6
7

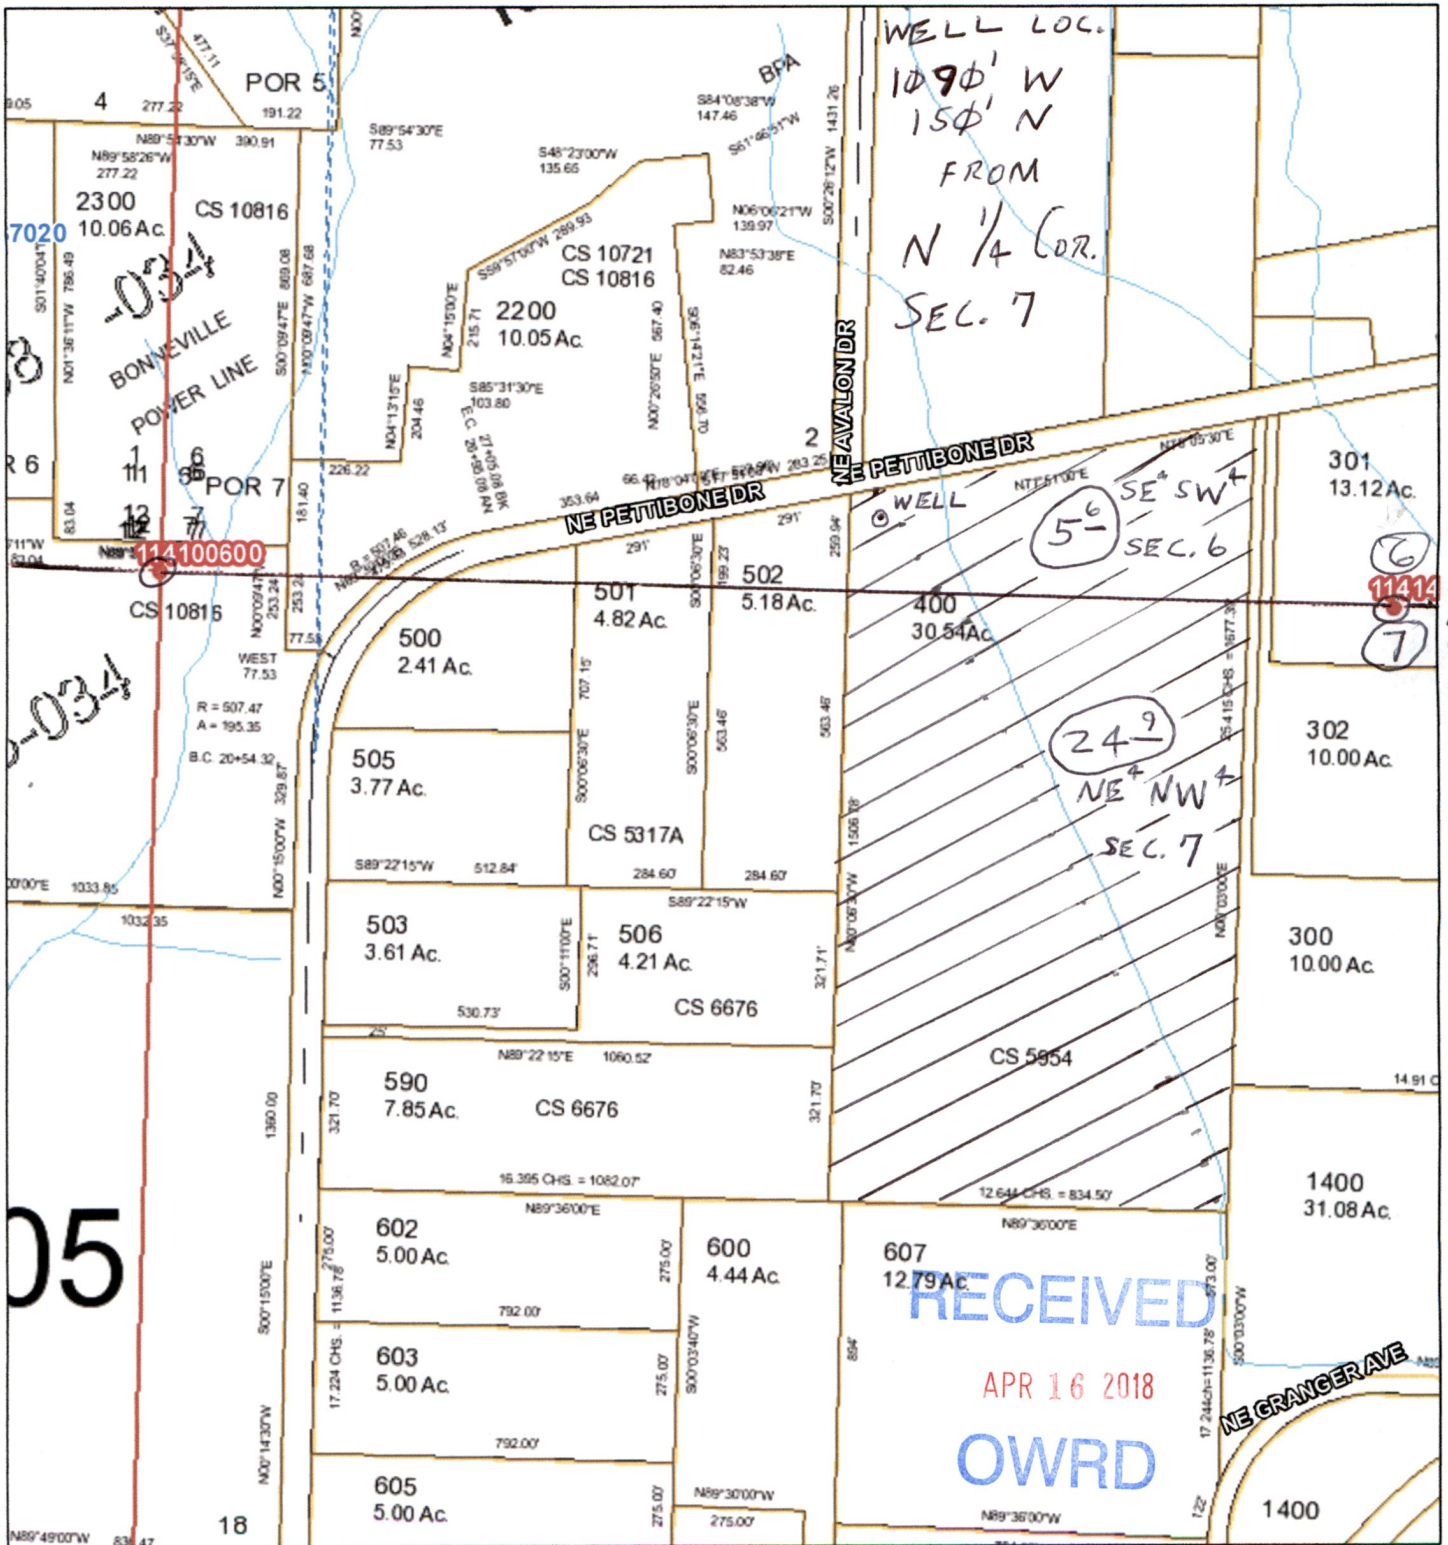

3/16/2018, 12:35:54 PM

1:4,800

1" = 400'

ArcGIS_Public.SDE.section_lines

SEC-LINE

TWP-LINE

TaxlotOwners

ArcGIS_Public.SDE.Roads

ArcGIS_Public.SDE.section_comer_index


Donation Land Claims

ArcGIS_Public.SDE.survey_index

Hydro_polys

Hydro_lines

Cities and Places

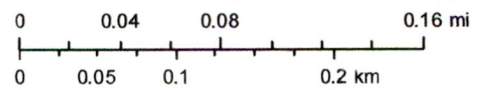

Benton County, Oregon
Benton County, Oregon - Assessor's Department

G-18652