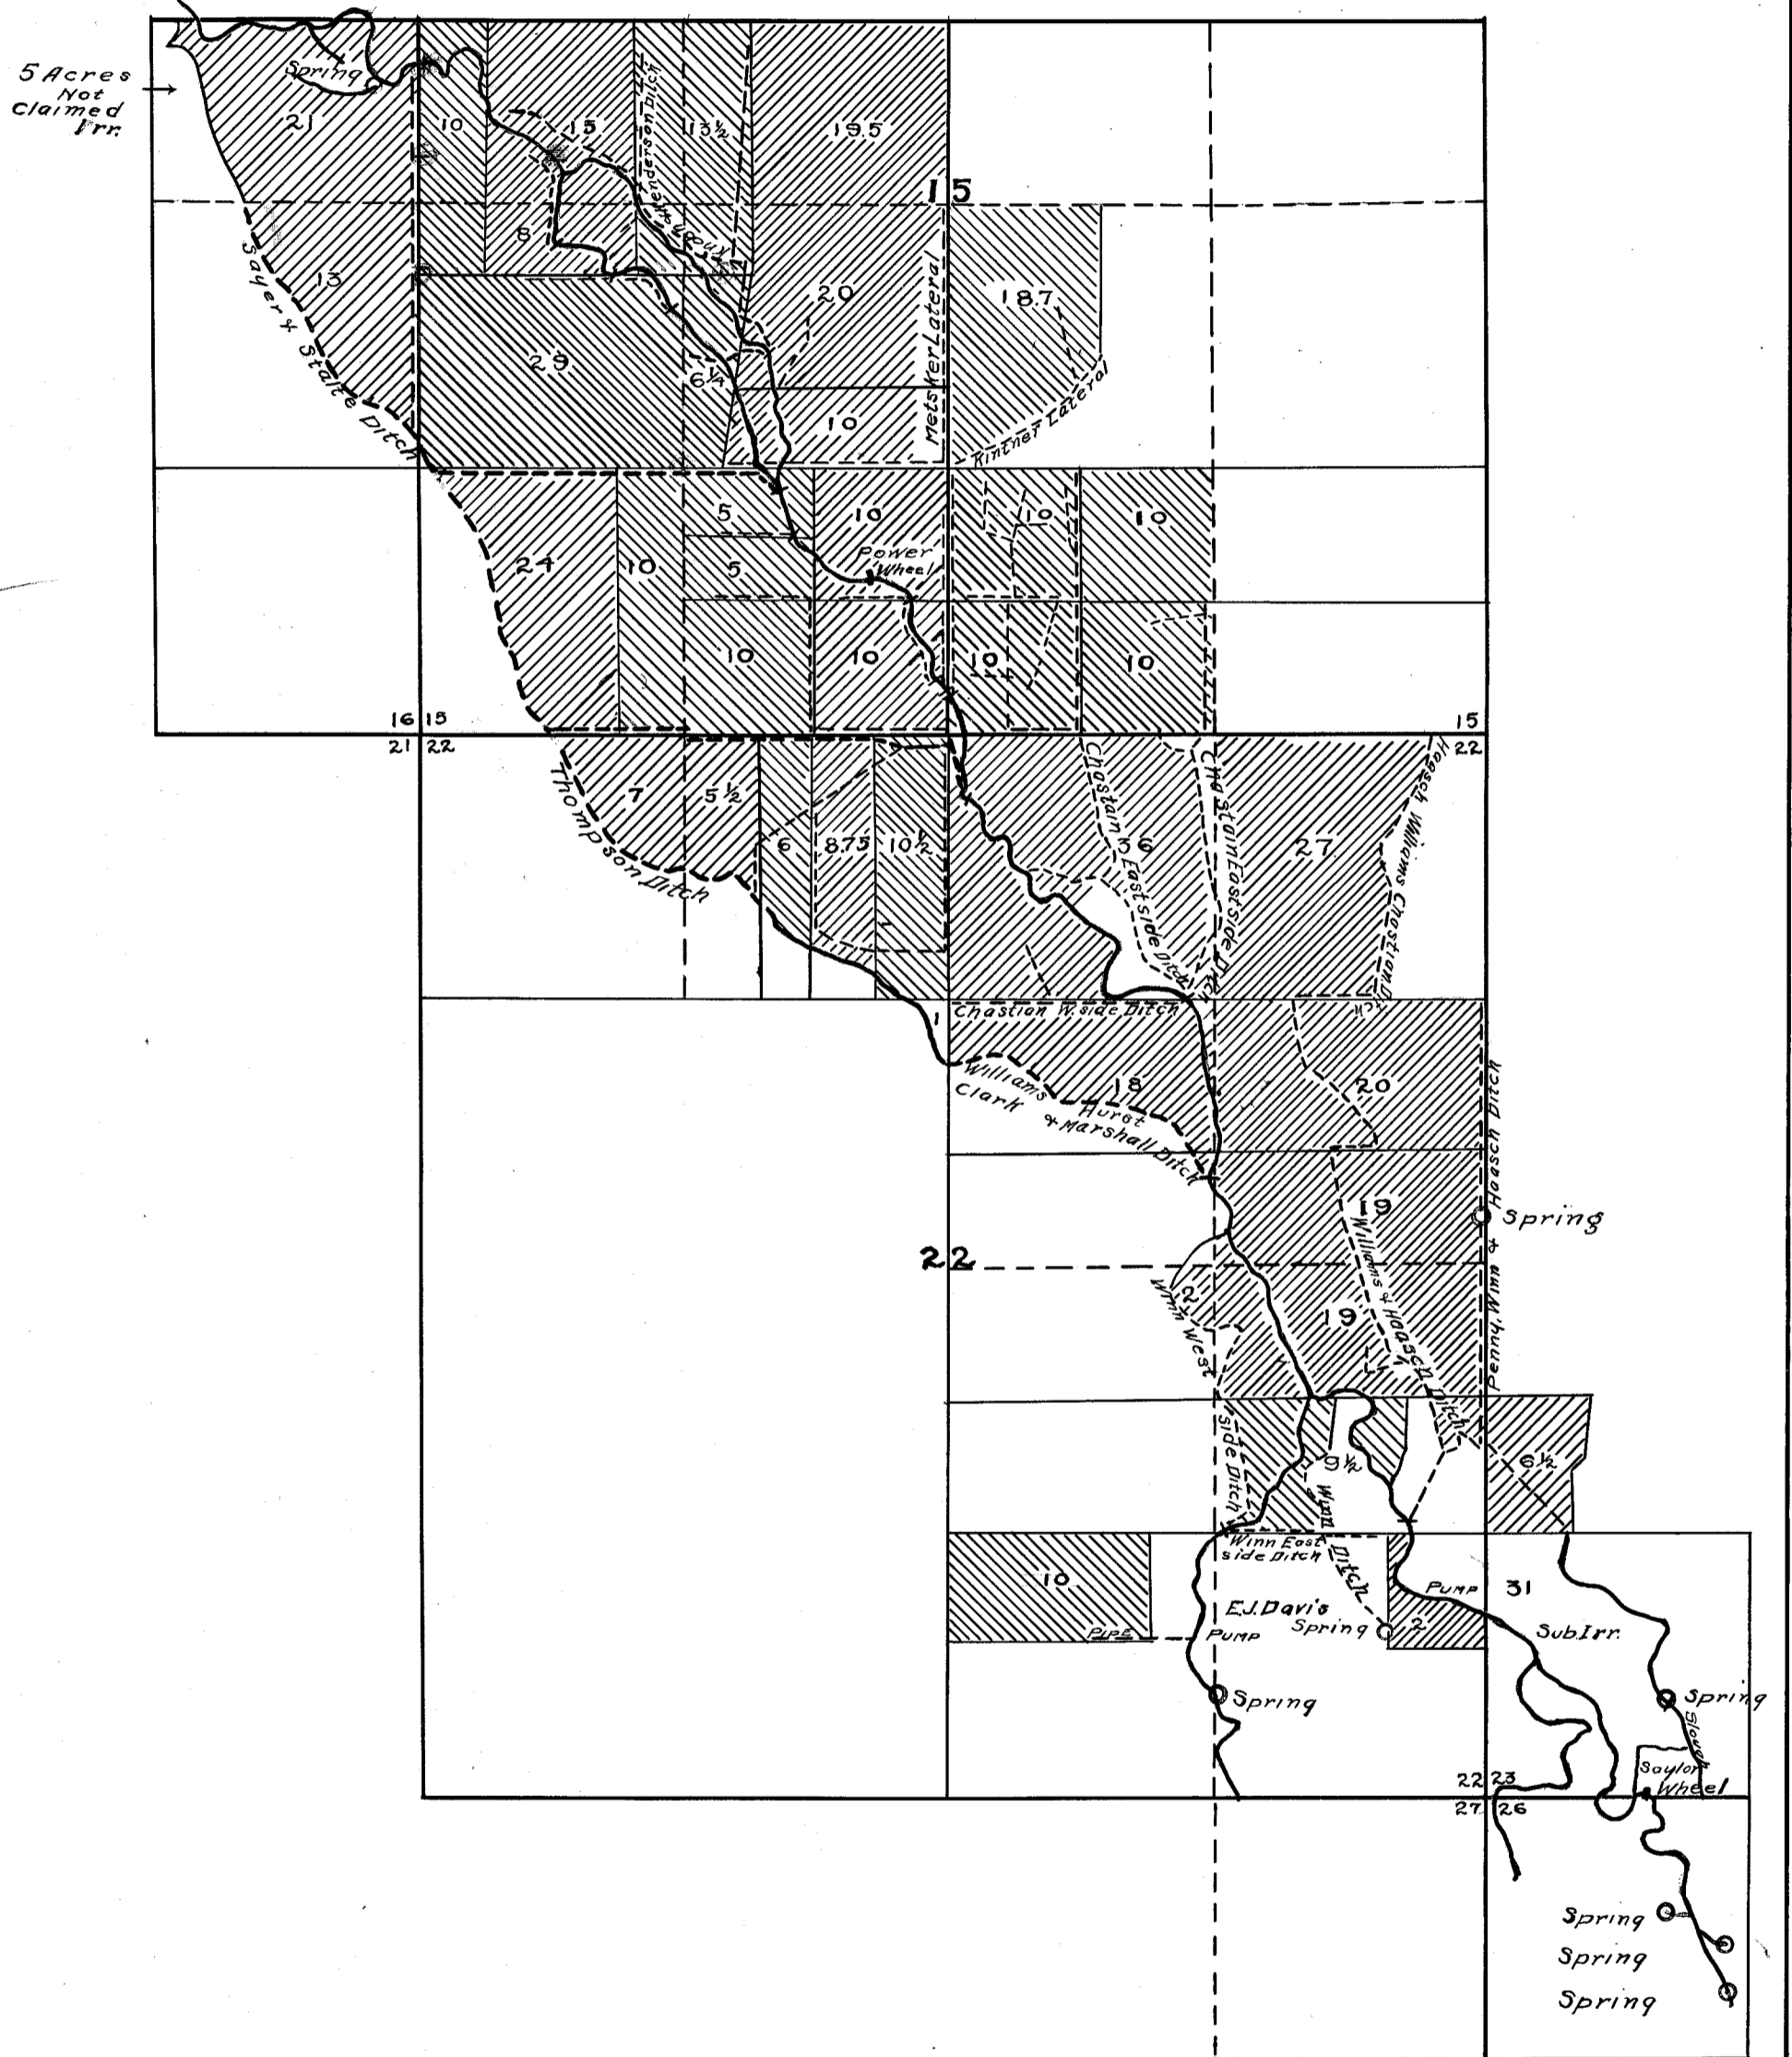

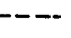




Township 6 N

Range 35 E



Adjudication Survey
of
West Prong of Little Walla Walla River
March 10-30 1915
Scale 1" = 880 ft.

- Legend**
-  Irrigated Lands
 -  Ditches
 -  Streams
 -  Springs