

T.14 S., R.31 E., W.M.,
section 1

APPLICATION MAP FOR

JESSE & NINA WAGNER


RECEIVED

JUN 29 1983

WATER RESOURCES DEPT.
SALEM, OREGON

Application No. 65241
Permit No. 47666

w $\frac{1}{2}$ cor

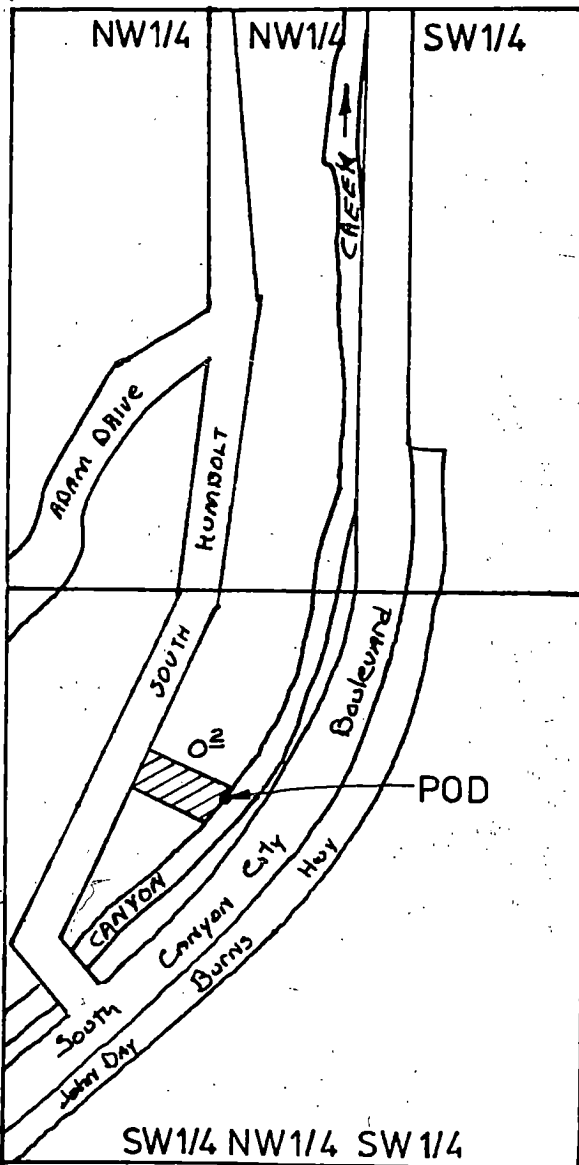

SCALE

1" = 220'

POD is 910 ft S & 250 ft
E of W $\frac{1}{4}$ cor Sec. 1,
T.14 S., R.31 E., WM

$\frac{1}{16}$ cor

Info: Patrick Gallegos same address Mr G. stated that, it was
in place when he brought the place in Sept 1985 He has not
changed anything.

Div. Pt. PUMPS DIRECTLY OUT OF CREEK
MOTOR & PUMP Century 1/2 HP @ 3450 RPM
1 1/2" x 1" CDD

PIPE: 1 1/2" 30' black plastic pipe
1/2" 150' garden hose

Heads: 3 garden sprinklers 3 max per Mr G. not much pressure
Veg garden, lawn

LIFT +10

TIE: INSP

6-18-88

V. J. [Signature] F.L.

$$\frac{6.6 \times .5}{127 + 10} = .025 \quad \text{PUMP.}$$

$$(3 \times 5) \div 450 = .03 \quad \text{SPRINK}$$

$$0.2 \times .025 = .005 \quad \text{ACRE}$$