


1" = 1320'

Tax Lot:

Township 3 South, Range 2 West, Section 7, Tax Lot 4900

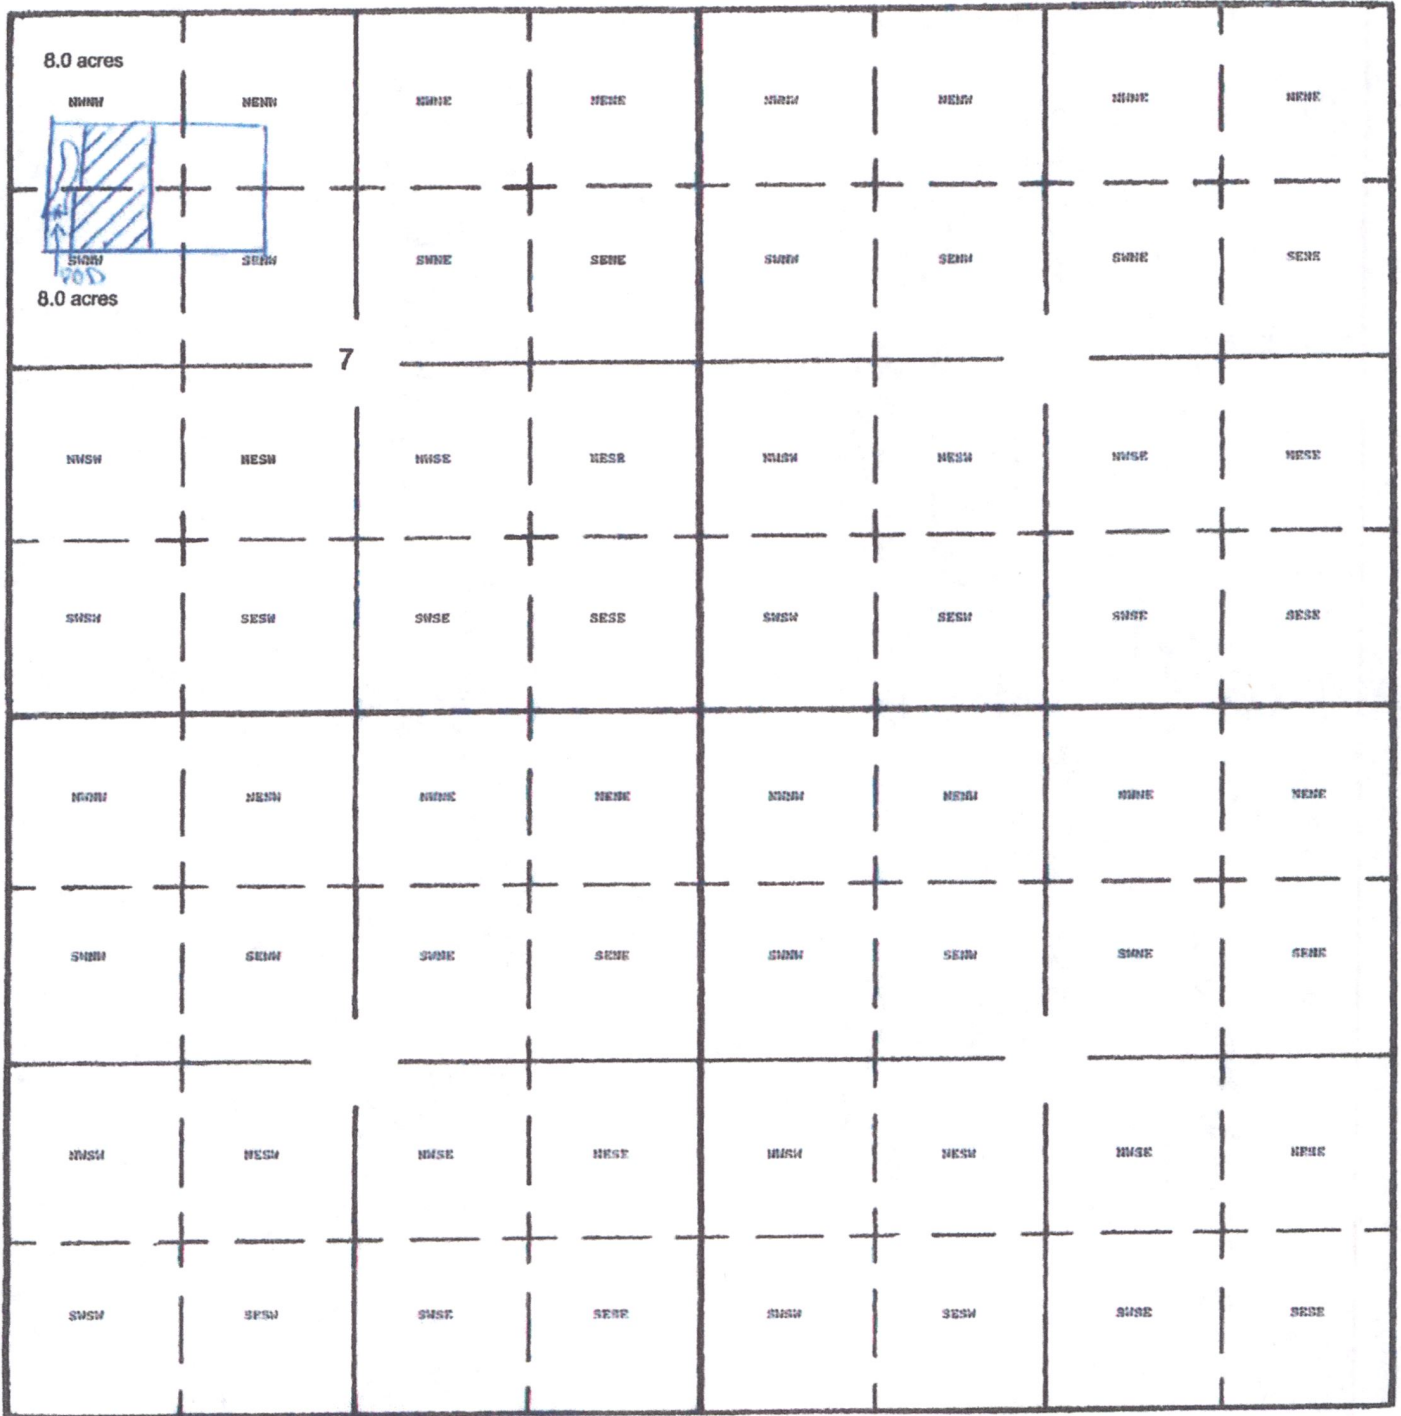

▲ POD: 1510' South and 370 East from NW Corner Section 7

RECEIVED

MAY 23 2018

*A Robbing*

5/4/18

OWRD

S-88584