
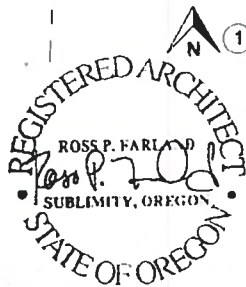


RECEIVED

AUG 08 2019

OWRD

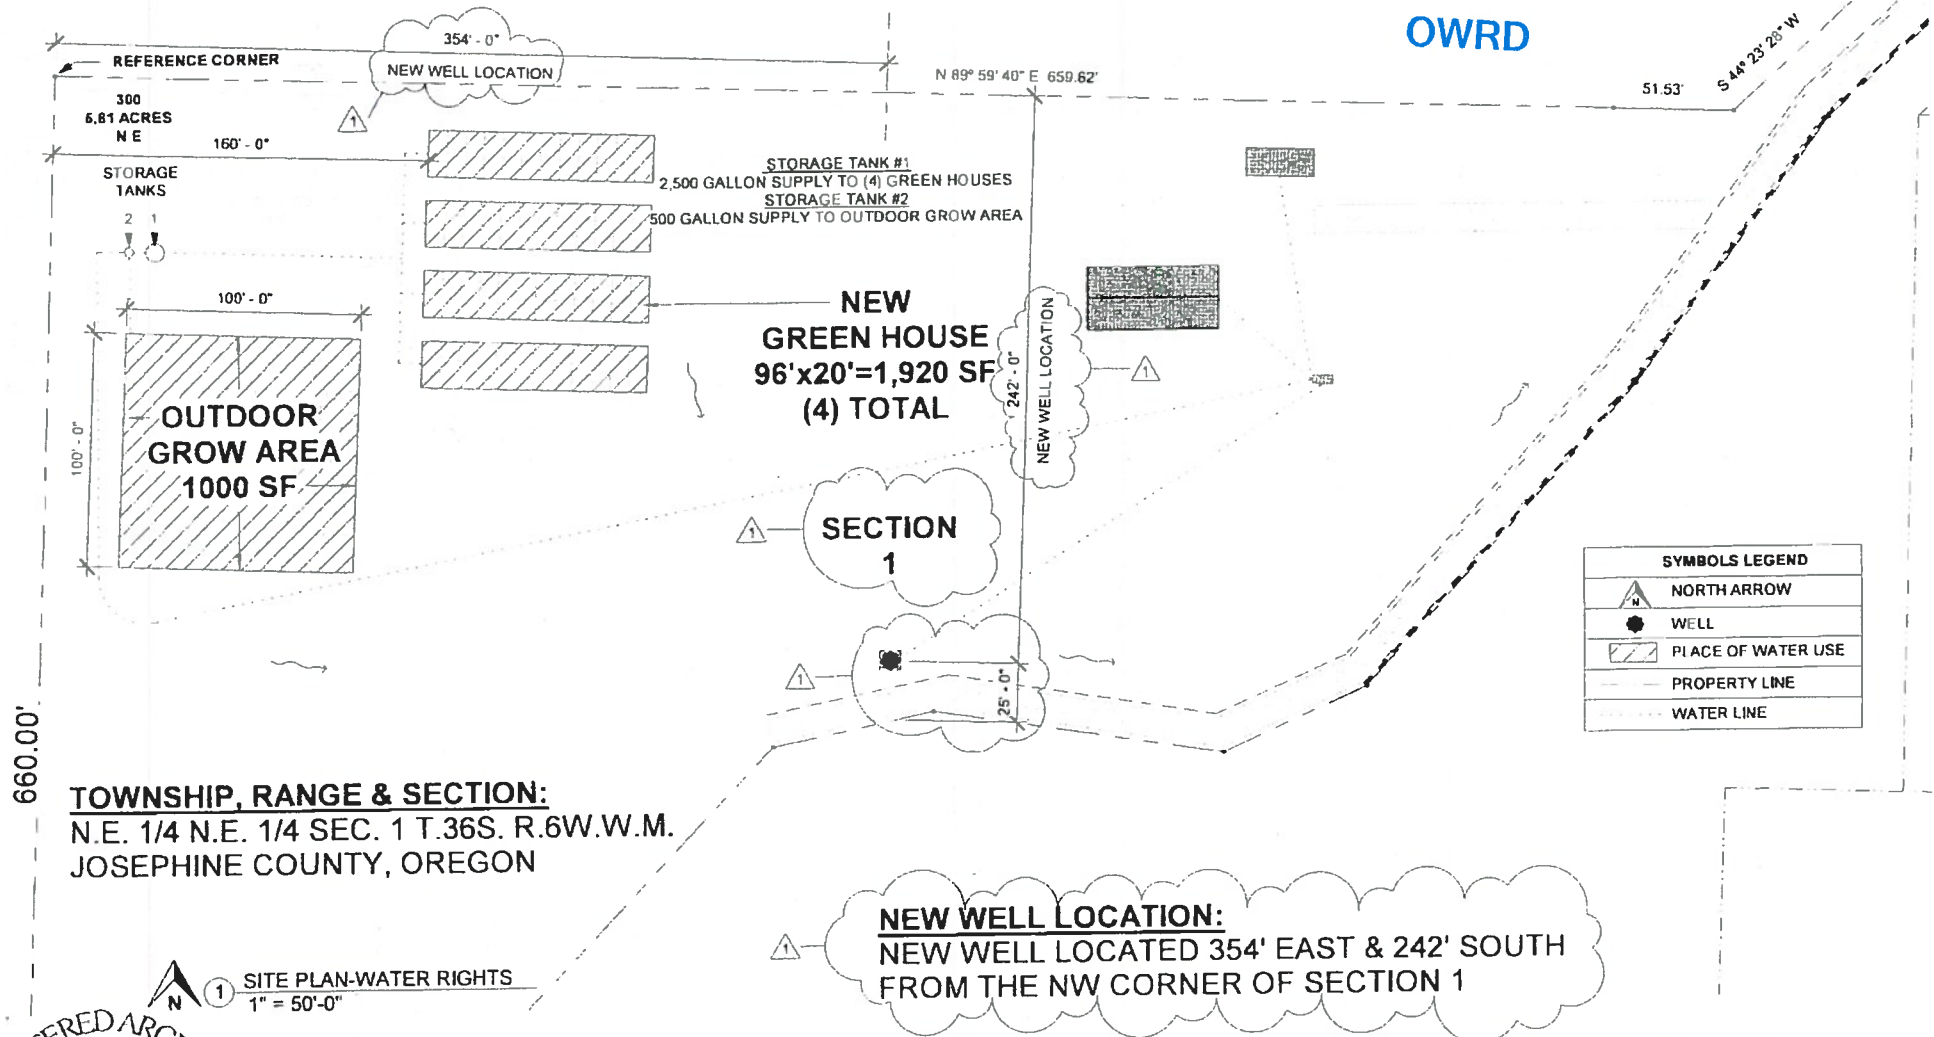

Ross P. Farland, AIA
3531 Drift Creek Rd. S.E.
Sublimity, Oregon
503-291-7160
ross@dezineworks.bi

JOSEPHINE COUNTY

TOBIN / JONES RESIDENCE

No.	Description	Date
1	NEW WELL REVISIONS	8/8/2019

SITE PLAN		WATER RIGHTS	
Project number	Project Number	S1.1	
Date	5/30/2018		
Drawn by	Rp		
Checked by	-		
		Scale 1" = 50'-0"	

8/8/2019 10:53:53 AM