

2017-17

Oregon Water Resources Department Water Rights Mapping Tool

Search

Search: TRS

Public Land Survey System

Meridian: WM

Township: 14 N S

Range: 2 W E

Section: 4 (optional)

(Draw box on map.)

Description: WM14S2W4

RECEIVED

JUN 04 2018

OWRD

Identify Non-Water Right Features

Tax Lots

Layers

Tools

POD

POU


Home | Mail: 725 Summer St NE, Sale | Return | Contact Us



USDA FSA Aerial Photo

36420 Hwy 228


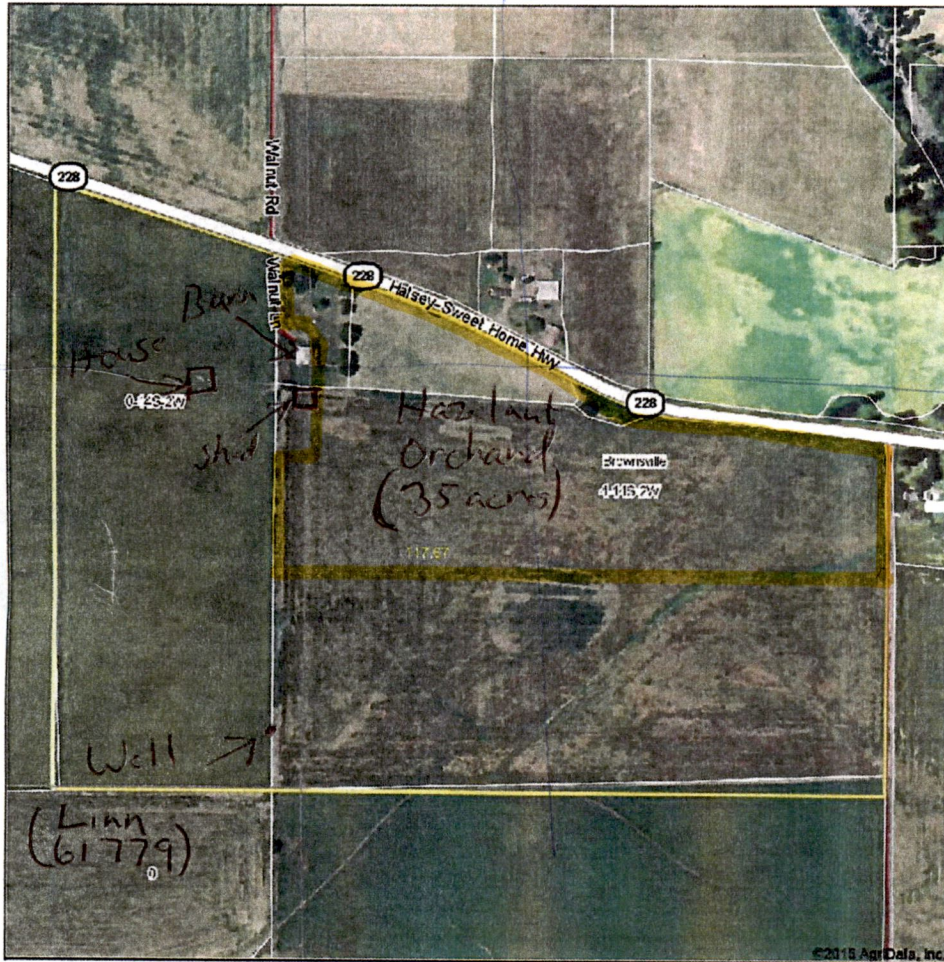

RECEIVED

JUN 04 2018

OWRD