

62588-J



5

30

Reg. Co. Rd. No. 912

WITHEGOMB

Co. Rd. No. 912

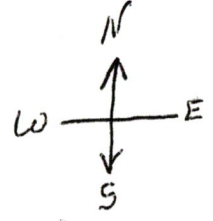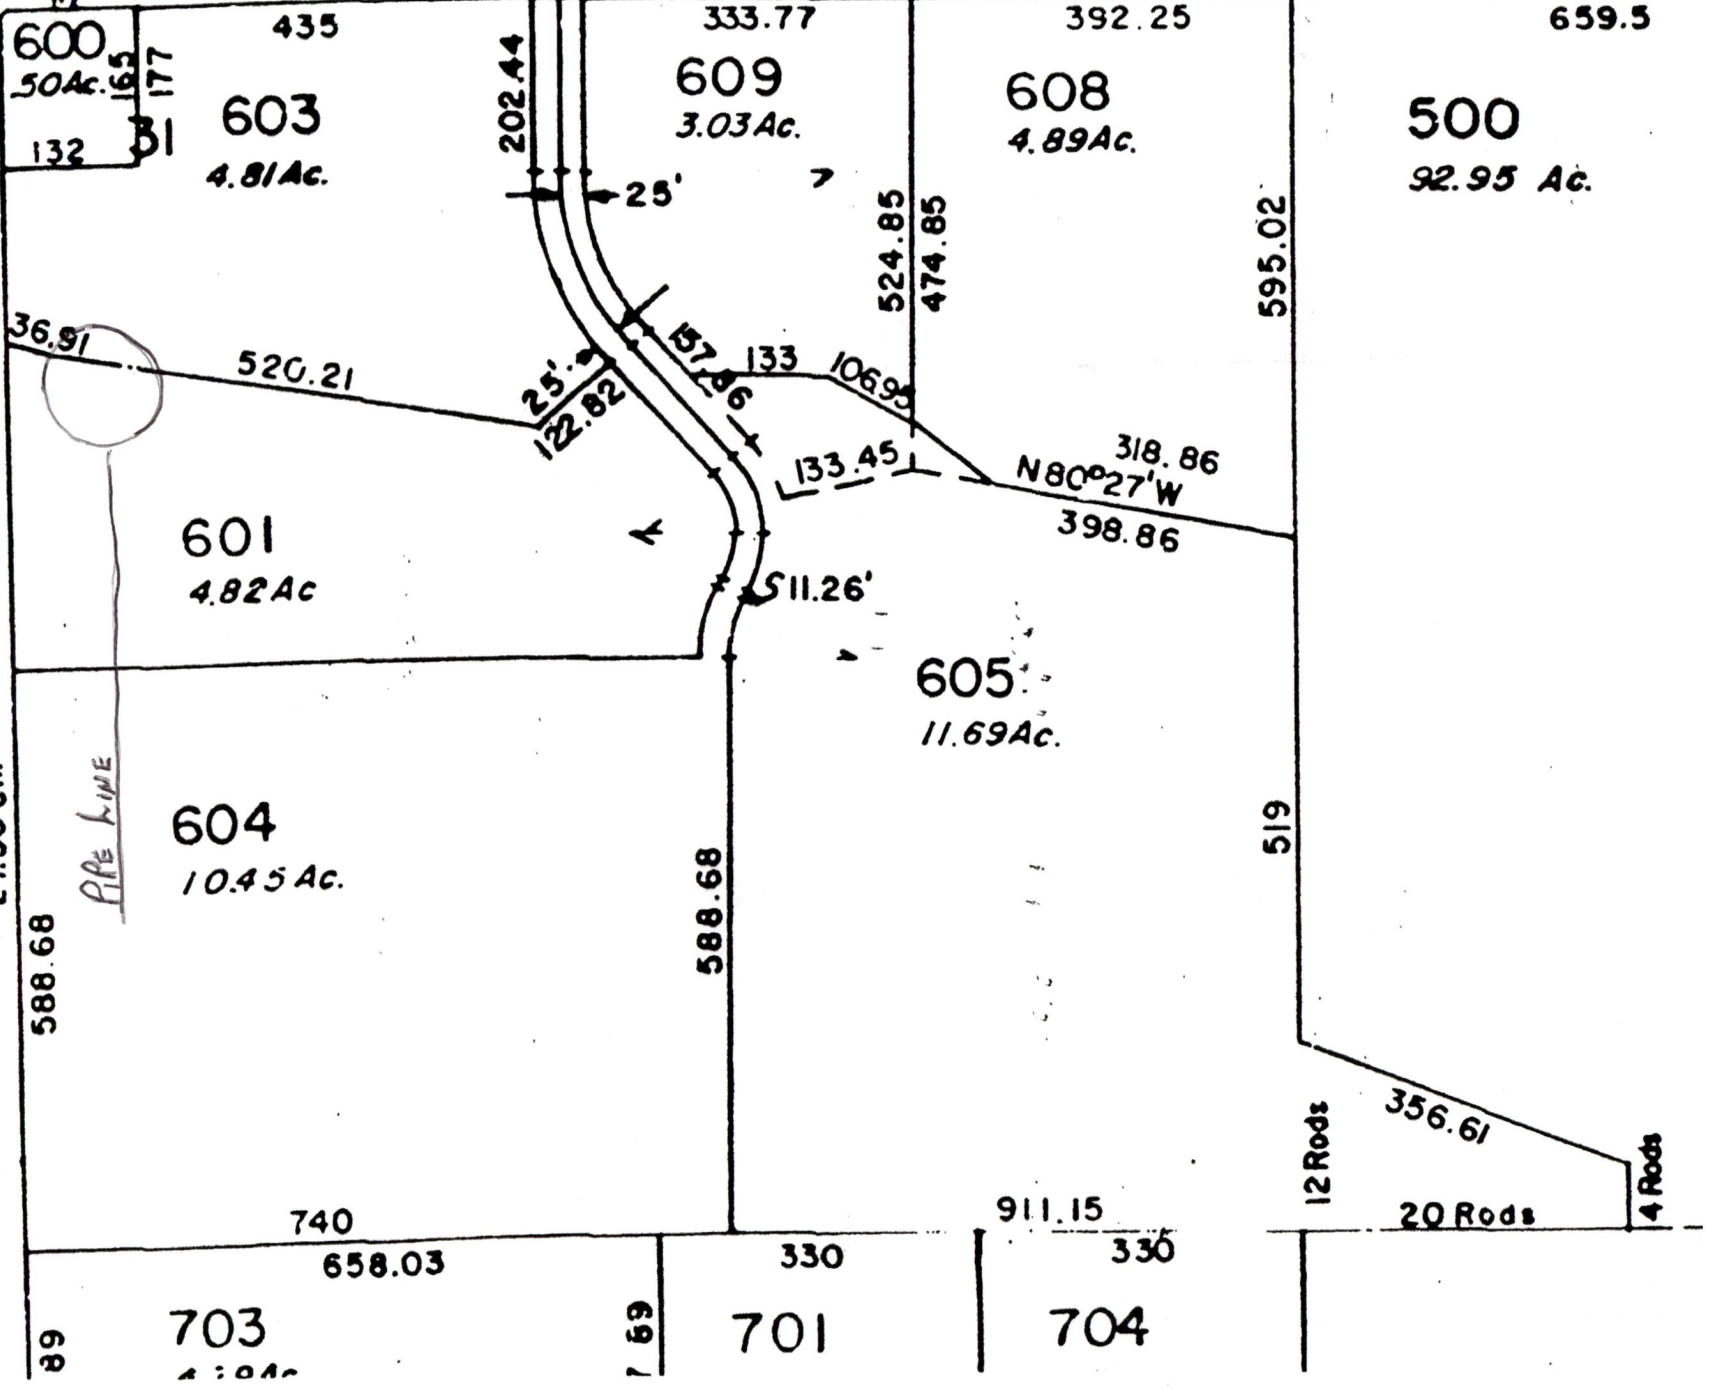

RECEIVED  
 JUN 11 2018  
 OWRD  
 36  
 AAP

RECEIVED  
 JUN 11 2018  
 OWRD

1" = 1320'

Tax Lot: 604



POD location = 550' south and 40' east of the northwest corner of section 31, 153W

▨ = reservoir

x = POD

▣ = POLL

S-88588

RECEIVED

JUN 11 2018

OWRD